



ABELL
SURVEYING & MAPPING
DELAVAN, WISCONSIN 53115
414-728-6737

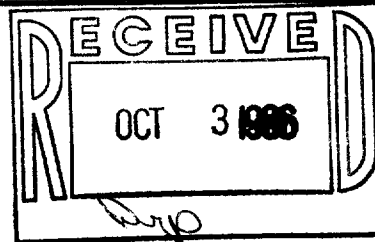

WASHINGTON

STREET

WISCONSIN
ST.

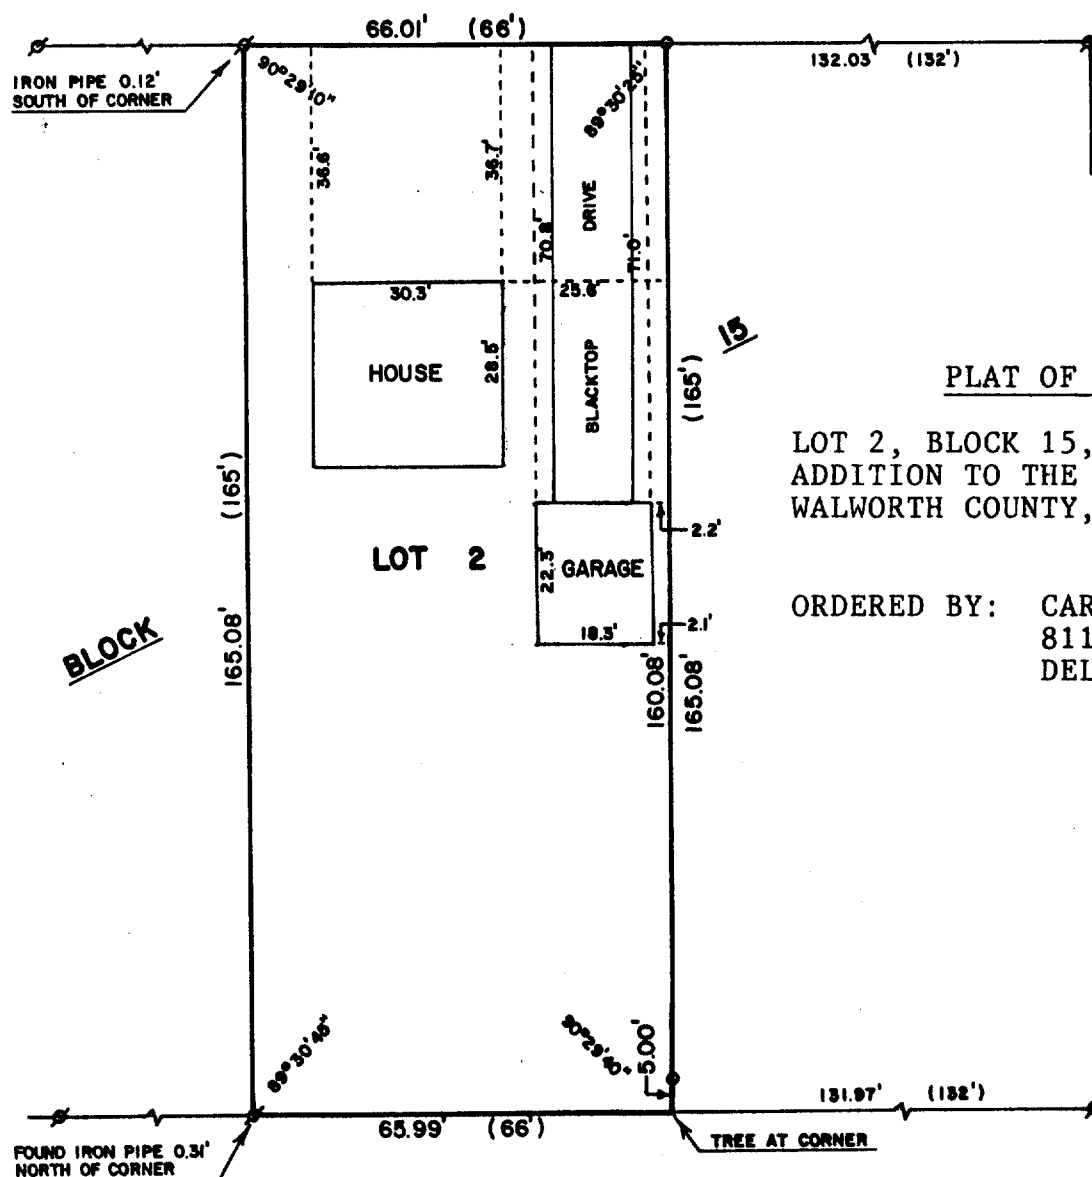

PLAT OF SURVEY OF

LOT 2, BLOCK 15, STONE & TOPPING
ADDITION TO THE VILLAGE OF DARIEN,
WALWORTH COUNTY, WISCONSIN.

ORDERED BY: CARMIN REALTORS
811 E. GENEVA ST.
DELAVAN, WI 53115



SCALE - 1"=30'

LEGEND

- ⌀ - IRON PIPE FOUND
- - 3/4" DIA. IRON ROD SET
- () - RECORDED AS

I, DAVID F. ABELL, DO HEREBY CERTIFY
THAT I HAVE SURVEYED THE PROPERTY
HEREON DESCRIBED ACCORDING TO THE
OFFICIAL RECORDS, AND THAT THE PLAT
HEREON IS A CORRECT REPRESENTATION
OF THE PROPERTY LINES TO THE BEST OF
MY KNOWLEDGE AND BELIEF.

David F. Abell

DAVID F. ABELL
WISCONSIN REGISTERED LAND SURVEYOR, S-1596

DATE *Sept. 8, 1986* JOB NUMBER - 86044