


DUNHAM SURVEYING, S. C.
SURVEYING & SUBDIVIDING
DELAVAN, WISCONSIN 53115

N

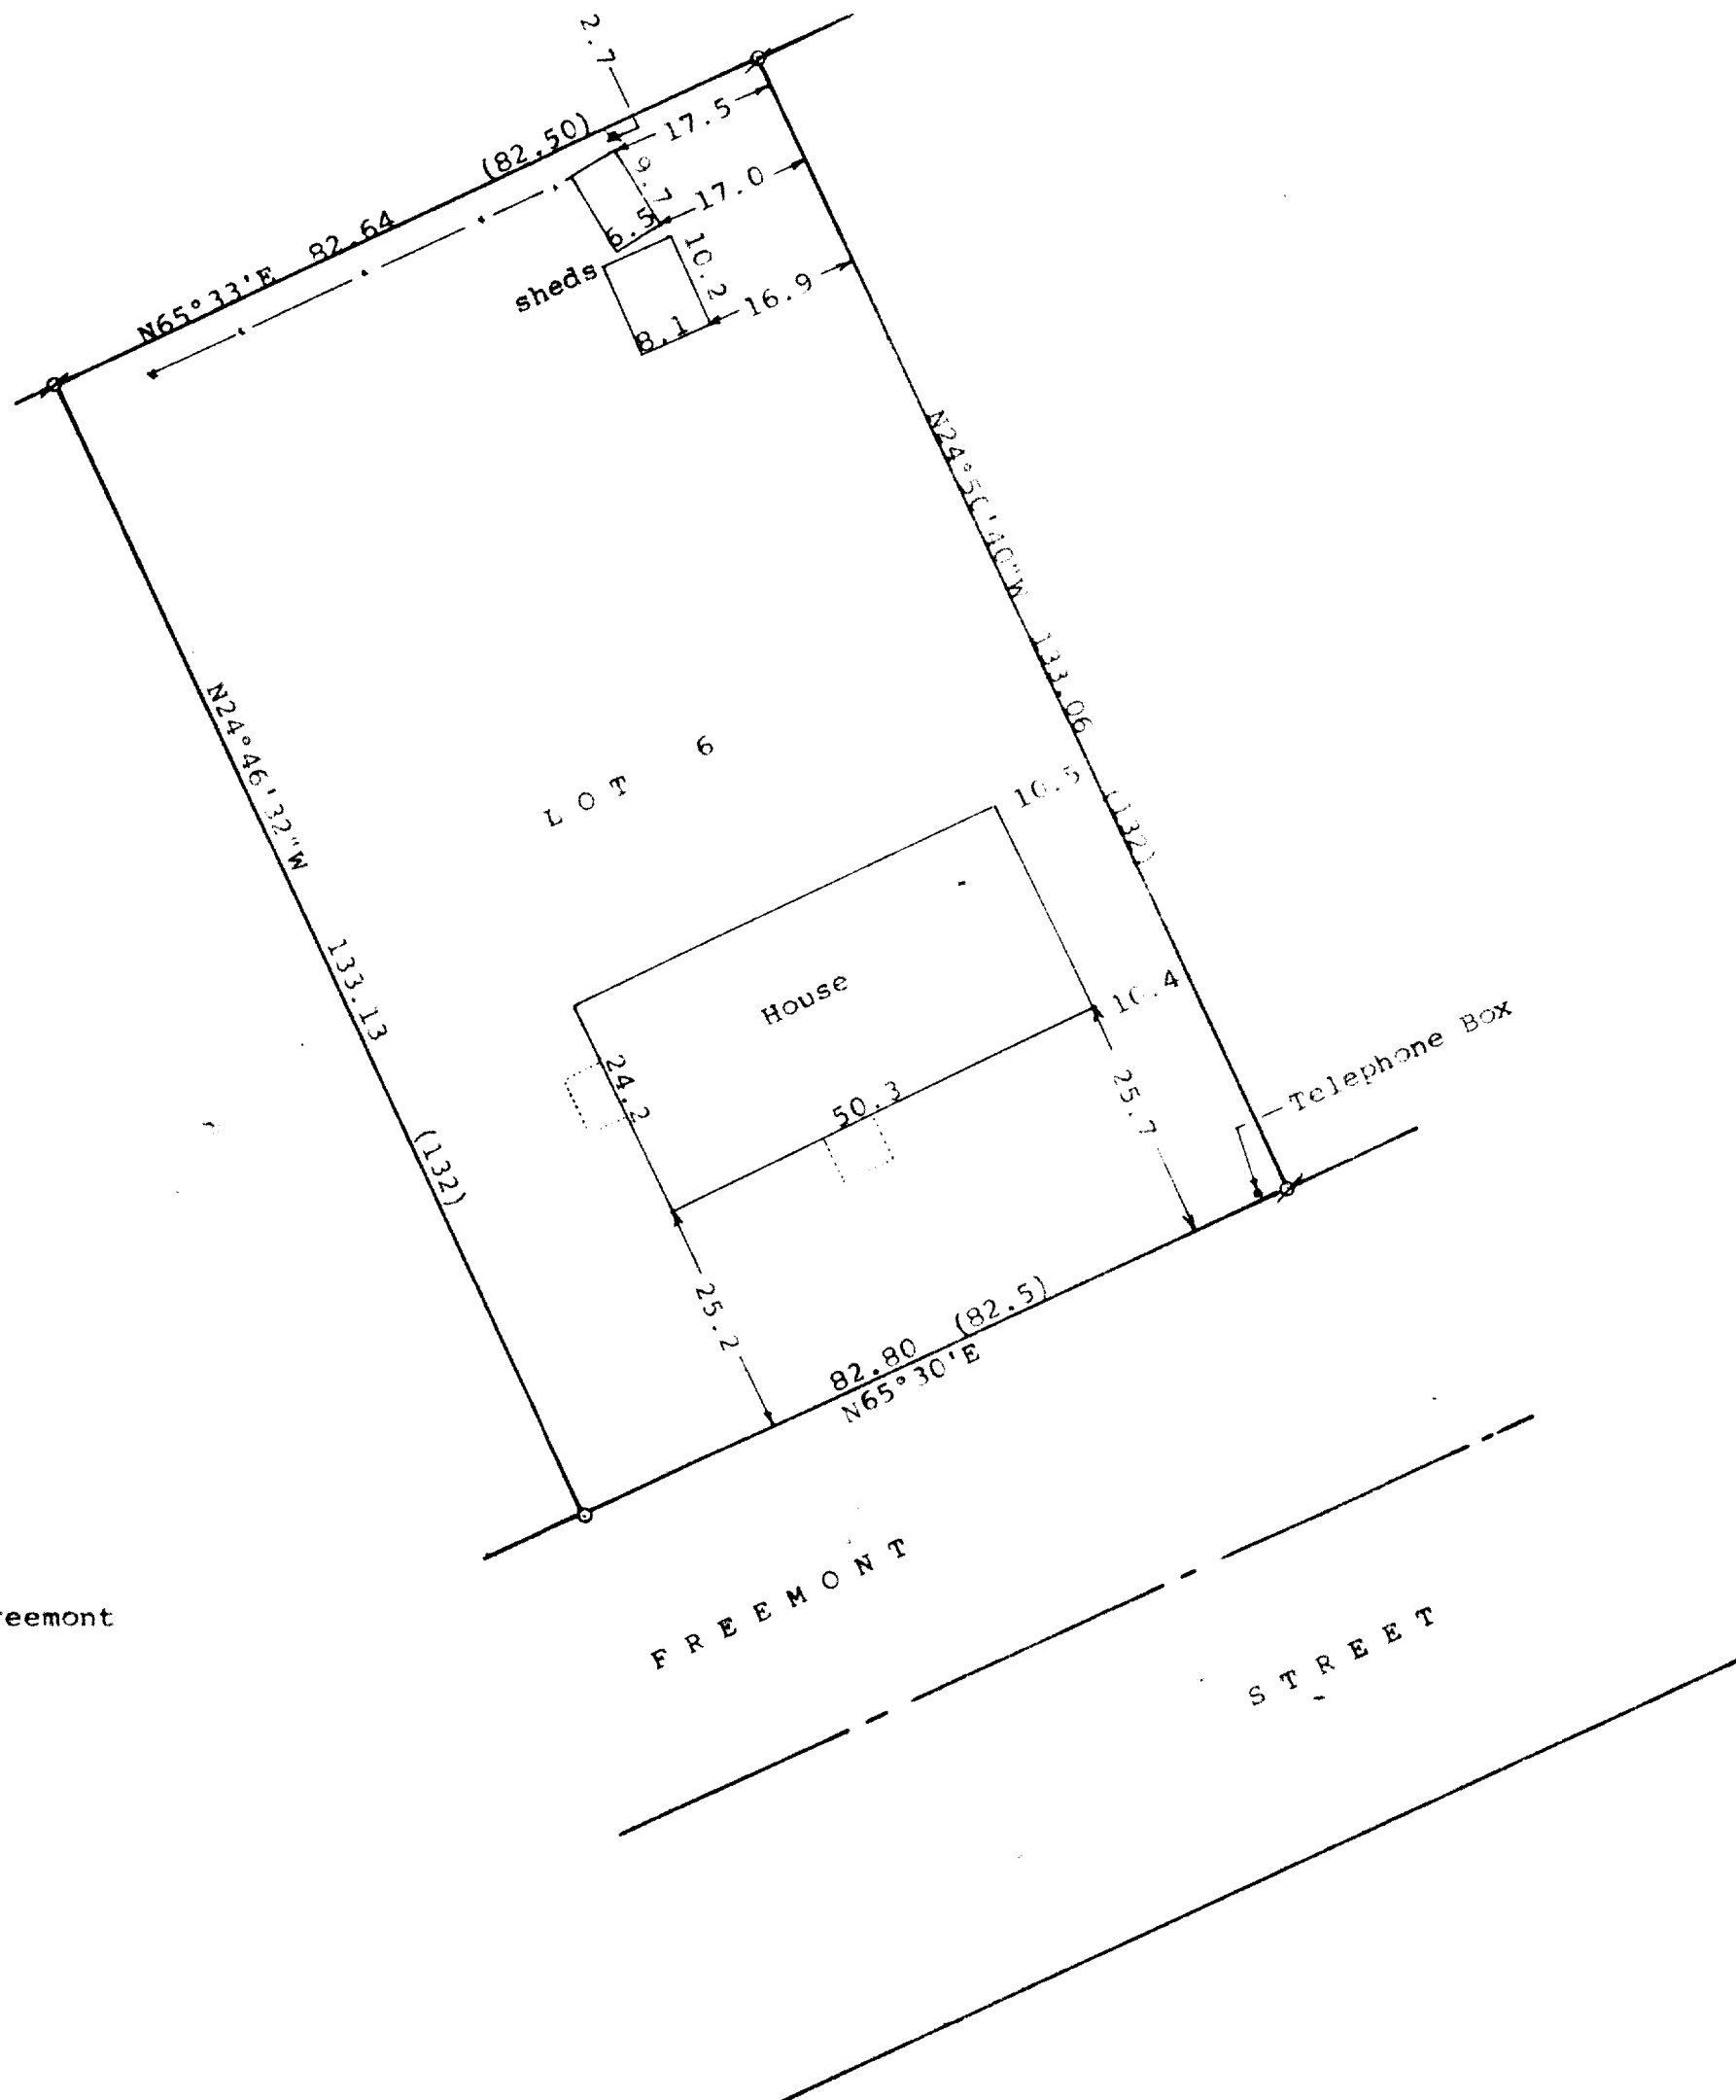

Scale - 1" = 20'

Ø = 3/4" Iron Pipe Found

○ = 1 1/4" Iron Pipe Found

--- = Fence Line

Bearings referenced to the northerly line of Freemont

Street with the assumed bearing of N65°30'E

Survey ordered by: Danielson & Osman Realty

23 North Wisconsin Street

Darien, WI 53114

(0.00) = recorded distance

STATE OF WISCONSIN) SS
COUNTY OF WALWORTH)



I, George T. Dunham, Surveyor, certify that I have surveyed the property described as follows:

Lot 6 in Block 23 of John Bruces Addition to the Village of Darien, Walworth County, Wisconsin

and that the plat shown hereon is a correct representation thereof and shows the size and location of the property, its exterior boundaries, the location of all visible structures and dimensions of all principal buildings thereon, boundary fences, apparent easements, roadways and visible encroachments, if any, and that I have surveyed the property hereon described, according to the official records, to the best of my knowledge and belief.

March 29, 1994

George T. Dunham
George T. Dunham, Surveyor

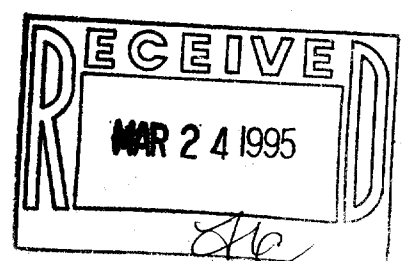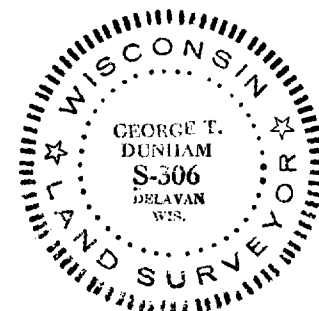

QBA-38

001-298