

DUNHAM SURVEYING, S.C.
SURVEYING & SUBDIVIDING
DELAVER, WISCONSIN 53115

N

JACKSON
STREET

THIRD
AVENUE

Scale - 1" = 20'

Ø = 1" Iron Pipe Found

Ø = 1½" Iron Pipe Found

Ø = ¾" Iron Pipe Found

Ø = ¾" Iron Pipe Set

Ø = 1½" Iron Pipe Set

Ø = spike found - ¾" Iron Pipe Set

(0.00) = recorded distance

Bearings referenced to the northwesterly line of Oak
Street with the assumed bearing of N61°55'E

Survey ordered by: Century 21, Skandia Realty

312 South 7th Street

Delavan, WI 53115

Ø = ¾" Iron Pipe Set

STATE OF WISCONSIN) SS
COUNTY OF WALWORTH)



I, George T. Dunham, Surveyor, certify that I have surveyed
the property described as follows:

The easterly 66.00 feet of Lots 1 & 7 in Block 1 of the
Original Plat of the Village of Darien, Walworth County,
Wisconsin

and that the plat shown hereon is a correct representation thereof
and shows the size and location of the property, its exterior
boundaries, the location of all visible structures and dimensions
of all principal buildings thereon, boundary fences, apparent easements,
roadways and visible encroachments, if any, and that I have surveyed
the property hereon described, according to the official records, to
the best of my knowledge and belief.

July 13, 1994

George T. Dunham, Surveyor

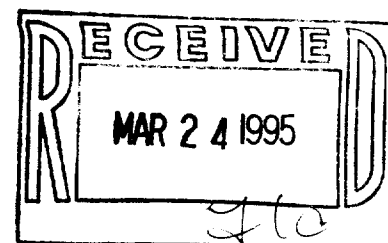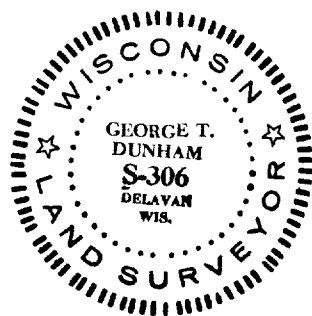

QOP-2.

QOP-11-

001-307