

NOTE: BEARINGS ARE REFERENCED TO THE
RECORDED SUBDIVISION PLAT.

ABELL
SURVEYING & MAPPING
1140 SEQUOIA STREET • DELAVAN, WISCONSIN 53115
262-728-6737

N



SCALE 1"=20'

LEGEND

- ⊗ - IRON PIPE FOUND
- - CONCRETE MONUMENT FOUND
WITH TOP BROKEN OFF
- △ - UTILITY POLE
- - GUY WIRE
- () - RECORDED AS

PLAT OF SURVEY OF

LOT 6, BLOCK 2, FINSTER'S ADDITION TO THE
VILLAGE OF DARIEN, WALWORTH COUNTY, WISCONSIN.

I HEREBY CERTIFY THAT I HAVE SURVEYED THE ABOVE DESCRIBED PROPERTY AND THAT THE
ABOVE MAP IS A TRUE REPRESENTATION THEREOF AND SHOWS THE SIZE AND LOCATION OF
THE PROPERTY, ITS EXTERIOR BOUNDARIES, THE LOCATION OF ALL VISIBLE STRUCTURES
AND DIMENSIONS OF ALL PRINCIPAL BUILDINGS THEREON, BOUNDARY FENCES, APPARENT
EASEMENTS, ROADWAYS AND VISIBLE ENCROACHMENTS, IF ANY, TO THE BEST OF MY
KNOWLEDGE AND BELIEF.

THIS SURVEY IS MADE FOR THE USE OF THE PRESENT OWNERS OF THE PROPERTY, AND ALSO
THOSE WHO PURCHASE, MORTGAGE, OR GUARANTEE THE TITLE THERETO WITHIN ONE (1) YEAR
FROM DATE HEREON.

David F. Abell

DAVID F. ABELL
WISCONSIN REGISTERED LAND SURVEYOR, S-1596


October 15, 2002

DATE: _____ JOB NUMBER - 02141
NOTE: THIS IS NOT A CERTIFIED COPY UNLESS SEALED.

W. MADISON STREET

66 FEET WIDE

(WEST) 132'
S 89°56'39" E 131.88'

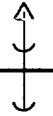

2

66 FEET WIDE

WISCONSIN STREET


LOT 6

AREA 0.15 ACRES

BLOCK

50.08'
50.08'
N 0°55'50" E
N 0°49' E
50'

LOT

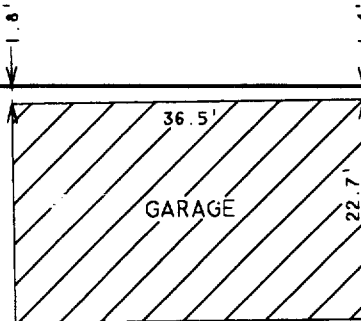

S 89°55'08" W 132.11'
(EAST) 132'

TAX PARCEL QVD-29

ORDERED BY: JOSH HORTON
1407 WHISPERING PINES DRIVE
DELAVAN, WI 53115

RECEIVED

NOV 12 2002

DA

QFA-14

001-442