

ABELL  
SURVEYING & MAPPING

1140 SEQUOIA STREET • DELAVAN, WISCONSIN 53115  
262-726-6737

BELOIT STREET

(N 60°25' E 129.84')  
N 60°25'22" E

129.78'

33.00'

124.00' (124.05')

LOT 2

NOTE: THIS PLAT REPRESENTS A BOUNDARY  
SURVEY ONLY AT THE DIRECTION OF:  
LEE SATHER & ASSOCIATES

LOT 1  
0.67 ACRES

CERTIFIED SURVEY

NO. 1986

PLAT OF SURVEY OF

LOT 1, CERTIFIED SURVEY NO. 1986, LOCATED  
IN THE EAST 1/2 OF SECTION 27, T2N, R15E,  
VILLAGE OF DARIEN, WALWORTH COUNTY, WISCONSIN.

ORDERED BY: LEE SATHER & ASSOCIATES  
1603 MILTON AVENUE  
P.O. BOX 2588  
JANESVILLE, WI 53545

BEARINGS ARE REFERENCED TO THE  
RECORDED CERTIFIED SURVEY MAP.


N



SCALE 1"=30'

LEGEND

Ø - IRON PIPE FOUND  
-X- - WOOD FENCE  
( ) - RECORDED AS

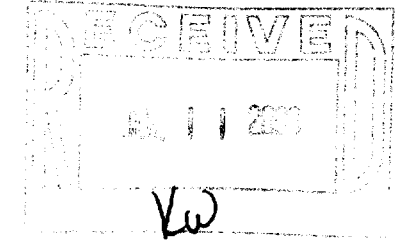

I, DAVID F. ABELL, DO HEREBY CERTIFY THAT I HAVE SURVEYED THE PROPERTY HEREON  
DESCRIBED ACCORDING TO THE OFFICAL RECORDS AND THAT THE PLAT HEREON IS A  
CORRECT REPRESENTATION OF THE PROPERTY LINES TO THE BEST OF MY KNOWLEDGE AND  
BELIEF.

David F. Abell

DAVID F. ABELL  
WISCONSIN REGISTERED LAND SURVEYOR, S-1596

April 30, 2003

DATE JOB NUMBER - 03057  
NOTE: THIS IS NOT A CERTIFIED COPY UNLESS SEALED.

QA1986-1

001-459