


# ABELL SURVEYING & MAPPING

1140 SEQUOIA STREET • DELAVAN, WISCONSIN 53115  
262-728-6737



N

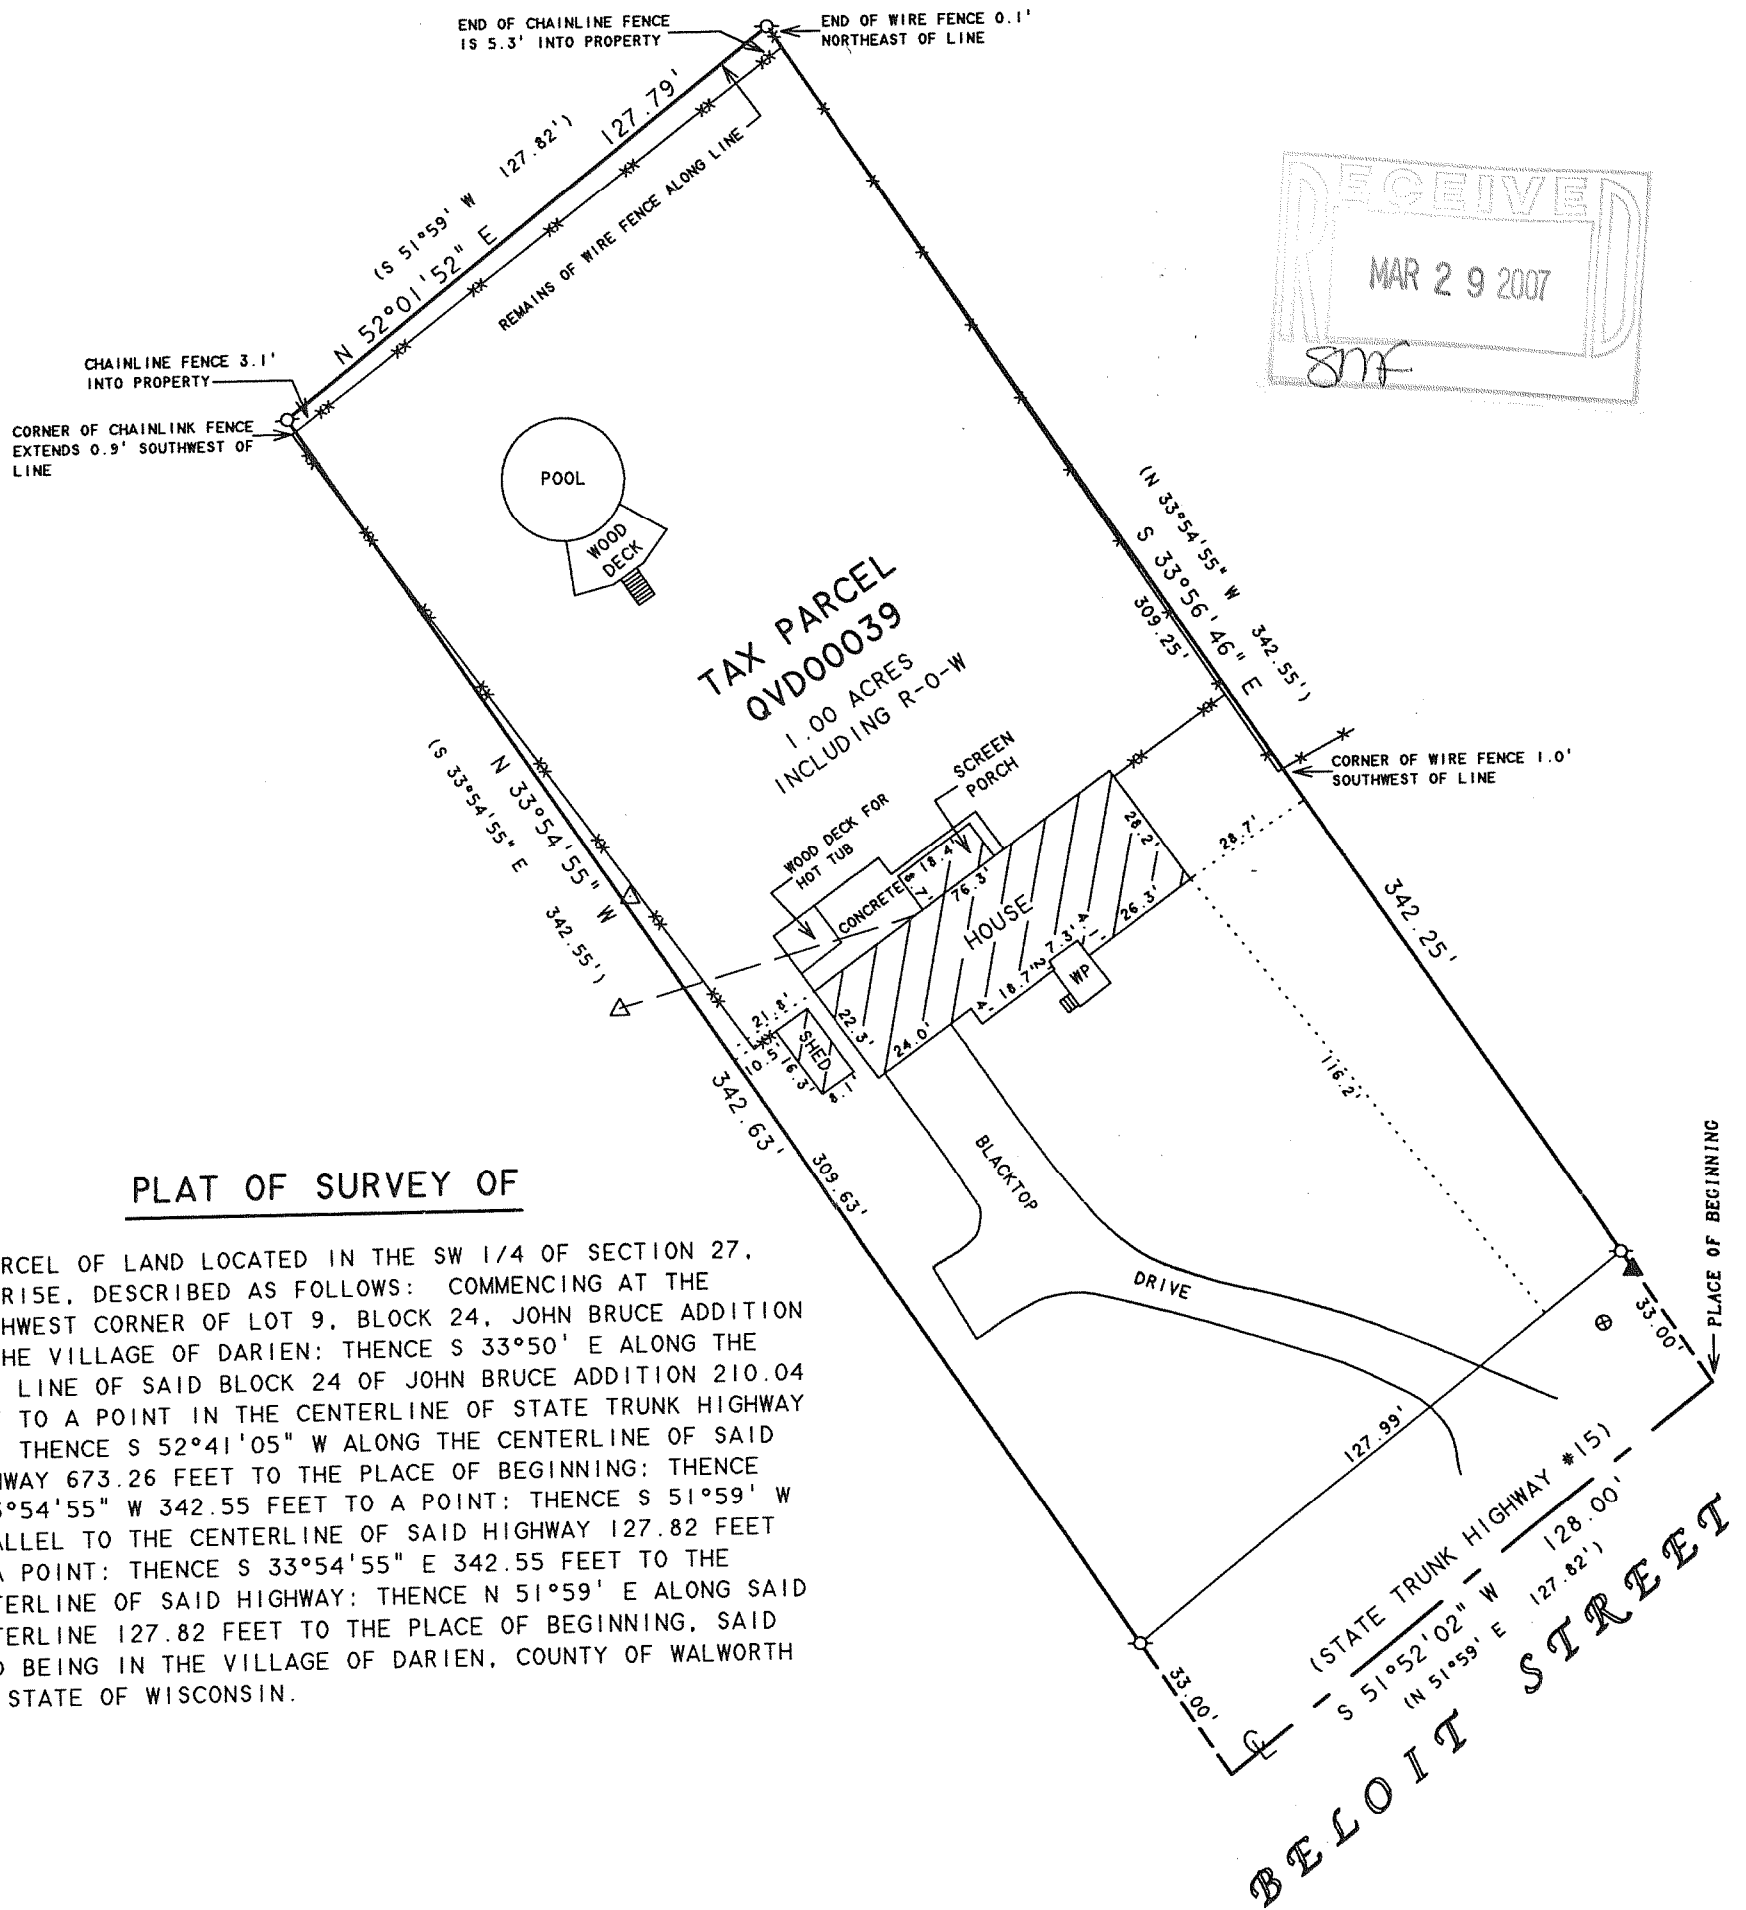

SCALE 1"=40'

## LEGEND

- - IRON PIPE FOUND
- ⊗ - FIRE HYDRANT
- ⊙ - STORM DRAIN
- - CHAINLINK FENCE
- - - - WIRE FENCE
- △ - UTILITY POLE
- - OVERHEAD UTILITY LINES
- WP - WOOD PORCH
- ( ) - RECORDED AS

QVD - 39

001-533