


(51-24)

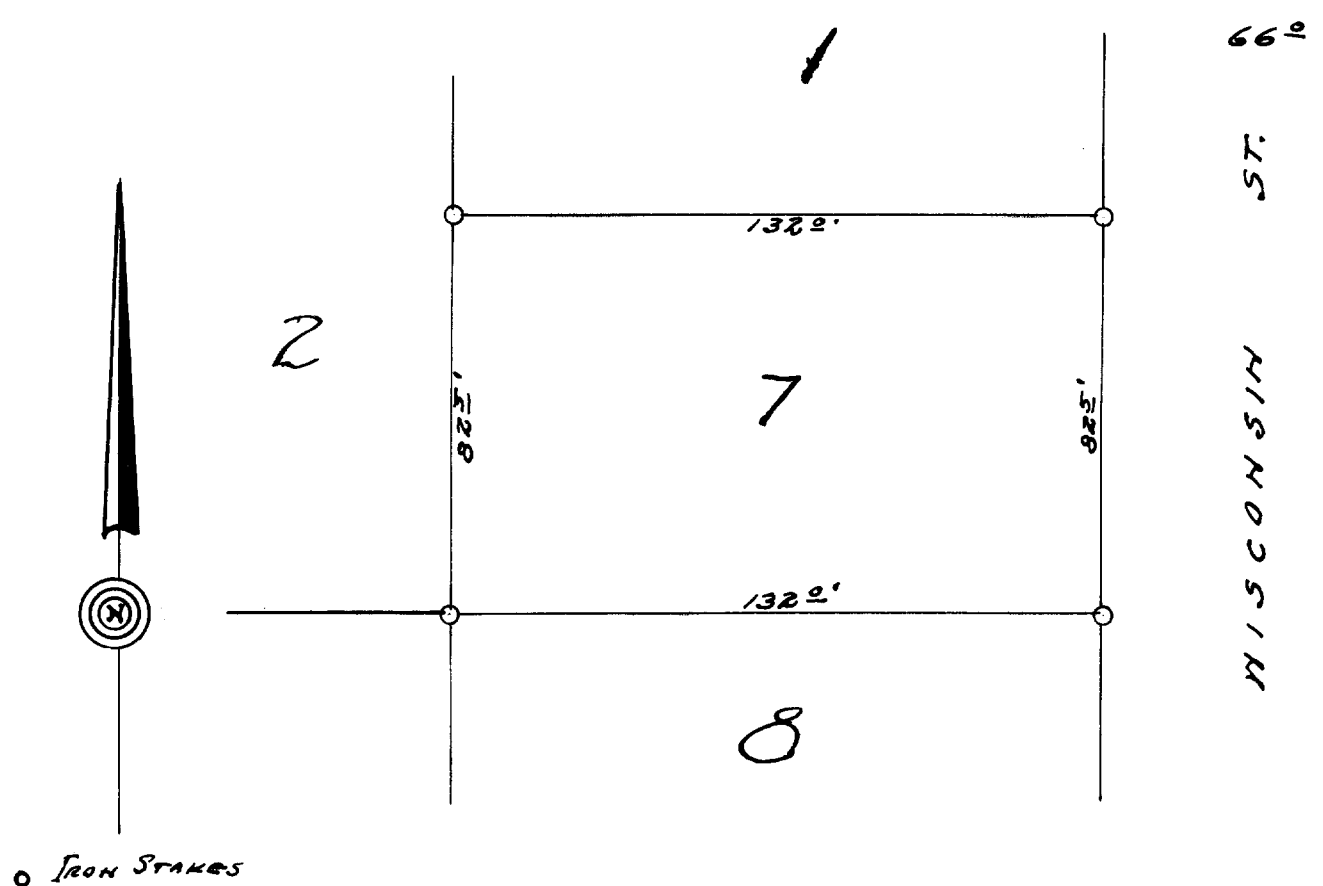

DESCRIPTION:

Lot 7 Block 15, Stone and Topping's Addition to the Village of Darien, Walworth County, Wisconsin.

CERTIFICATE:

I, hereby certify that I, have on this the 16th day of October 1951, surveyed the above described property according to the official record on file in the office of the Recorder of Deeds in and for Walworth County, Wisconsin, and find that the measurements and bearings of the boundary lines of said property as taken at the site on this day, substantially agree with those in said official record and that no encroachments exist.

SIGNED AND SEALED ON THIS THE 20TH DAY OF OCTOBER 1951.

*Joseph M. Biagi*  
Joseph M. Biagi. Professional Engineer.  
Elkhorn Wisconsin.