


GEORGE T. DUNHAM
SURVEYING & SUBDIVIDING
DELAVAN, WISCONSIN

WASHINGTON

STREET

Scale - 1" = 20'
○ = Iron Pipe

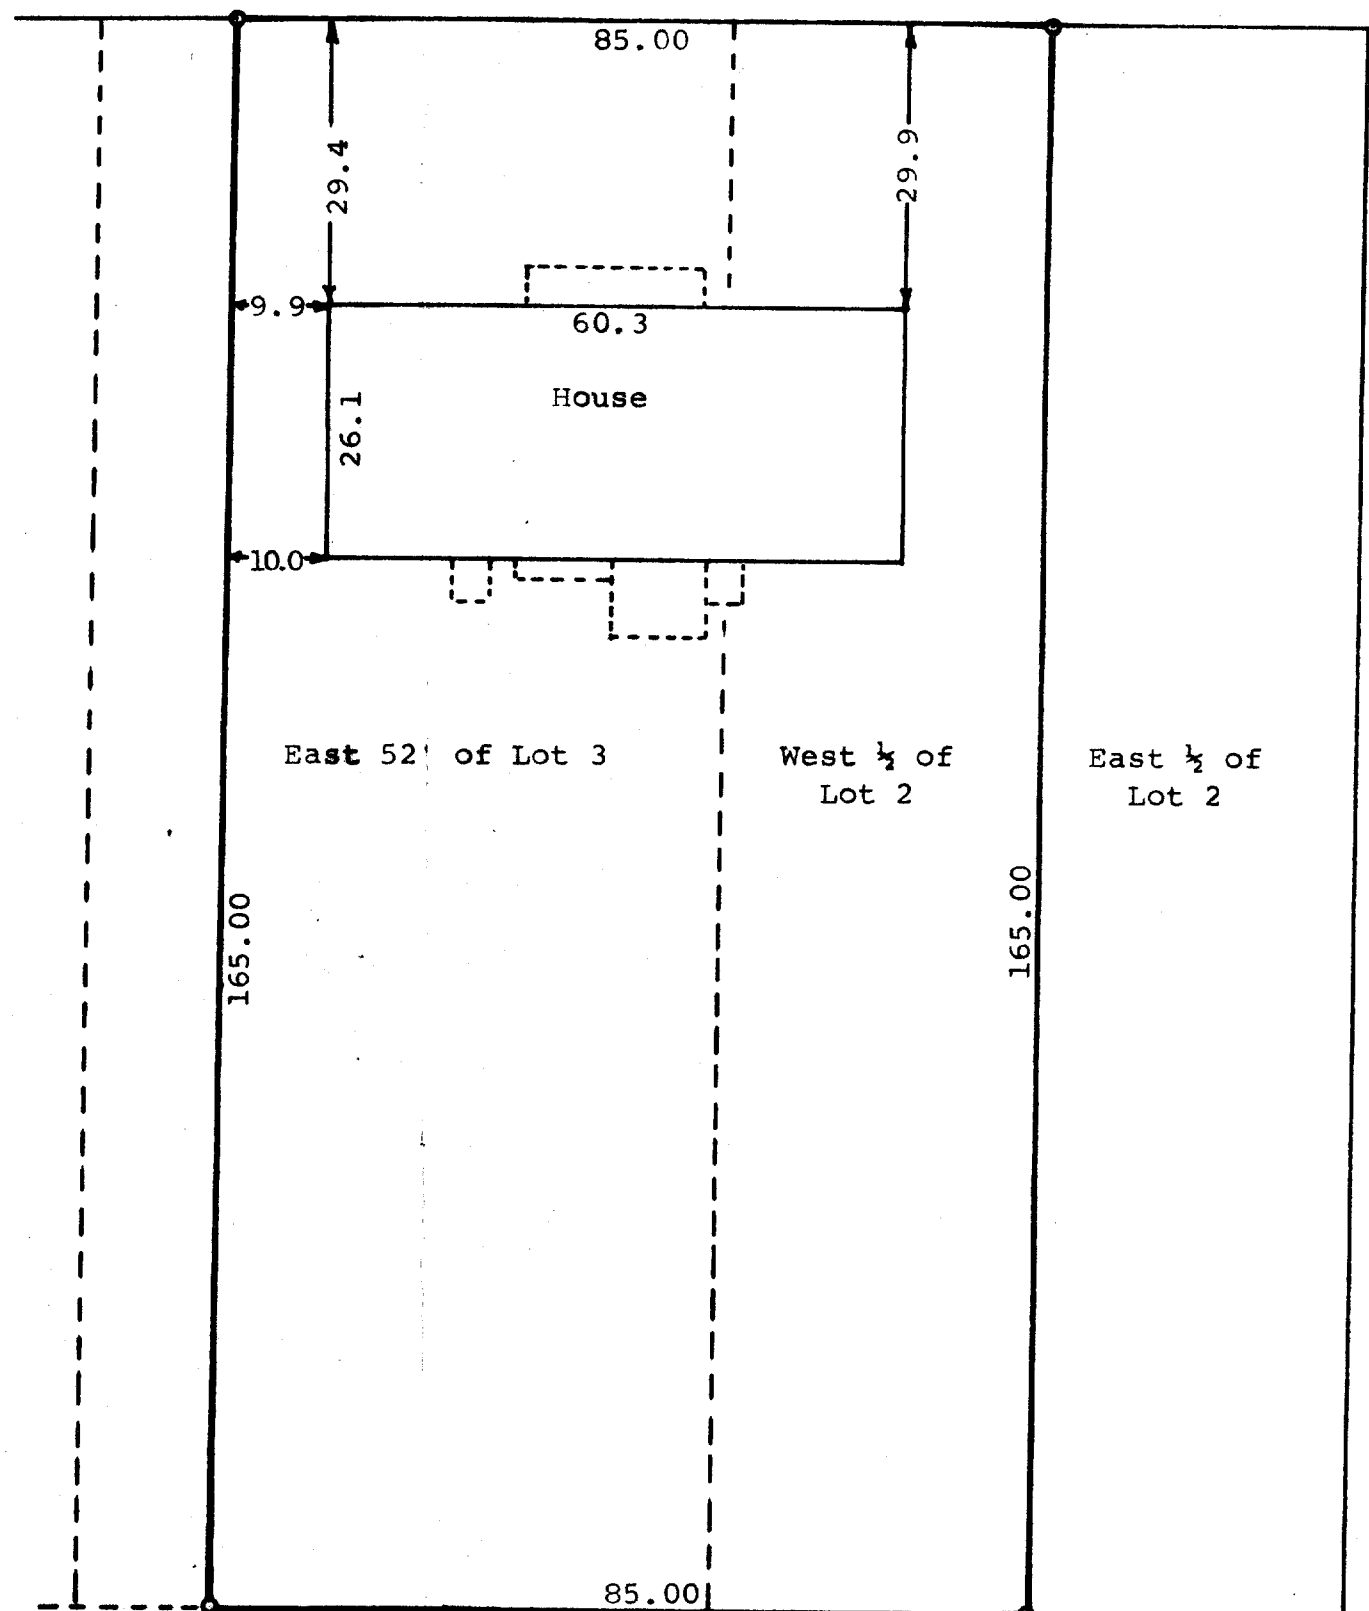

STATE OF WISCONSIN)
COUNTY OF WALWORTH)

I, George T. Dunham, Surveyor, certify that I have surveyed the property described as follows,
The West 1/2 of Lot 2 and the East 52.00 feet of Lot 3 in Block 16 of Stone & Toppings Addition to the Village of Darien, Walworth County, Wisconsin,
and that the above plat is an accurate survey and a true representation thereof and correctly shows the exterior boundary lines and location of buildings on said property and the correct measurements thereof.
February 20, 1974

George T. Dunham
George T. Dunham, Surveyor

