




SCALE ~ 1" = 50'
O = IRON PIPE
X = CROSS IN CONC.

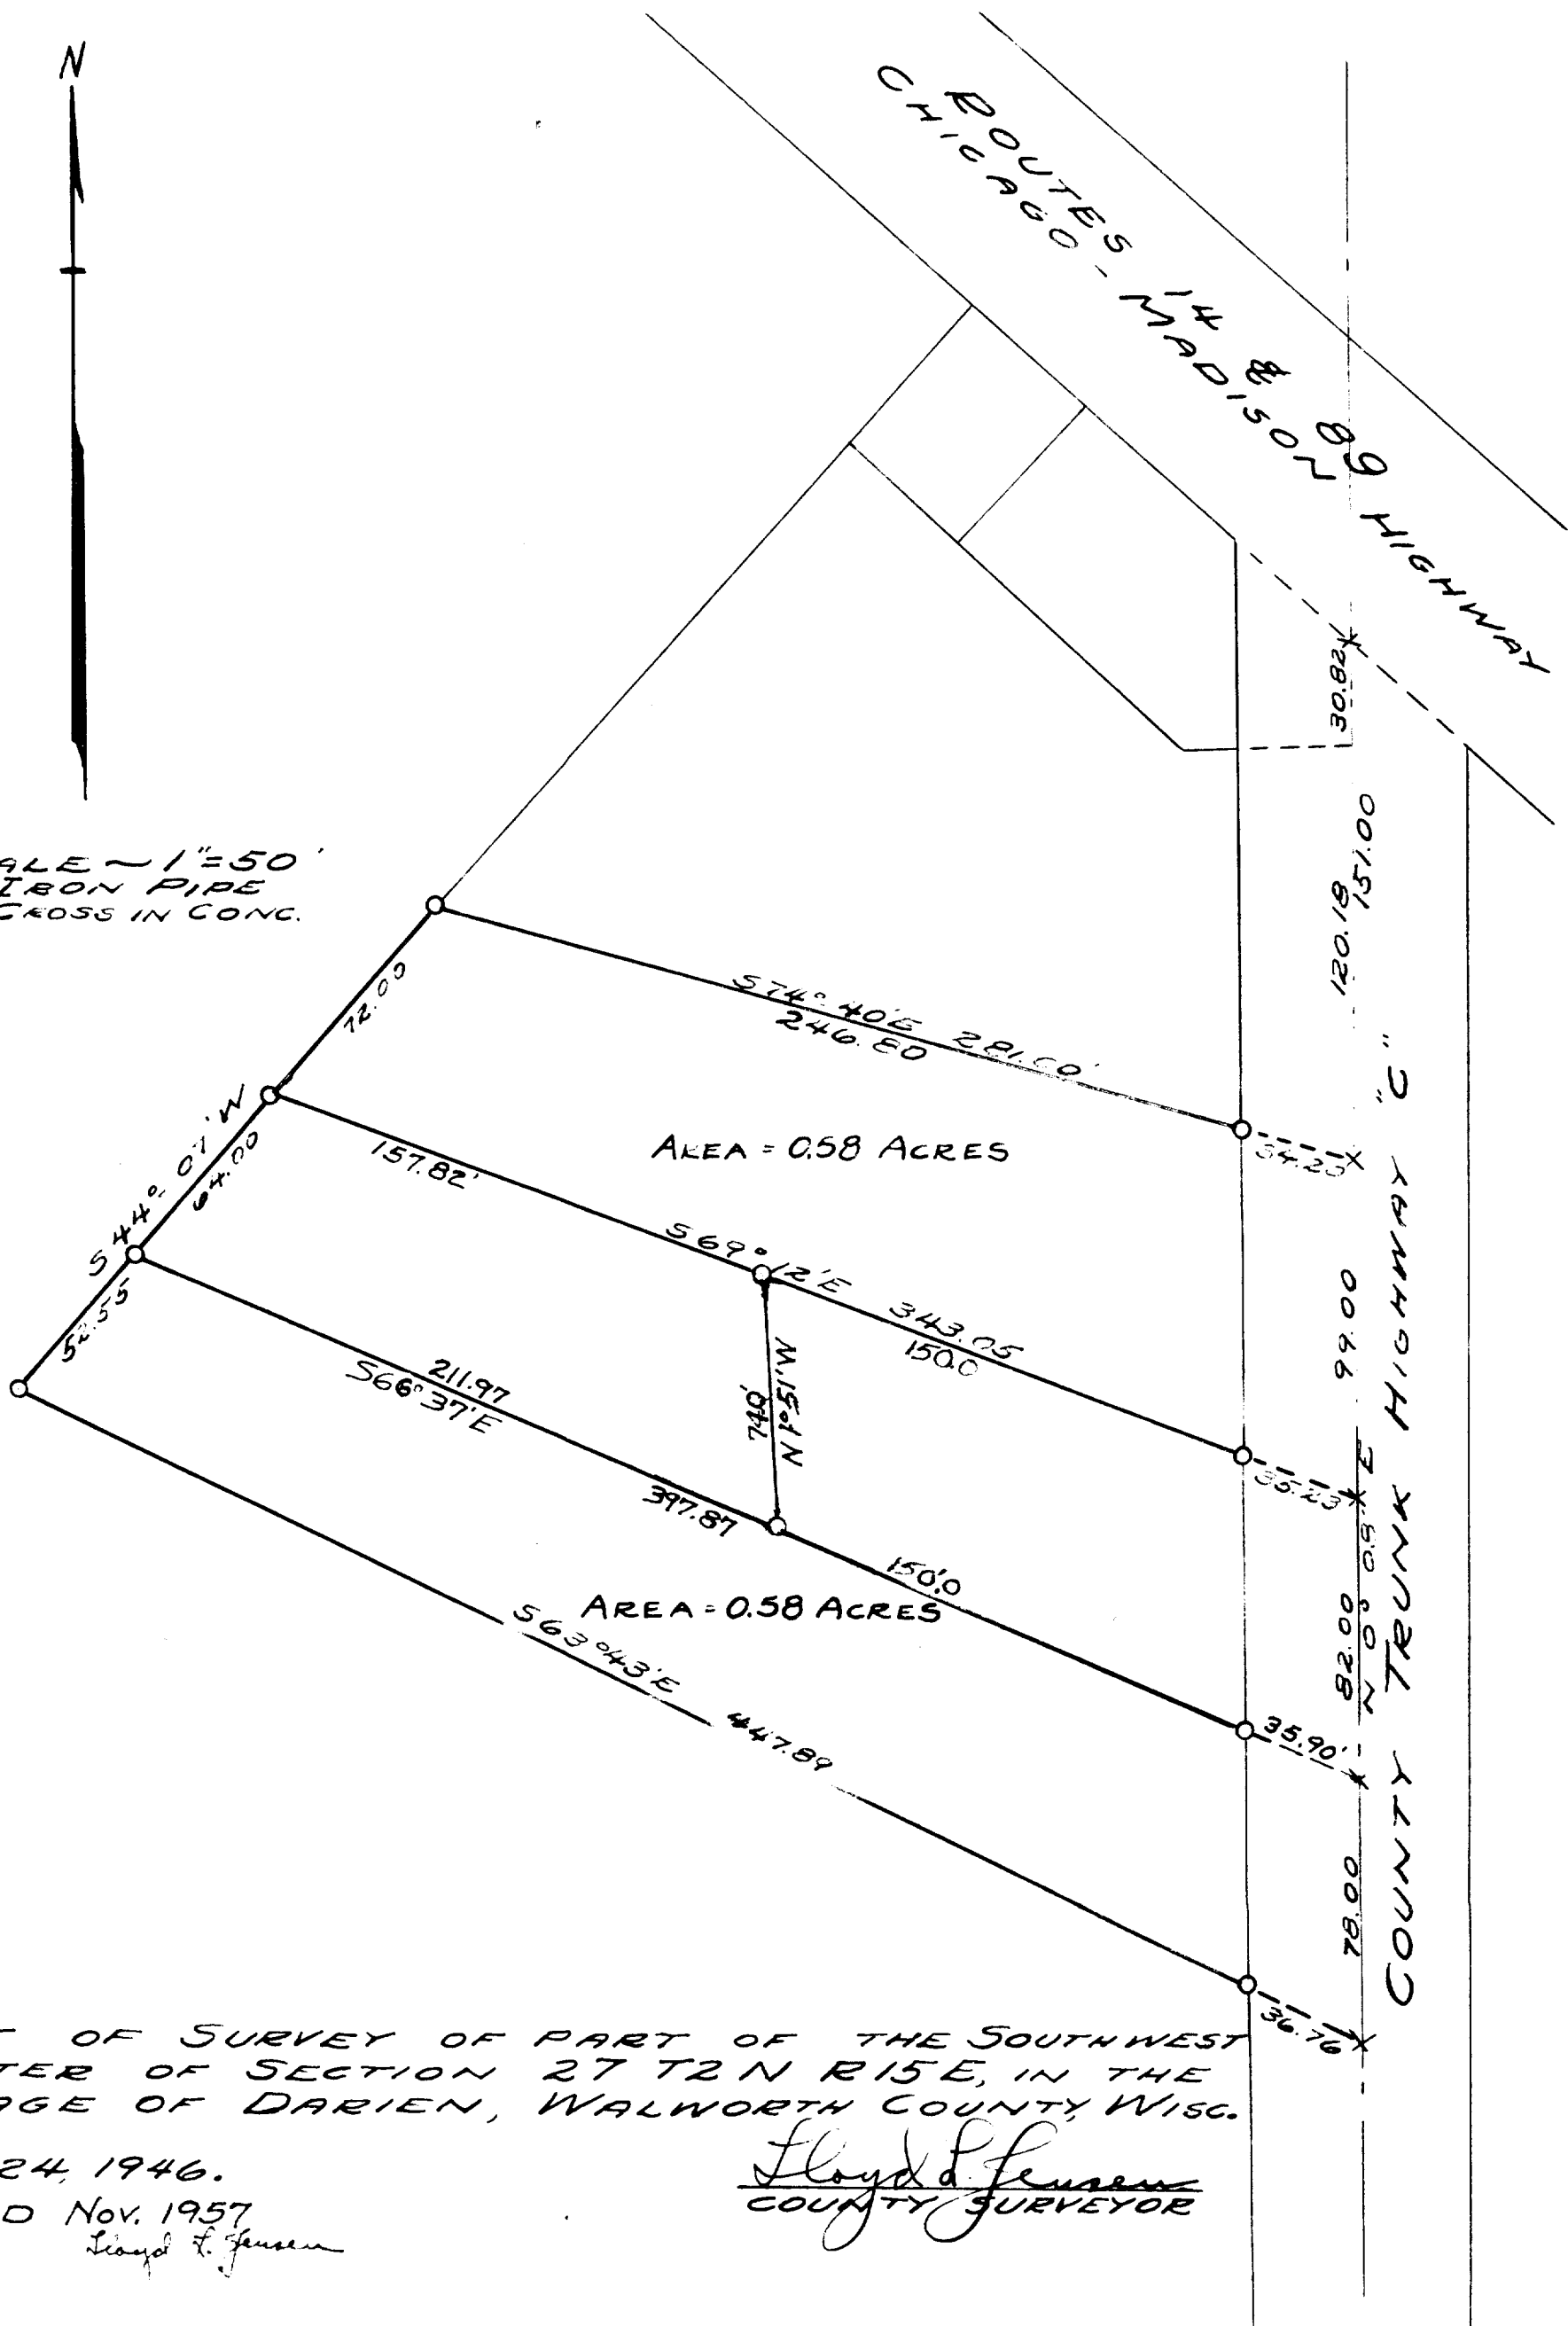

PLAT OF SURVEY OF PART OF THE SOUTHWEST
QUARTER OF SECTION 27 T2N R15E, IN THE
VILLAGE OF DARIEN, WALWORTH COUNTY, WISC.

MAY 24, 1946.

REVISED NOV. 1957

Lloyd L. Jensen

Lloyd L. Jensen
COUNTY SURVEYOR