


DUNHAM SURVEYING, S. C.  
 SURVEYING & SUBDIVIDING  
 DELAVAN, WISCONSIN 53115

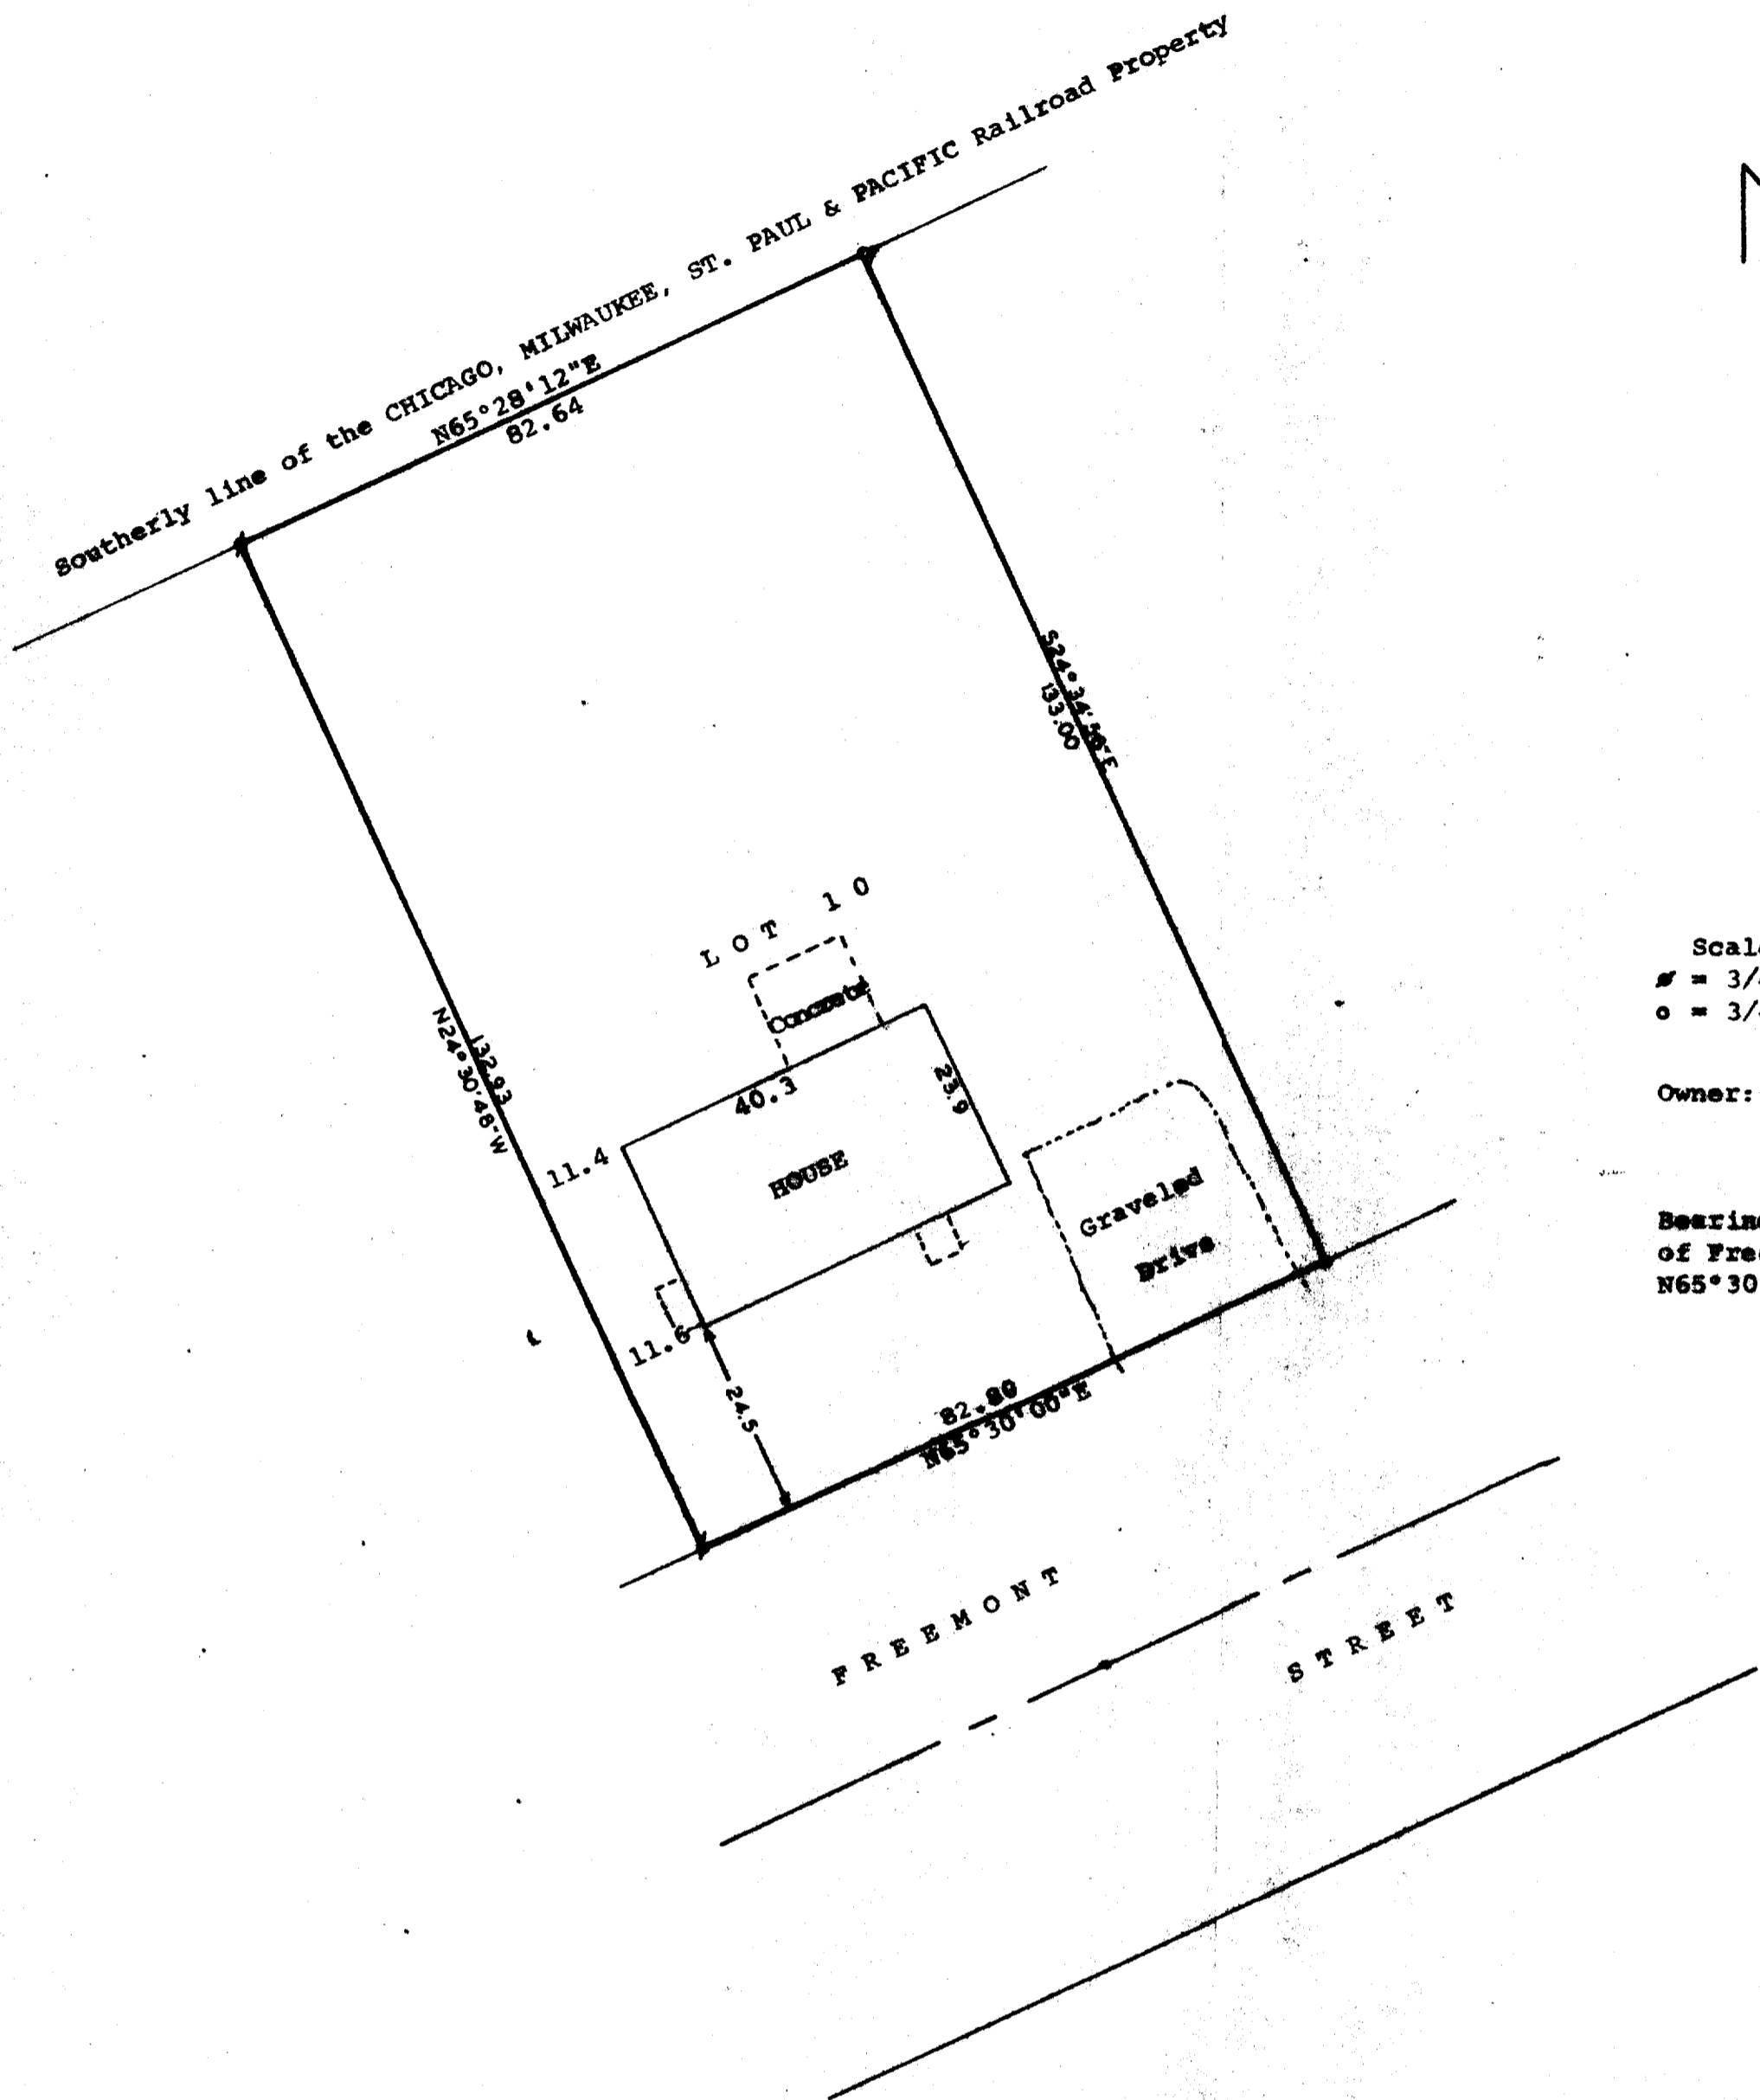

Scale - 1" = 20'  
 # = 3/4" Dia. Iron Pipe Found  
 o = 3/4" Dia. Iron Pipe Set


Owner: Herb Twist Jr.  
 Rt. 1 Box 14  
 Darien, Wisconsin

Bearings referenced to the Northerly line  
 of Fremont Street. Bearing recorded as  
 N65°30'E.

STATE OF WISCONSIN)  
 COUNTY OF WALWORTH) SS

I, George T. Dunham, Surveyor, certify that I have surveyed  
 the property described as follows,  
 Lot 10, Block 23 of John Bruce's Addition to the Village of  
 Darien, Walworth County, Wisconsin,  
 and that the above map is a true representation thereof and shows the  
 size and location of the property, its exterior boundaries, the  
 location of all visible structures and dimensions of all principal  
 buildings thereon, boundary fences, apparent easements, roadways and  
 visible encroachments, if any.  
 This survey is made for the use of the present owners of the property,  
 and also those who purchase, mortgage, or guarantee the title thereto  
 within one(1) year from date hereof.  
 September 23, 1982

*George T. Dunham*  
 George T. Dunham, Surveyor

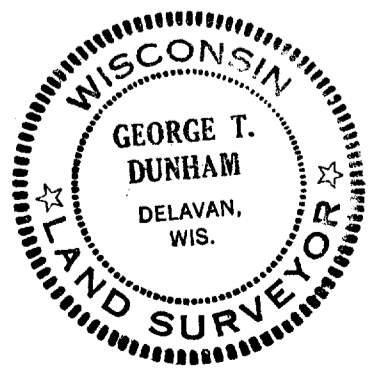

QBA-303