
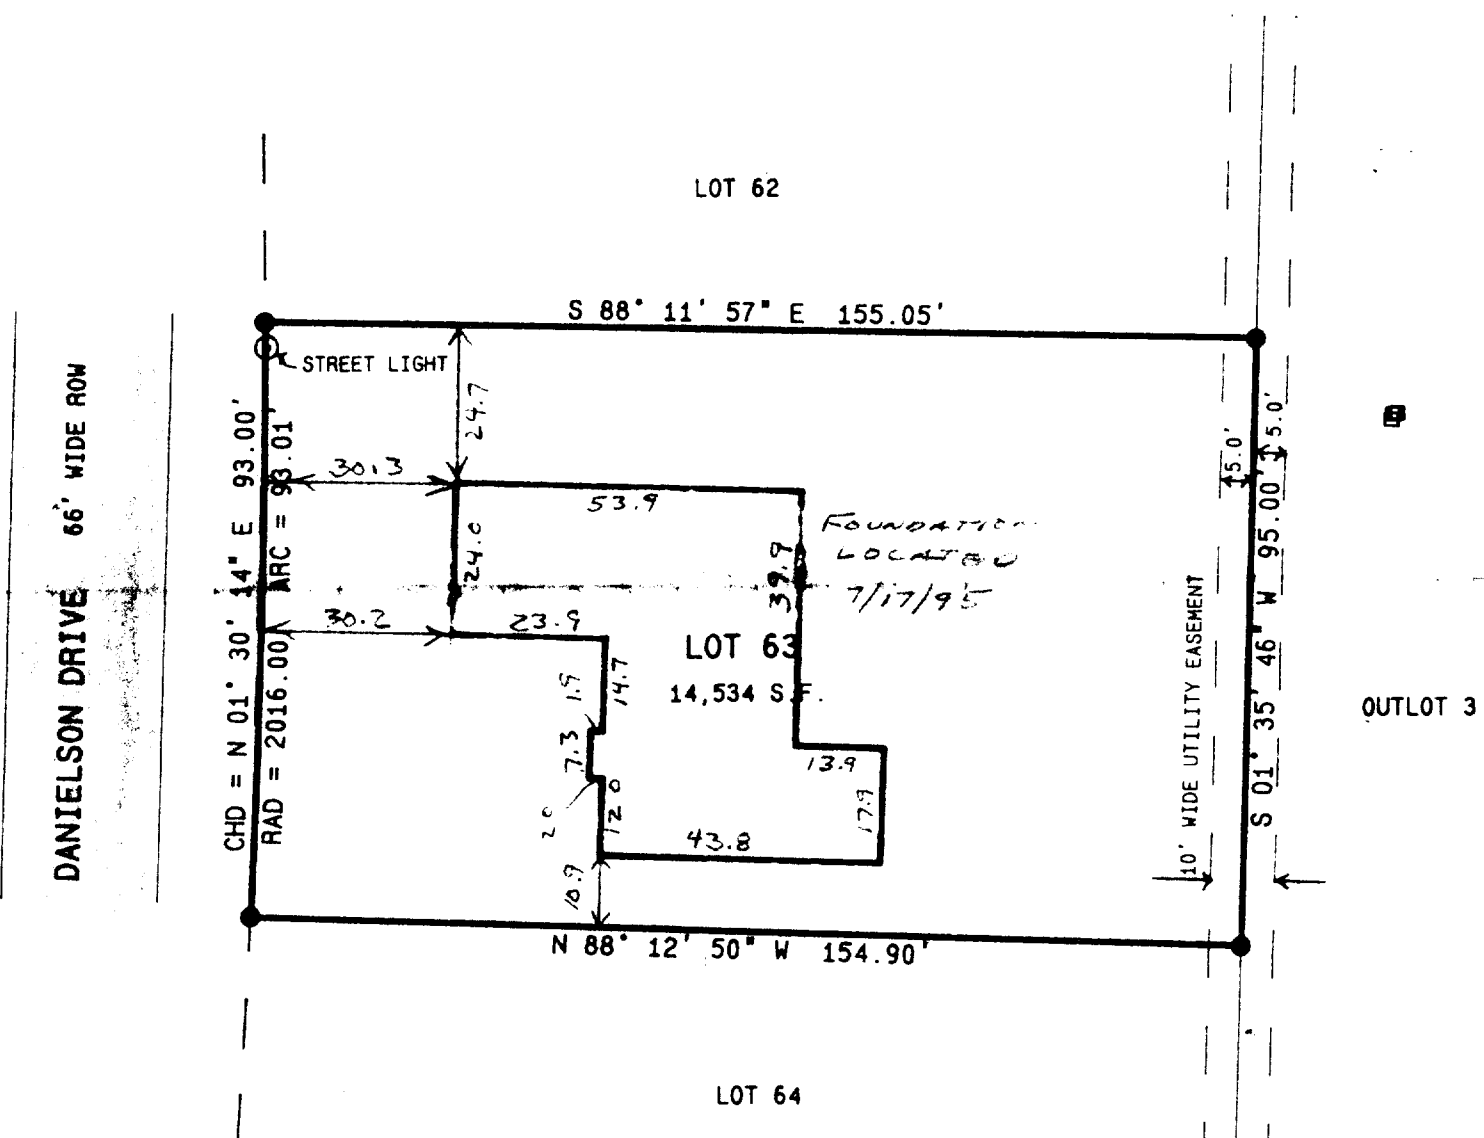


FARRIS, HANSEN & ASSOCIATES, INC.  
 ENGINEERING, ARCHITECTURE, SURVEYING  
 7 RIDGWAY COURT - P.O. BOX 437, ELKHORN, WISCONSIN 53121  
 PHONE: (414) 723-2098 FAX: (414) 723-5886


PLAT OF SURVEY  
 LOT 63 OF OAKRIDGE SUBDIVISION  
 ADDITION NO. 1

LOCATED IN THE SW 1/4 OF THE SW 1/4 OF SECTION 26  
 TOWN 2 NORTH, RANGE 15 EAST  
 VILLAGE OF DARIEN, WALWORTH COUNTY, WISCONSIN

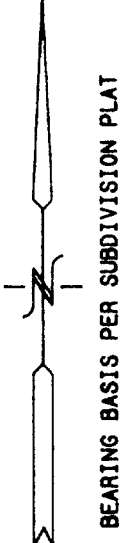

ORDERED BY: JAMES & CINDY CUTTS  
 P.O. BOX 717  
 DARIEN, WI. 53114

- = FOUND IRON REBAR STAKE
- = UTILITY CONTROL BOX

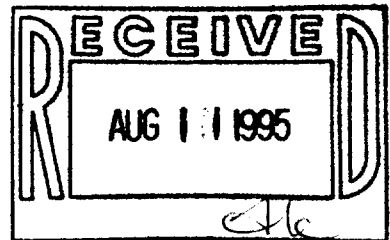

MAP SCALE IN FEET ORIGINAL 1" = 30'


NOTE: COPIES OF THIS MAP TO WHICH THE FOLLOWING CERTIFICATE WILL APPLY ARE BLUE LINE PRINTS SHOWING SURVEYOR'S ORIGINAL SEAL AND SIGNATURE IN BLACK INK. COPIES BY ANY OTHER MEANS MAY HAVE ALTERATIONS WHICH DO NOT REPRESENT THE SURVEYOR'S WORK PRODUCT.

I HEREBY CERTIFY THAT THE ABOVE DESCRIBED PROPERTY HAS BEEN SURVEYED UNDER MY DIRECTION AND THAT THE ABOVE MAP IS A TRUE REPRESENTATION THEREOF AND SHOWS THE SIZE AND LOCATION OF THE PROPERTY AND ITS EXTERIOR BOUNDARIES. THIS SURVEY IS MADE FOR THE USE OF THE PRESENT OWNERS OF THE PROPERTY, AND ALSO THOSE WHO PURCHASE, MORTGAGE, OR GUARANTEE THE TITLE THERETO WITHIN ONE YEAR FROM THE DATE HEREOF.

DATED: 6-5-95

REVISED 7-18-95 TO SHOW SIZE + LOCATION OF FOUNDATION AS BUILT

*Peter S. Gordon*  
 PETER S. GORDON R.L.S. 2101

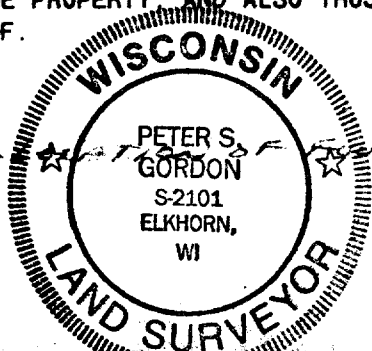

PROJ 3575.63  
 SHEET 1 OF 1

001-317

001-19