


GEORGE T. DUNHAM
SURVEYING & SUBDIVISION
DELAVER, WISCONSIN.



WISCONSIN

STREET

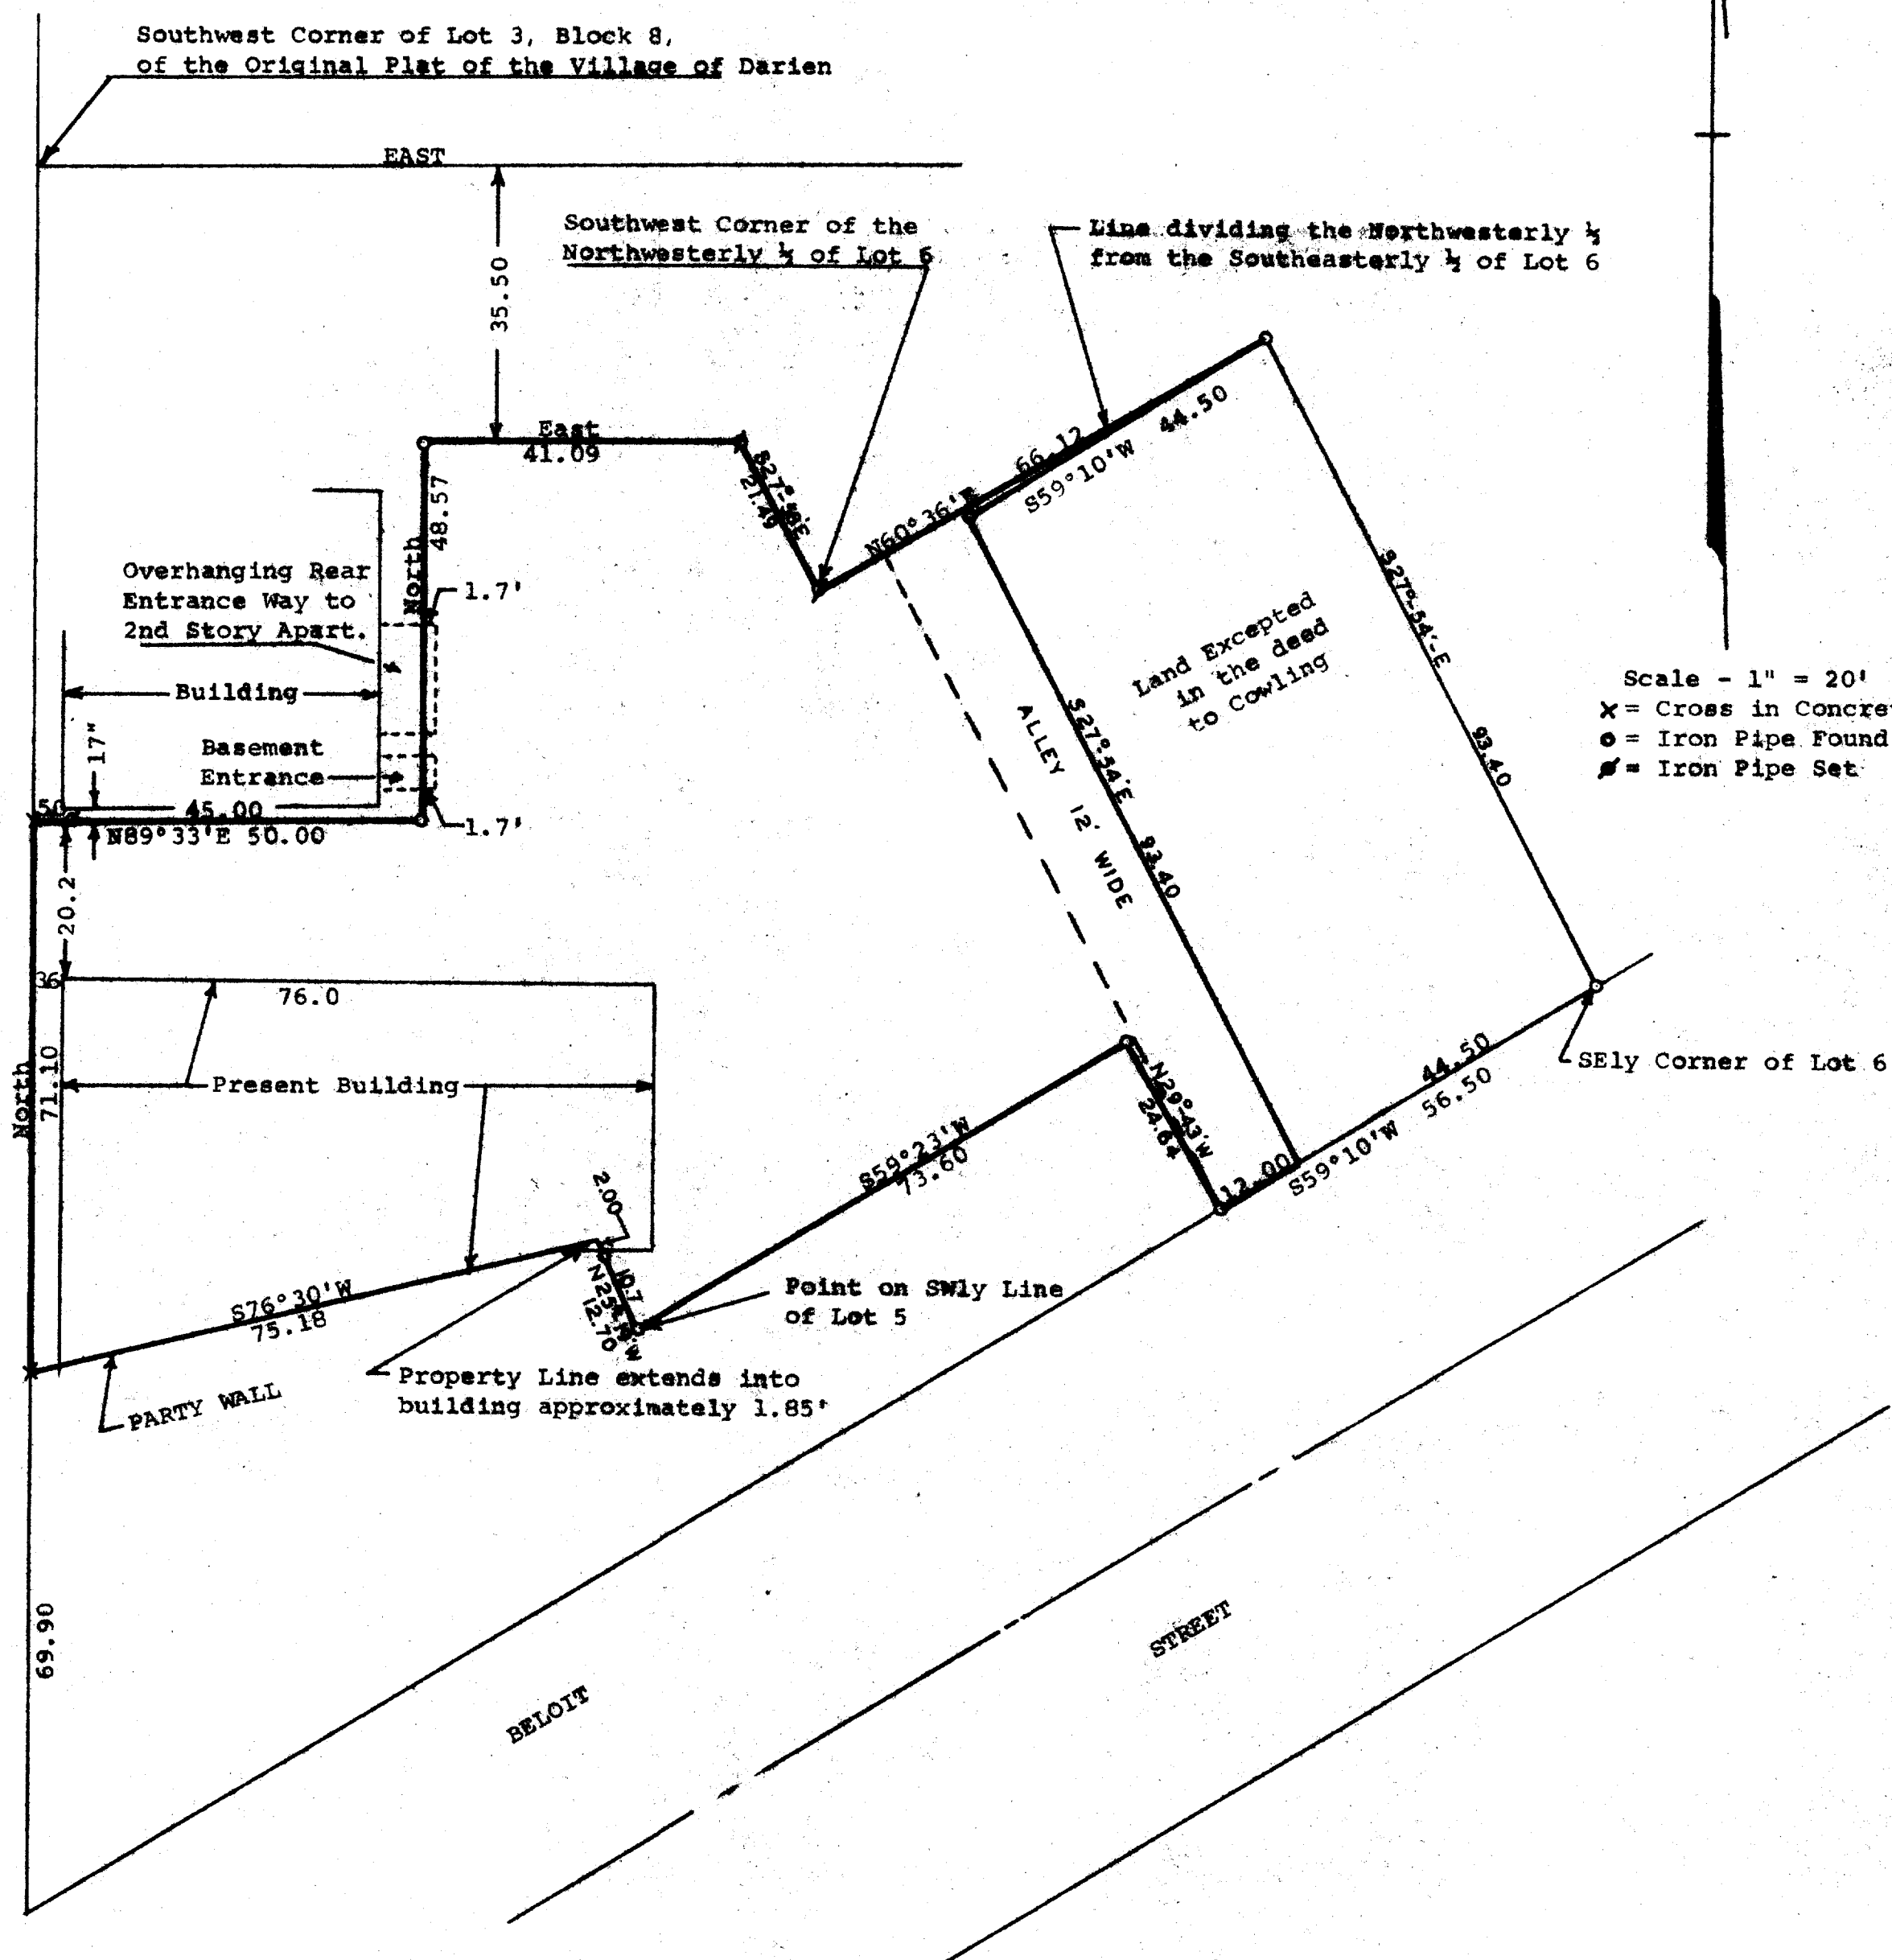

Plat of survey of a parcel of land located in Lots 4, 5, and 6,
Block 8 of the Original Plat of the Village of Darien, Walworth
County, Wisconsin.
December, 1975

George T. Dunham
George T. Dunham, Surveyor

