


U. S. Highway No. 14

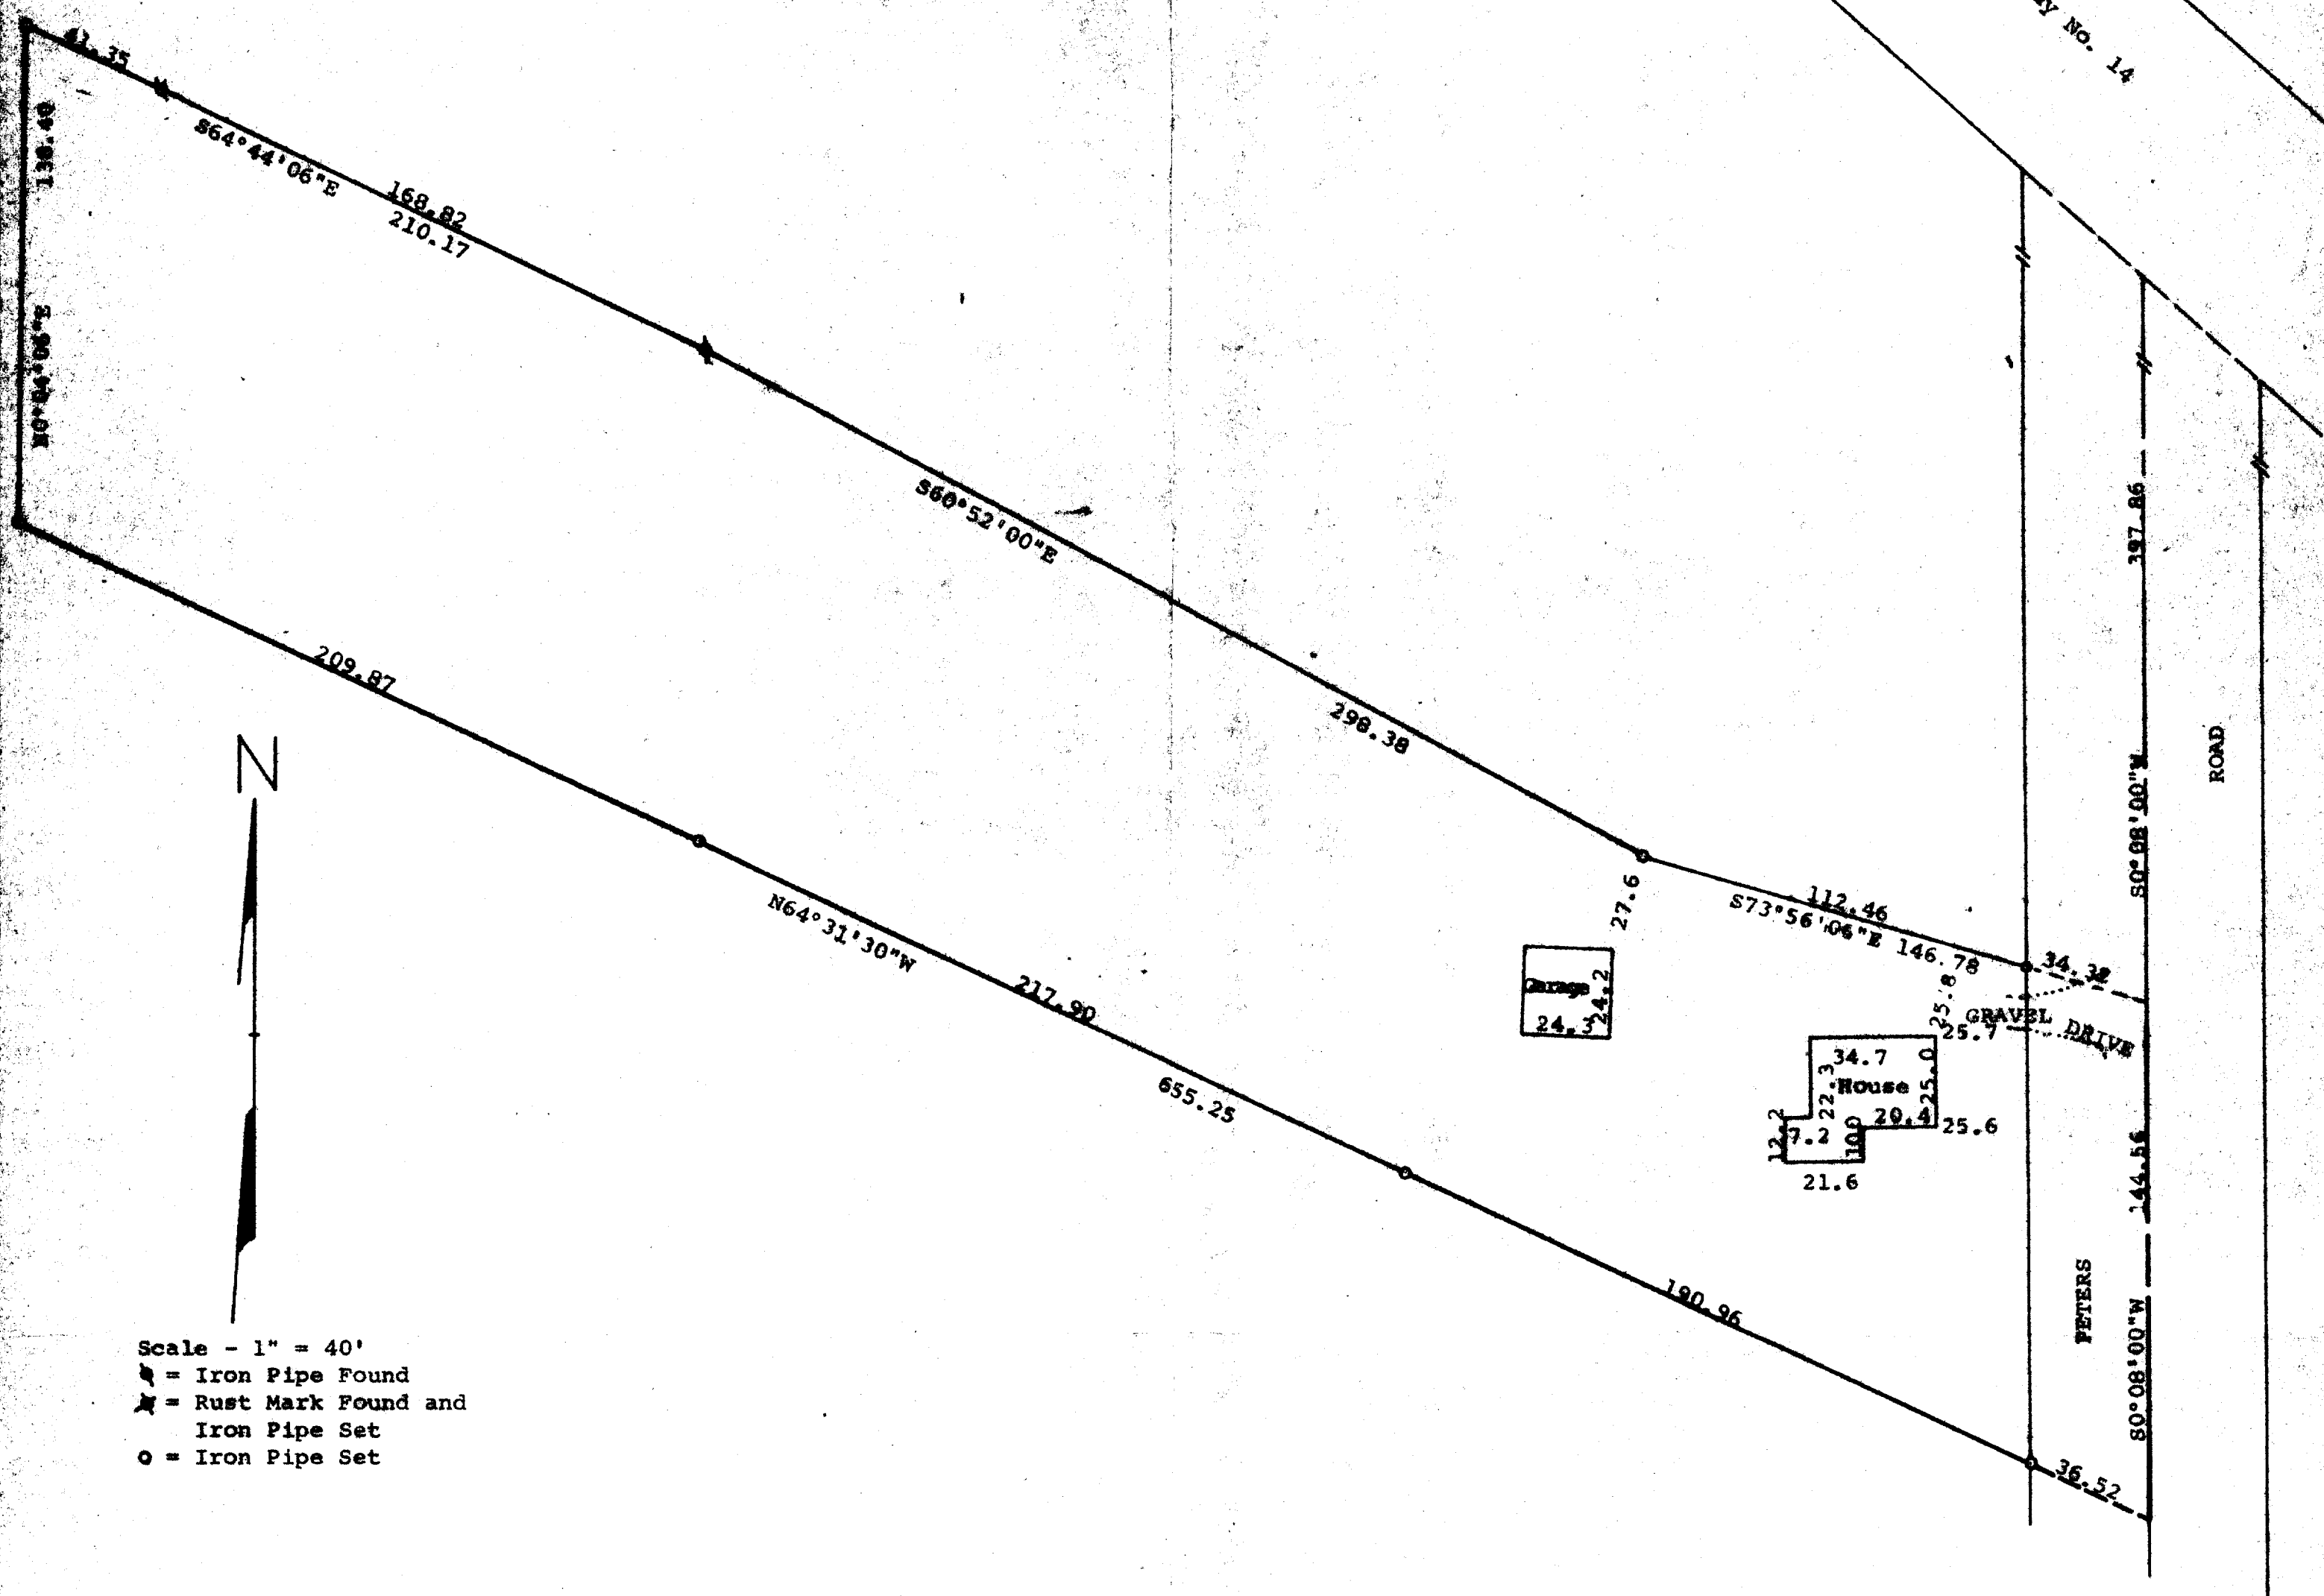

* = Iron Pipe Found
 * = Rust Mark Found and
 Iron Pipe Set
 o = Iron Pipe Set

December 18, 1979
Revised Jan. 11, 1980

George T. Dunham
George T. Dunham, Surveyor

