


DUNHAM SURVEYING, S.C.  
SURVEYING & SUBDIVIDING  
DELAVER, WISCONSIN 53115

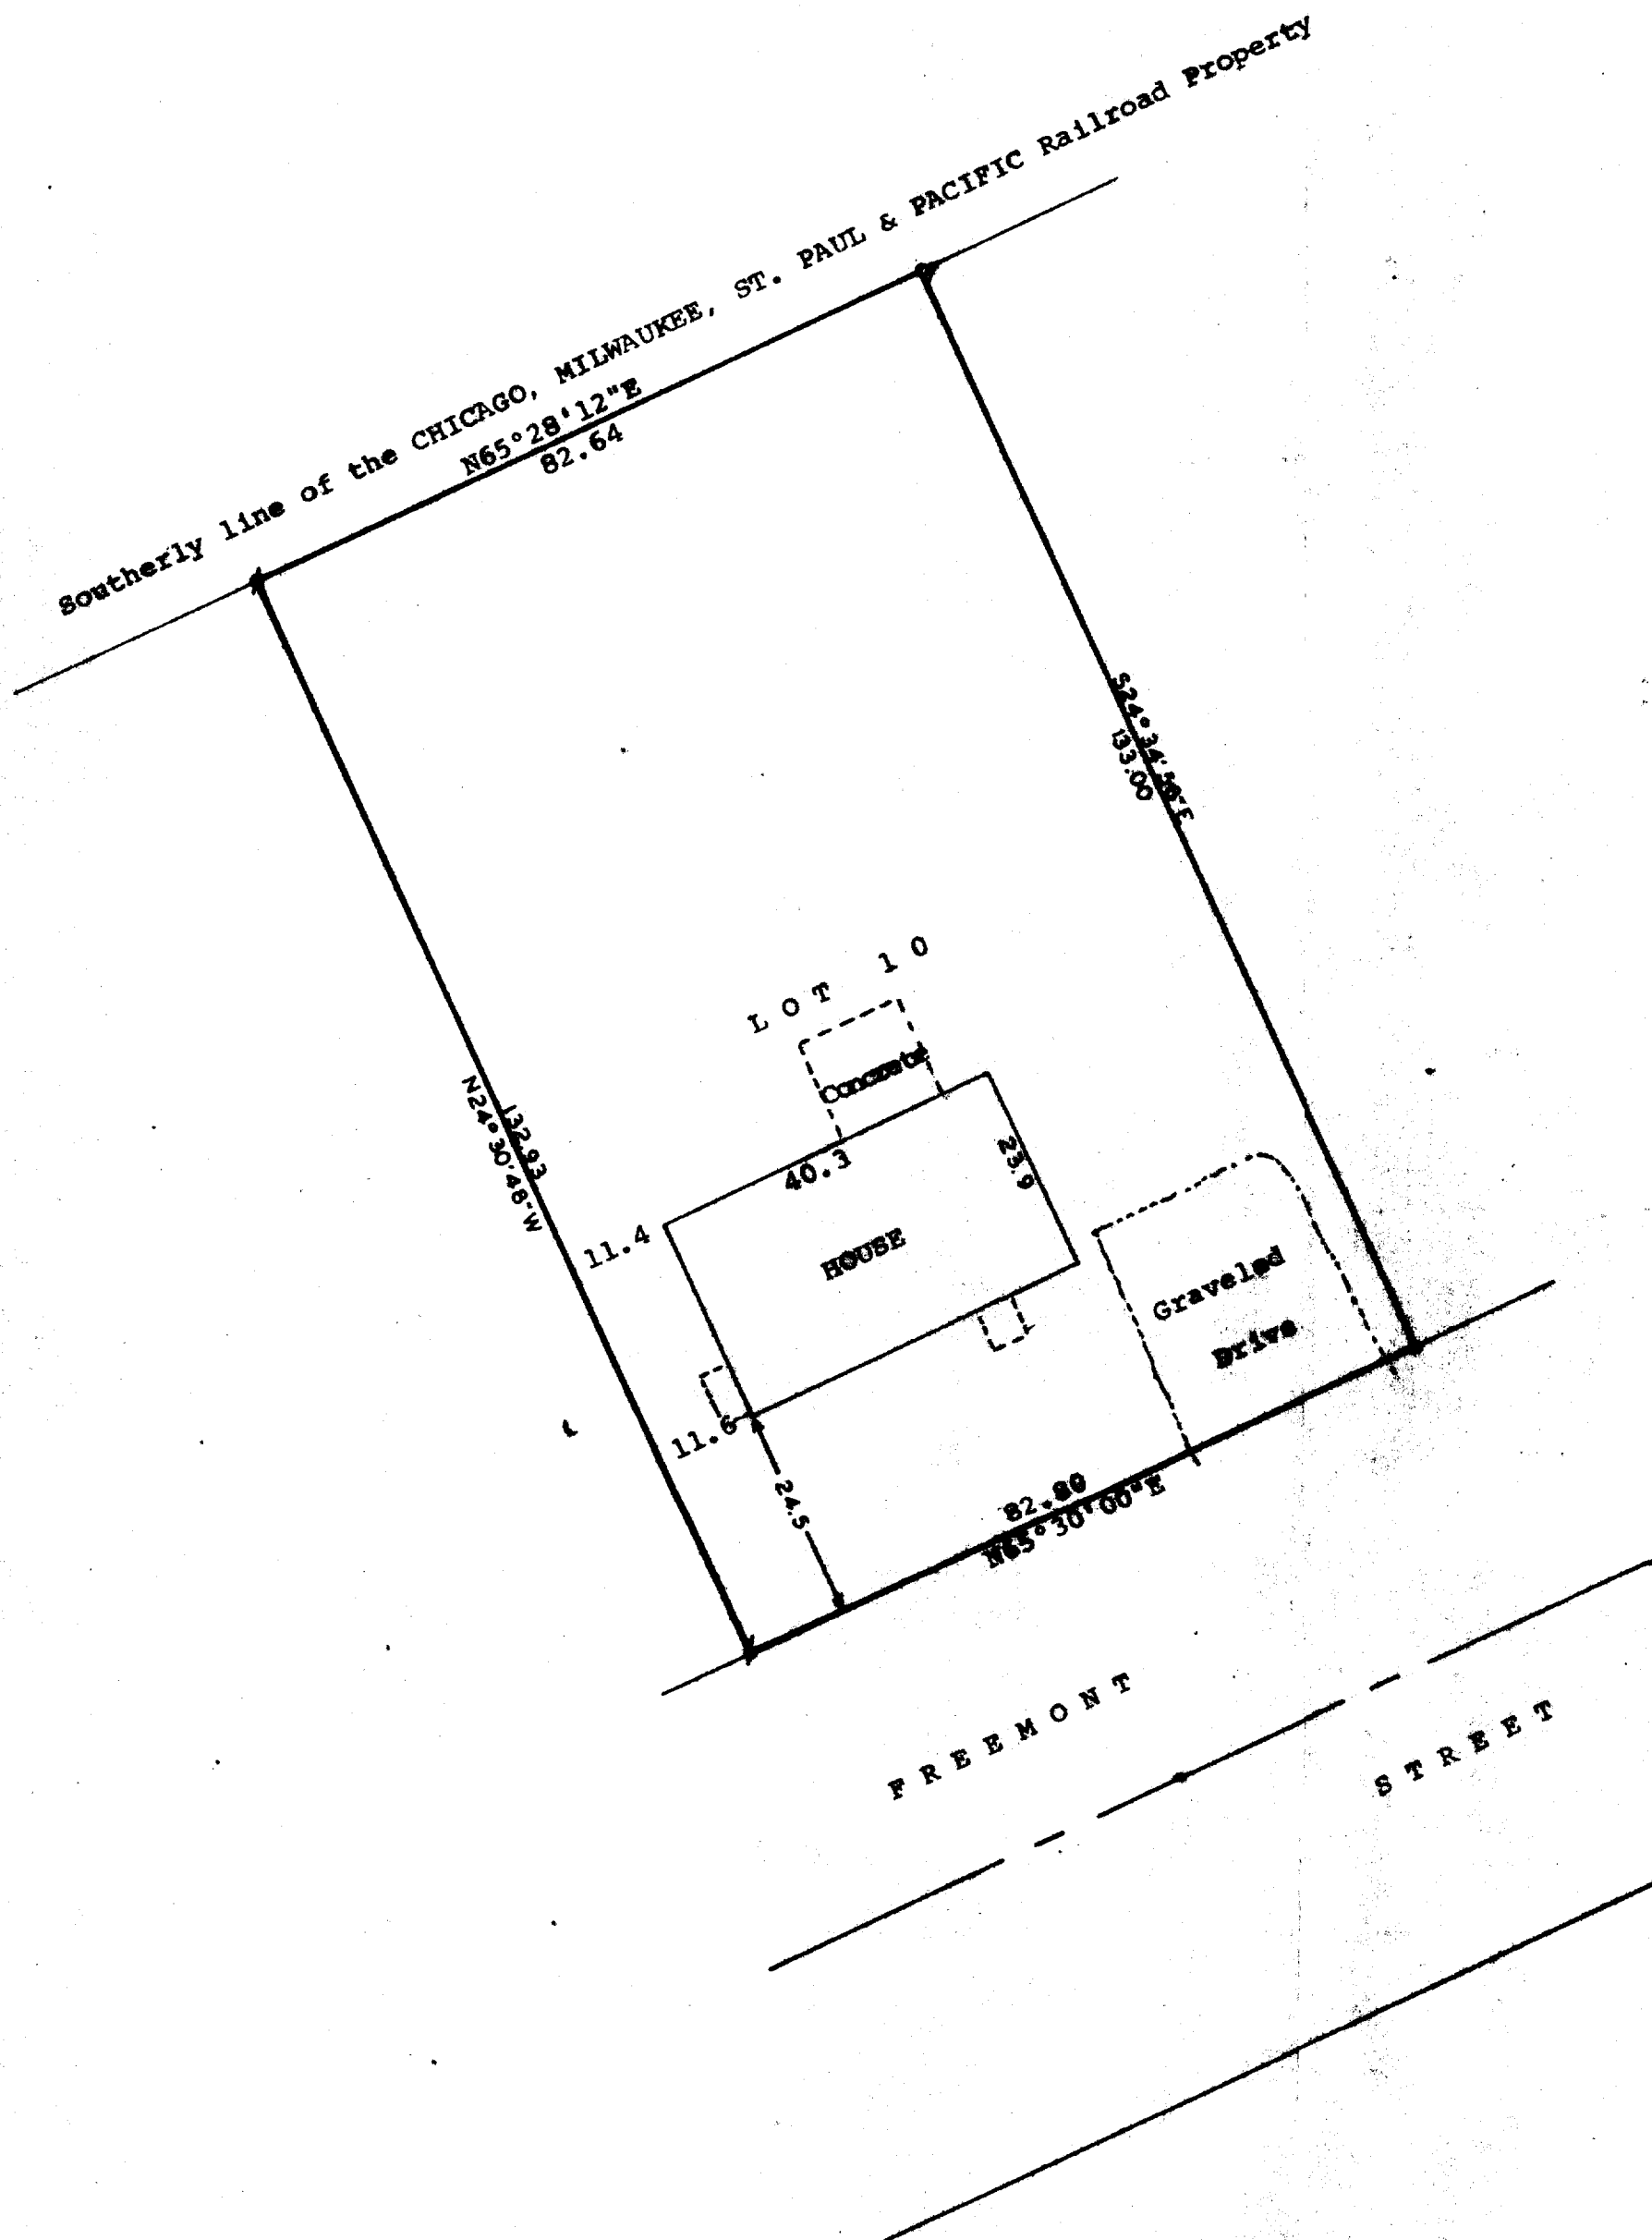

N

Scale - 1" = 20'  
# = 3/4" Dia. Iron Pipe Found  
o = 3/4" Dia. Iron Pipe Set

Owner: Herb Twist Jr.  
Rt. 1 Box 14  
Darien, Wisconsin

Bearings referenced to the Northerly line  
of Freemont Street. Bearing recorded as  
N65°30'E.

STATE OF WISCONSIN)  
COUNTY OF WALWORTH) SS

I, George T. Dunham, Surveyor, certify that I have surveyed  
the property described as follows,


Lot 10, Block 23 of John Bruce's Addition to the Village of  
Darien, Walworth County, Wisconsin,

and that the above map is a true representation thereof and shows the  
size and location of the property, its exterior boundaries, the  
location of all visible structures and dimensions of all principal  
buildings thereon, boundary fences, apparent easements, roadways and  
visible encroachments, if any.

This survey is made for the use of the present owners of the property,  
and also those who purchase, mortgage, or guarantee the title thereto  
within one(1) year from date hereof.

September 23, 1982

*George T. Dunham*  
George T. Dunham, Surveyor

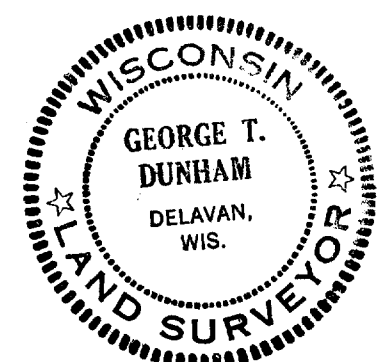

QBA-3C3

K & E 10-0155