


DUNHAM SURVEYING, S.C.
 SURVEYING & SUBDIVISION
 DELAVAN, WISCONSIN 53115

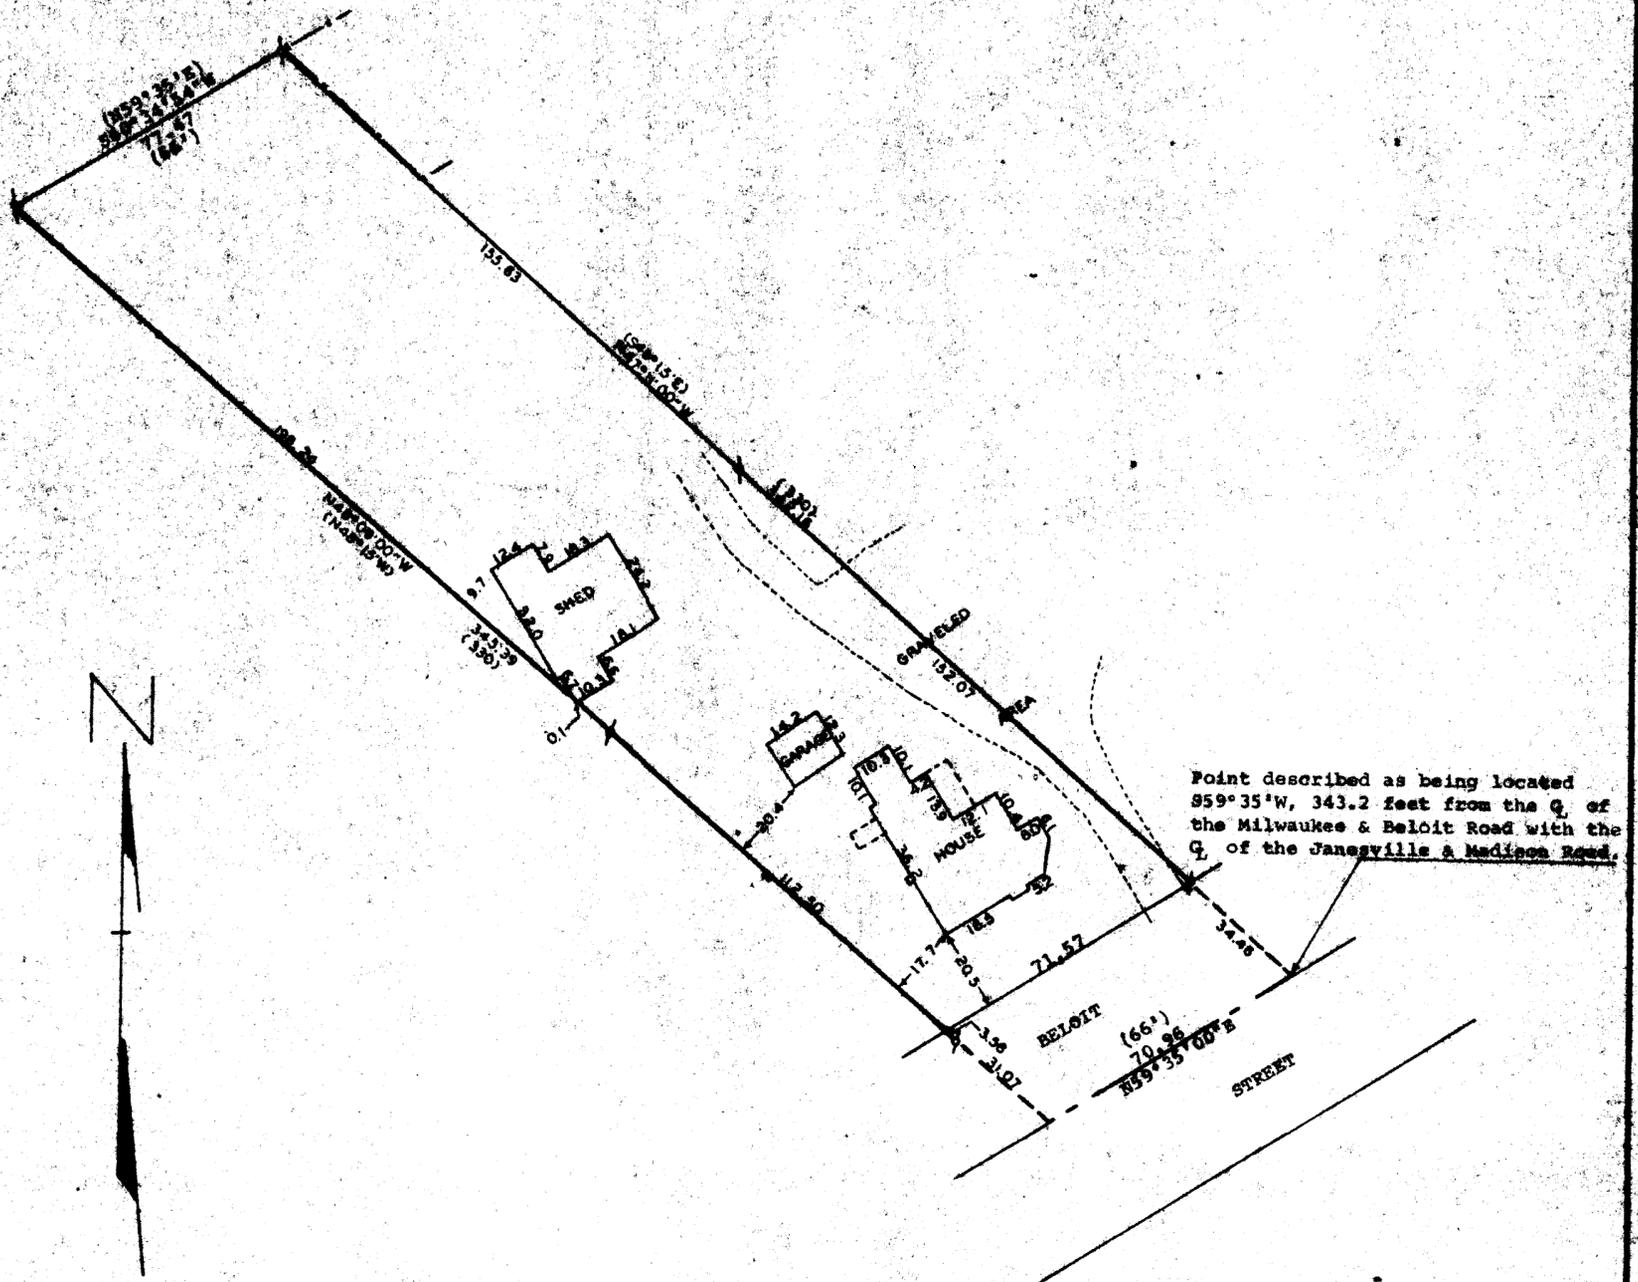

Point described as being located
 S59°35'W, 343.2 feet from the Q₁ of
 the Milwaukee & Beloit Road with the
 Q₁ of the Janesville & Madison Road.

Scale - 1" = 30'
 / = 1" Dia. Iron Pipe Found
 / = 3/4" Dia. Iron Pipe Found
 o = 1/4" Dia. Iron Pipe Set
 --- = Fence Line
 (xxx) = Recorded Data

Bearings are referenced to the center line of Beloit Street.
 Bearing of N59°35'E is taken from records.

Ordered by: Ken Danielson
 Realtor
 Darien, Wisconsin 53114


STATE OF WISCONSIN)
 COUNTY OF WALWORTH)

I, George T. Dunham, Surveyor, certify that I have surveyed the property described as follows.

A parcel of land located in the East 1/2 of the Southwest 1/4 of Section 27, T 2 N, R 13 E, Village of Darien, Walworth County, Wisconsin, described as follows: Beginning at a point located S59°35'W, 343.20 feet from the intersection of the centerline of U.S. Highway No. 14 and the centerline of Beloit Street in said Village of Darien; thence continue S59°35'00"W along the centerline of said Beloit Street 70.96 feet (described as 66'); thence N48°08'00"W, 345.19 feet (described as N48°15'W 330'); thence N60°34'54"E 77.47 feet, (described as N59°35'E 66'); thence S47°11'00"E 342.16 feet, (described as S48°15'E 330') to the place of beginning.

and that the above map is a true representation thereof and shows the size and location of the property, its exterior boundaries, the location of all visible structures and dimensions of all principal buildings thereon, boundary fences, apparent easements, roads and visible encroachments, if any, and that I have surveyed the property herein described according to the official records, to the best of my knowledge and belief.
 March 14, 1983

George T. Dunham
 George T. Dunham, Surveyor

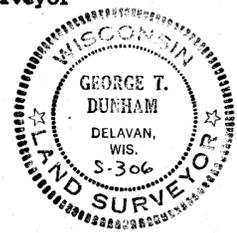

Q-VD-54