


TRAVERSE OF NORTH LINE SECTION 34-2-15


JENSEN SURVEYING & MAPPING SC.

P.O. BOX 322
45 SOUTH WISCONSIN ST
ELKHORN, WIS 53121

SURVEYED UNDER THE DIRECTION OF THOMAS P.A. JENSEN E.L.S. - 1084
SURVEYED FOR WALWORTH COUNTY

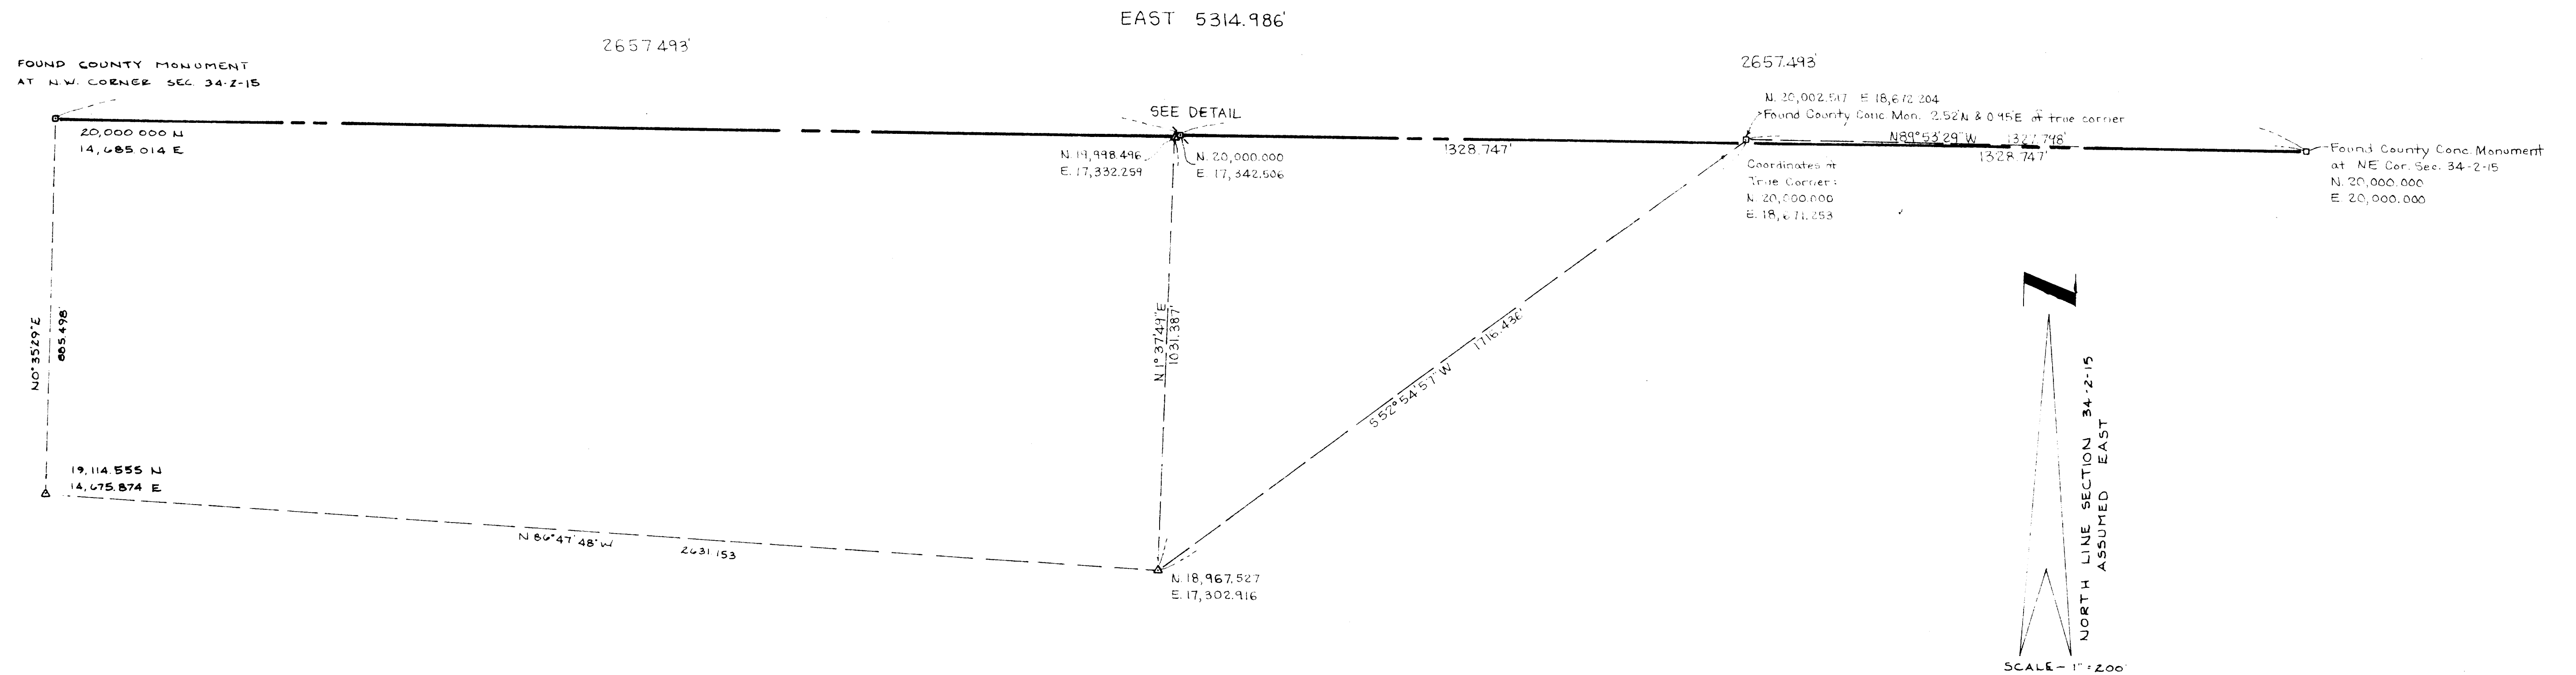

DETAIL

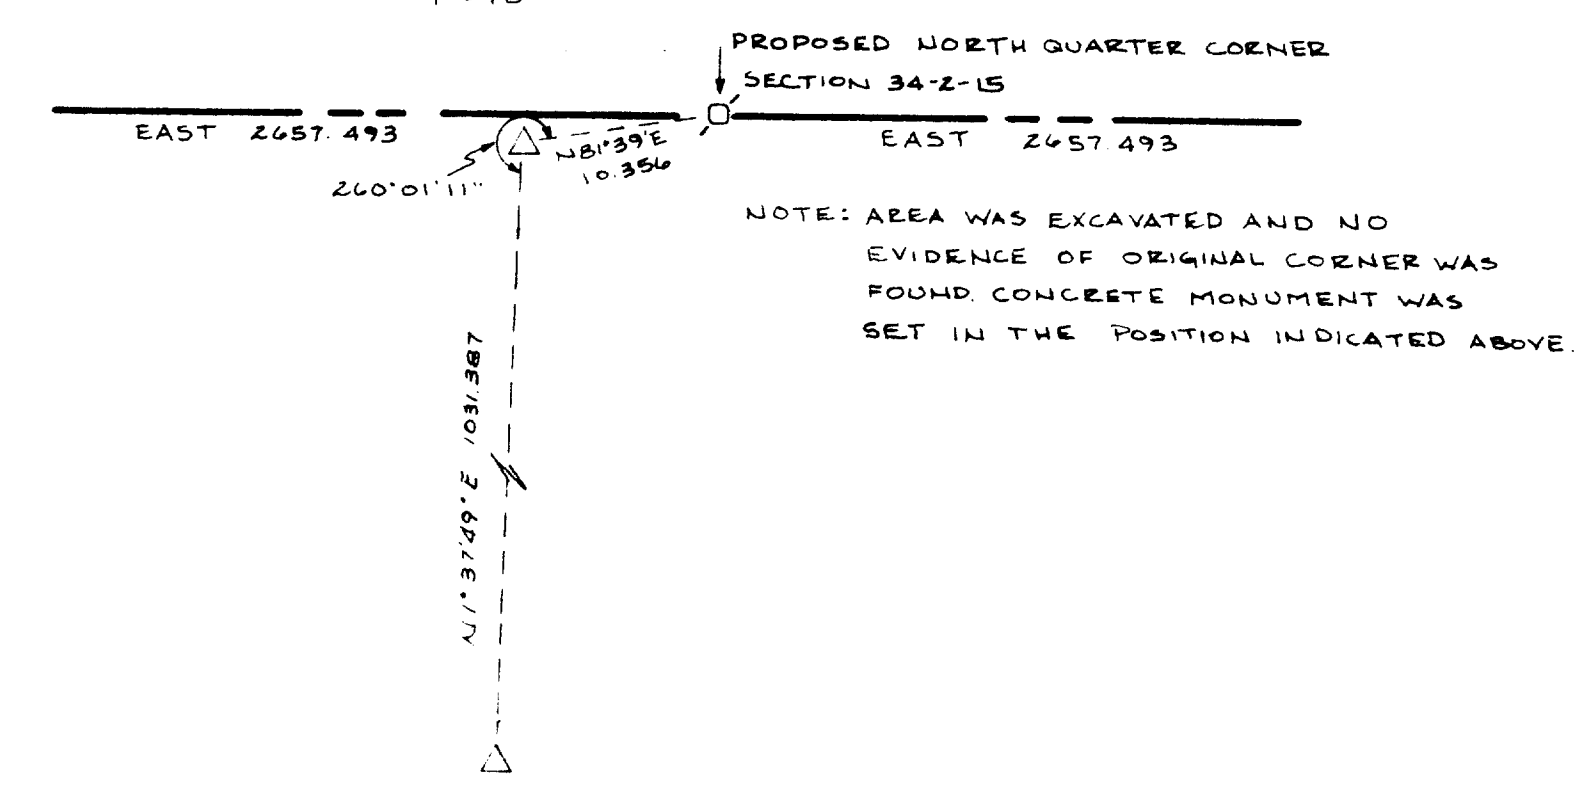

- PROPOSED SECTION CORNER
- FOUND COUNTY MONUMENT
- △ TRAVERSE STATION

Handwritten notes at the bottom left of the page, partially illegible.