


FARRIS, HANSEN & ASSOCIATES, INC.  
7 RIDGEWAY COURT, P.O. BOX 487, ELKHORN, WISCONSIN TELEPHONE 414-723-2096

# PLAT OF SURVEY

LOT 3 OF BLOCK 2 OF BELLA VISTA SUBDIVISION IN THE VILLAGE OF  
DARIEN, WALWORTH COUNTY, WISCONSIN


NEW RESIDENCE FOR: GODINA

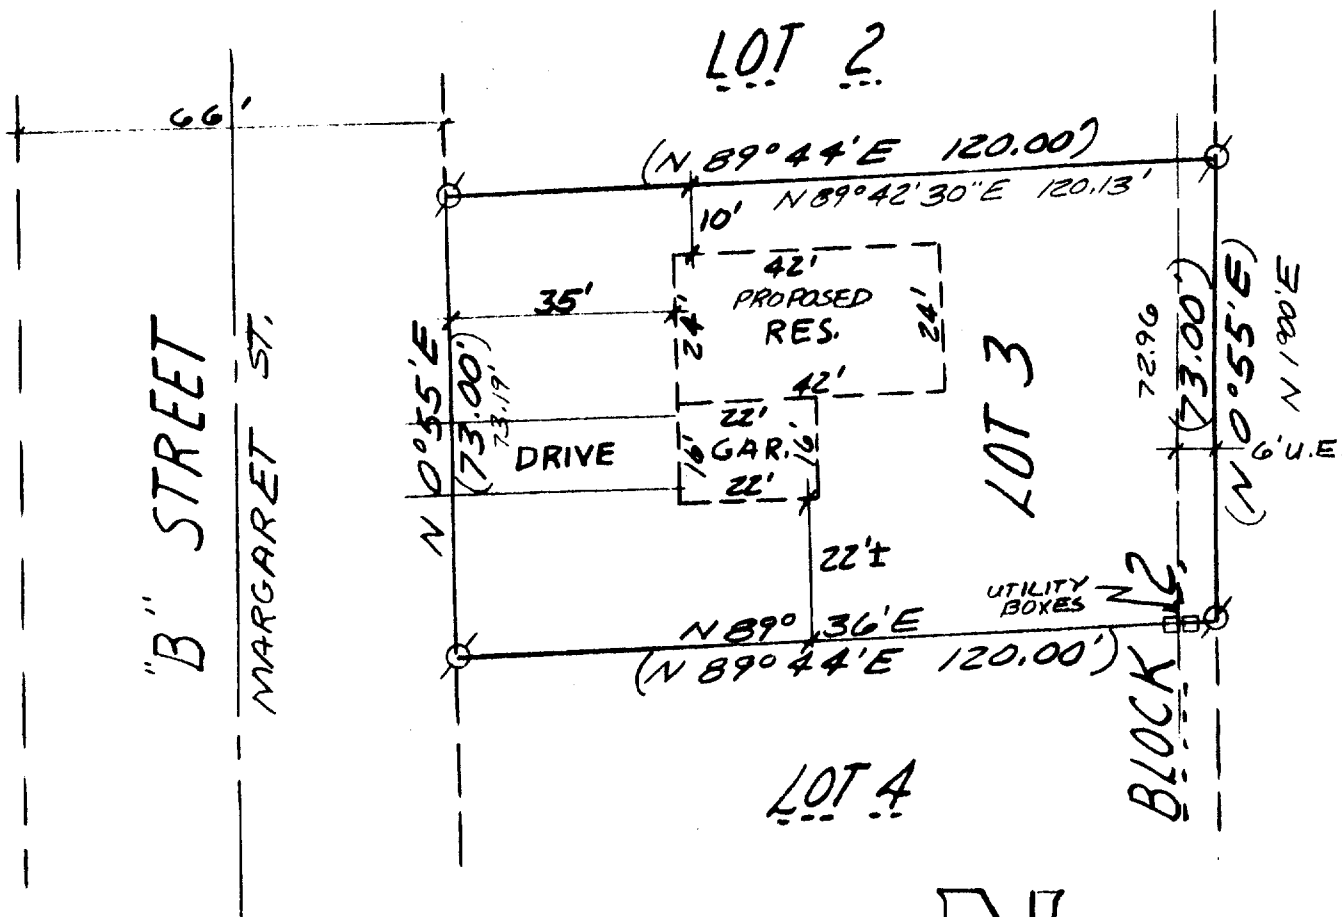

*Robert A. Farris*

I hereby certify this plat to be a true and accurate representation of the boundary lines and of the location of the proposed residence as staked for construction to the best of my professional knowledge and belief. (xxy) = RECORD DIMENSION

Ø = IRON PIPE STAKE FOUND

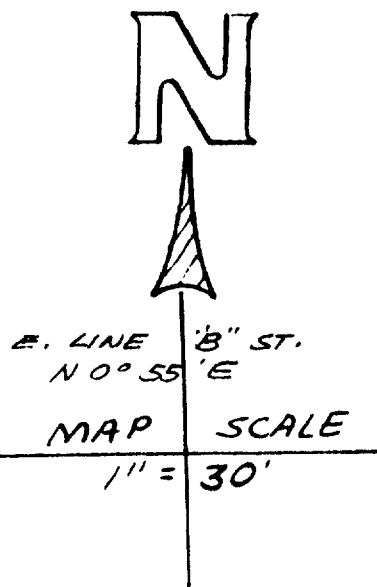

WORK ORDERED BY: SOUTHEASTERN HOUSING

PROJECT NO. 2578-3

DATED MAY 9, 1986

1-185