



COOPER SURVEYING SERVICES
Rural - Residential - Commercial

DANIEL D. COOPER
Registered Land Surveyor

Route 3, Box 255 :: Elkhorn, Wisconsin 53121

Phone (414) 723-6265

SURVEYING & PLANNING
SUBDIVISIONS - LOT SURVEYS
CONSTRUCTION STAKING

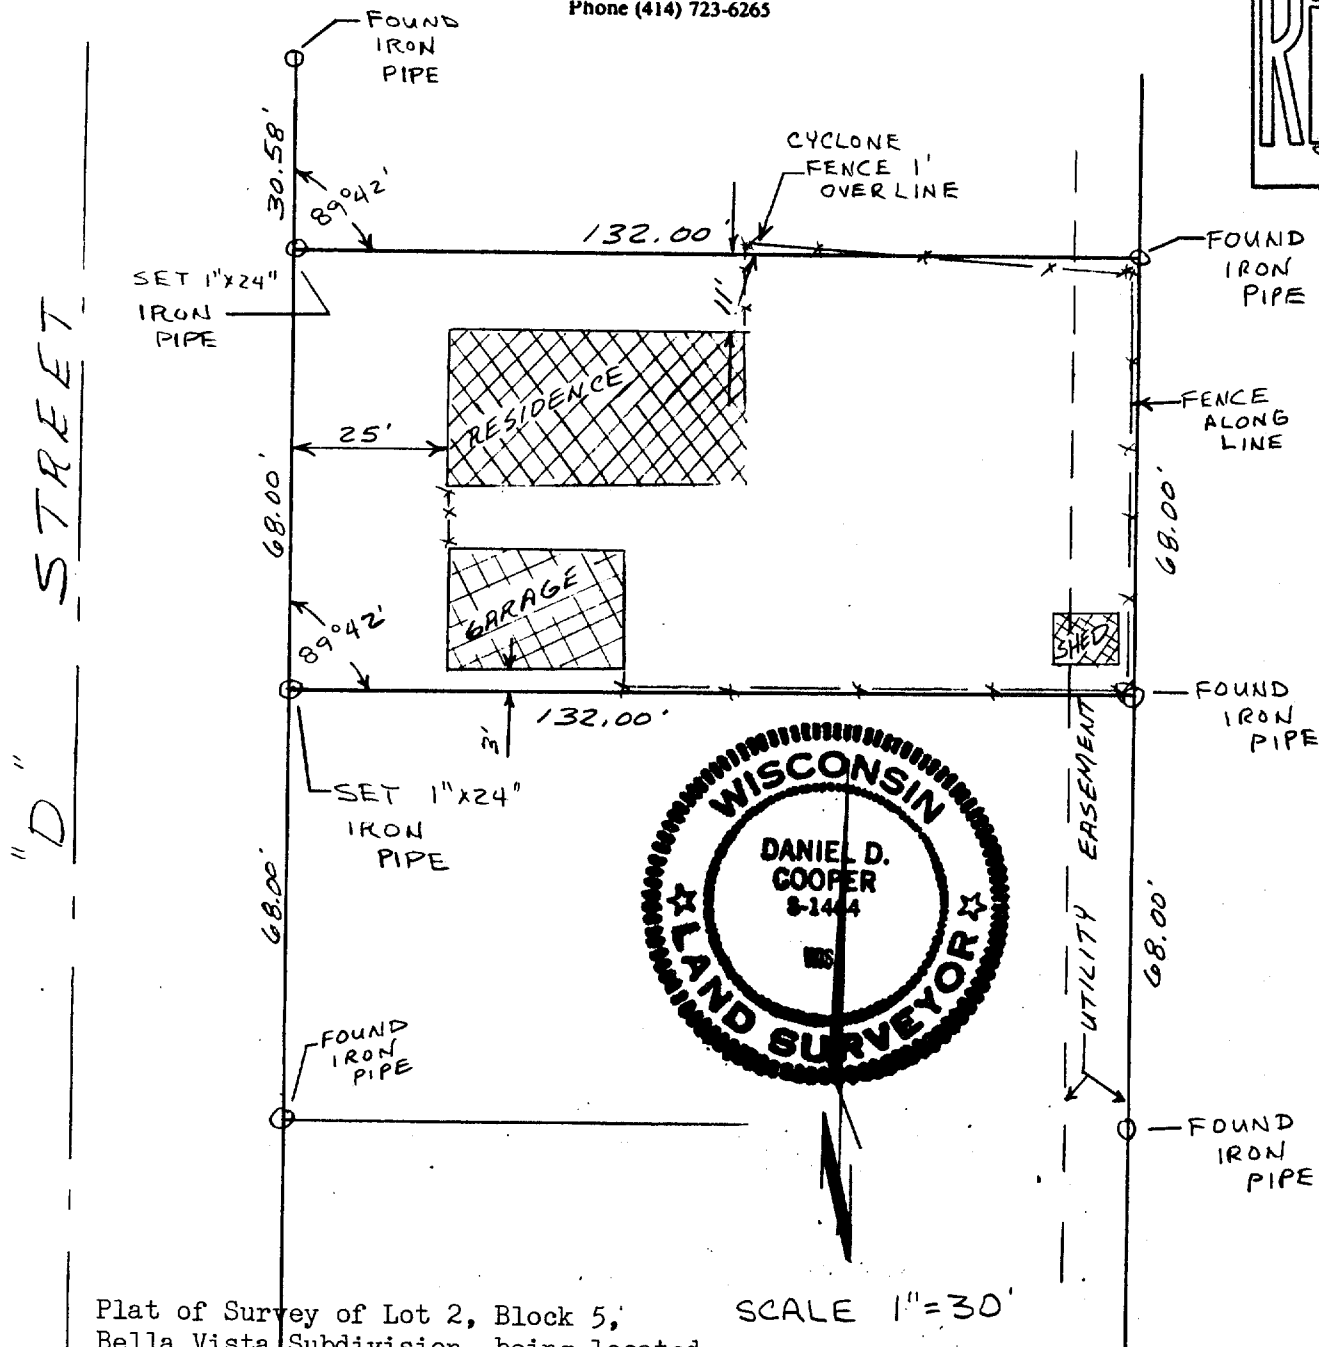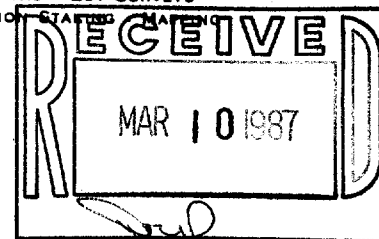

Plat of Survey of Lot 2, Block 5,
Bella Vista Subdivision, being located
in the Village of Darien, Walworth
County Wisconsin.

Work ordered by First State Savings,
Elkhorn Wisconsin

I hereby certify that I have surveyed the
property described hereon and that the above
map is a true and accurate representation
therof to the best of my professional
knowledge and belief..

Dated this 30 day of Sept, 1983

Daniel D. Cooper
Daniel D. Cooper, RLS No. 8-1464

DRAWING NO. 1873

Tax Parcel QB 00038