


Fence on center
line of Alley

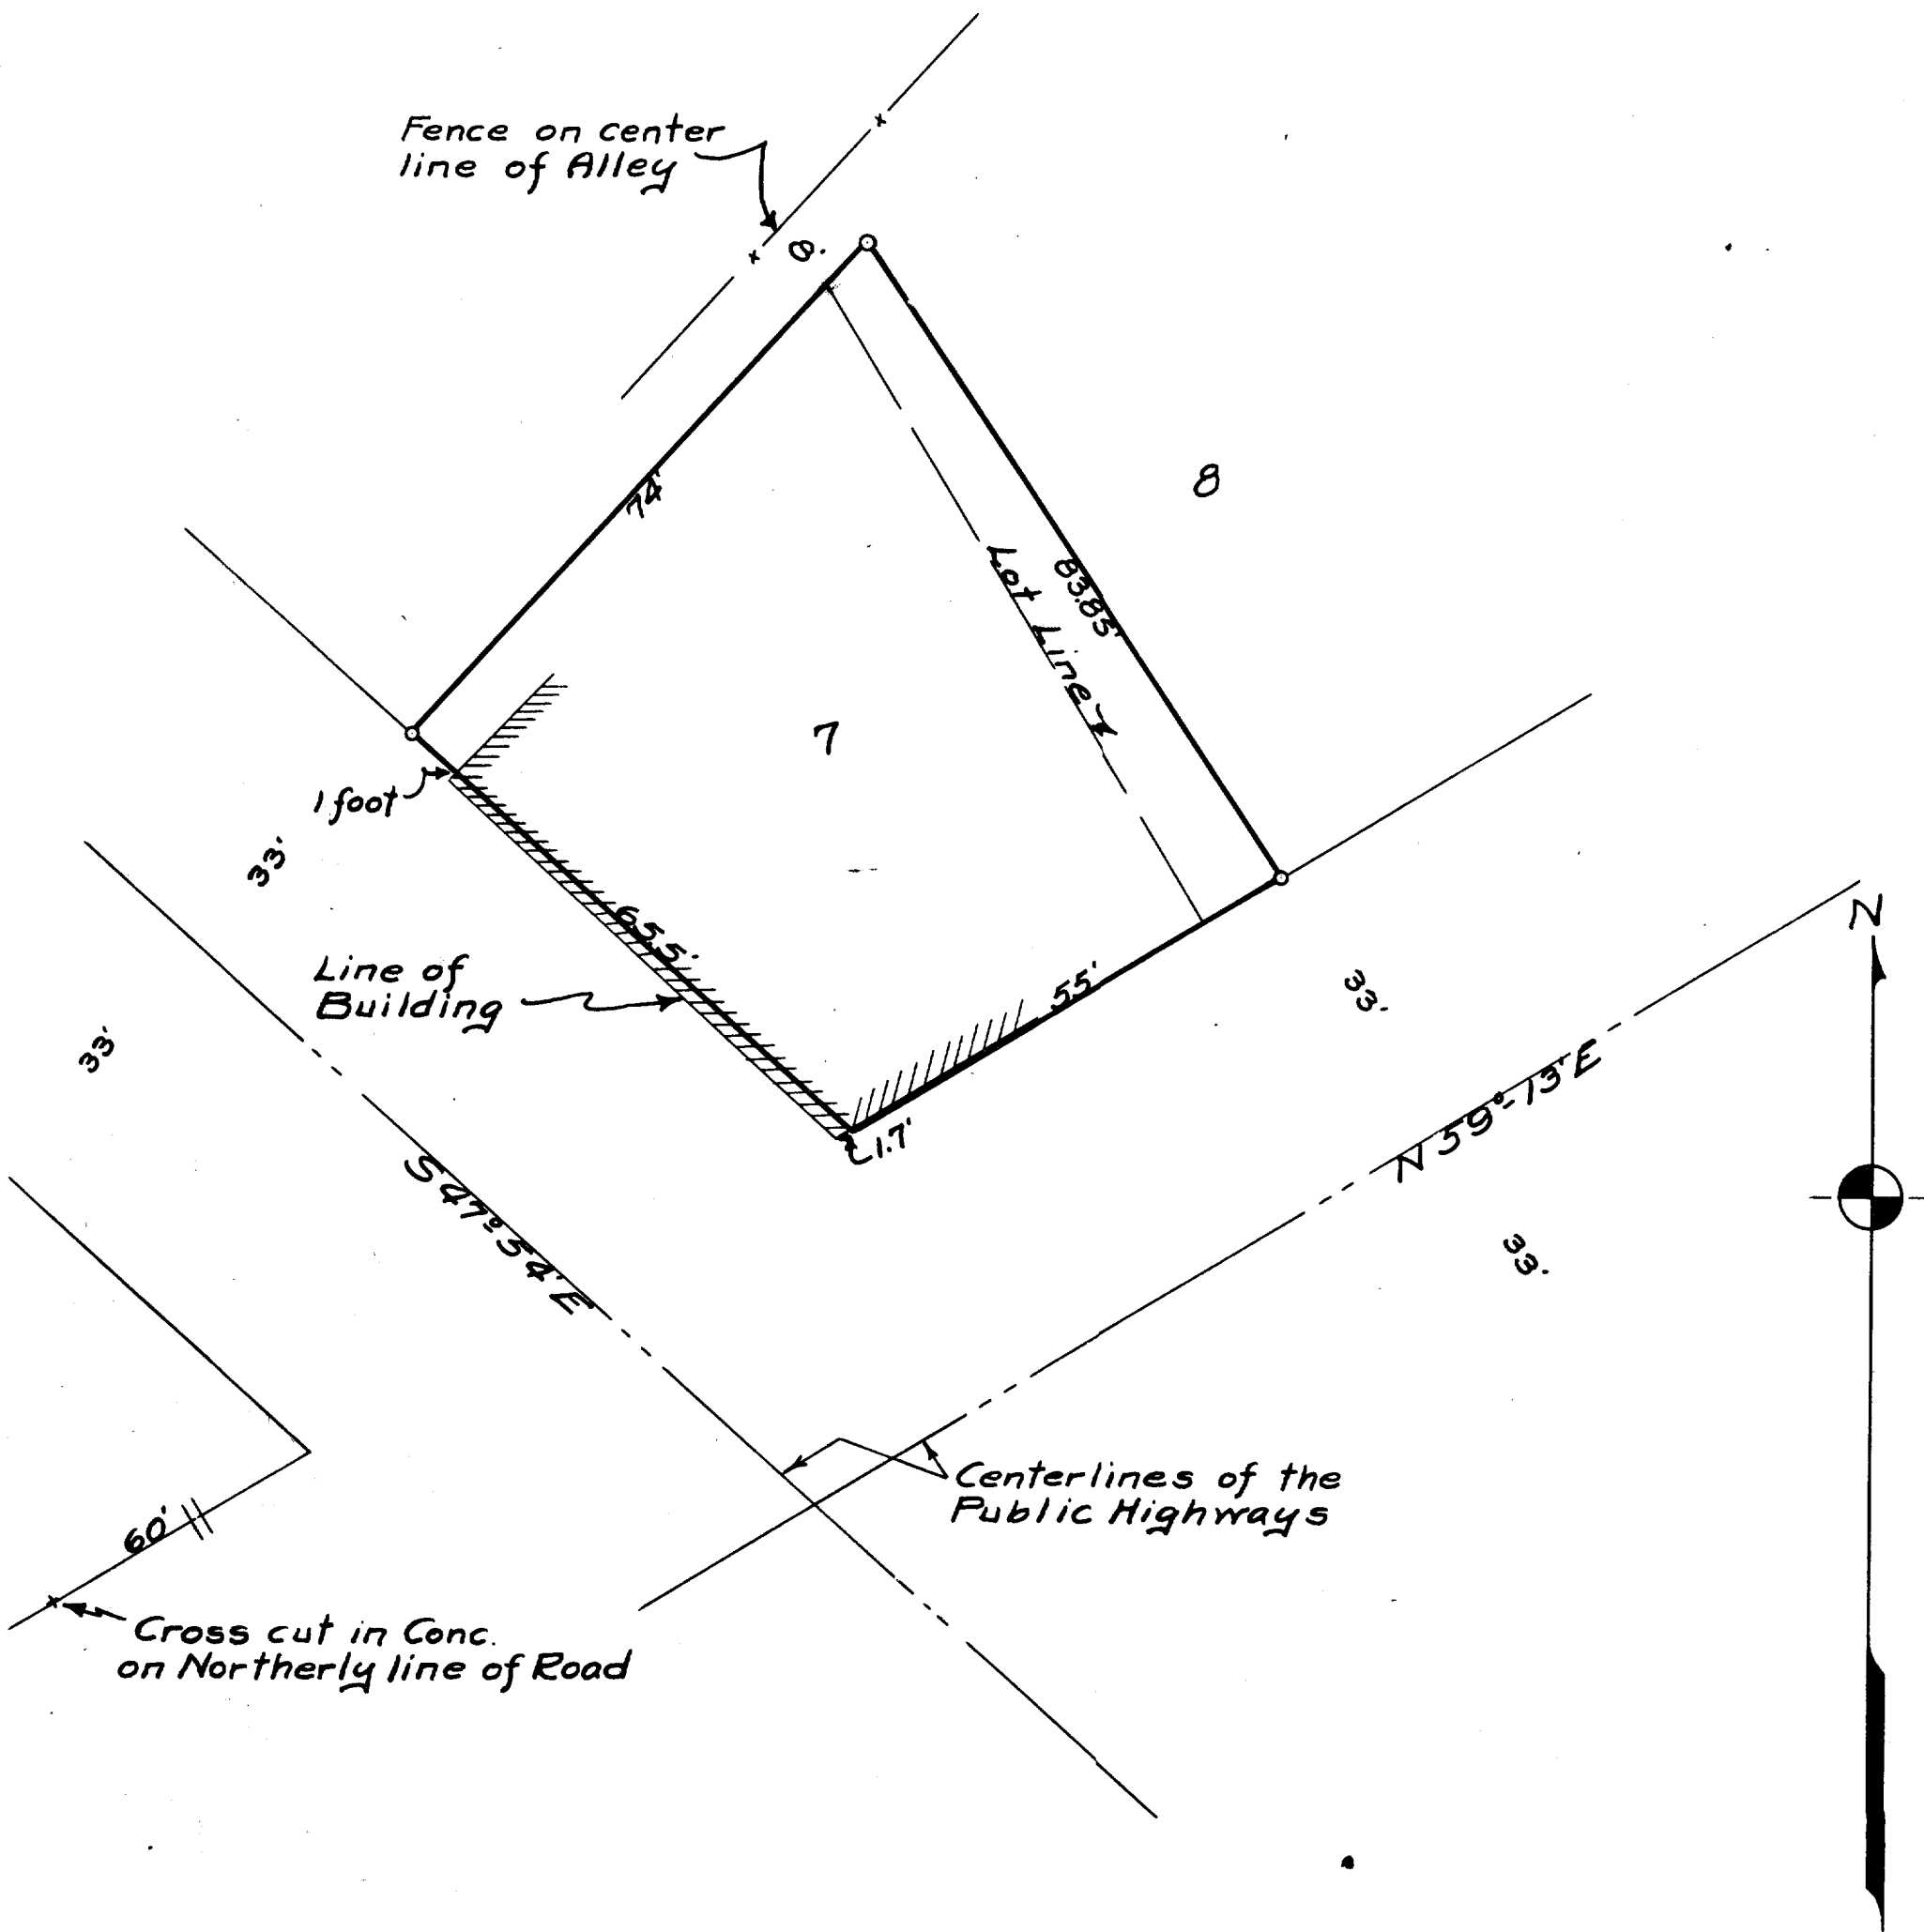

LEGEND

Scale 1"=20'

o-Iron Stake

PLAT OF SURVEY

Lot 7 and part of Lot 8 of Block 21 of
Frey's Addition to Darien, Walworth Co.
Wisconsin.

Dec. 1935

Lloyd J. Jensen
County Surveyor