


**SURVEYING & SUBDIVIDING
DELAN, WISCONSIN 53115**

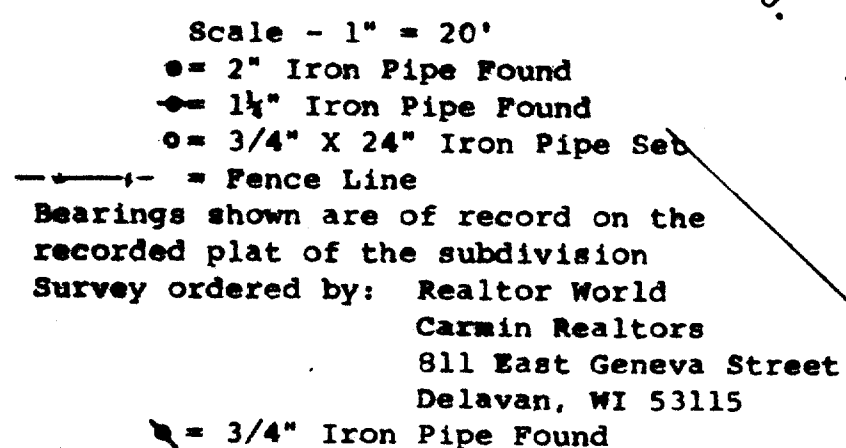

RECEIVED
AUG 29 1988