


MADISON

S T R E E T

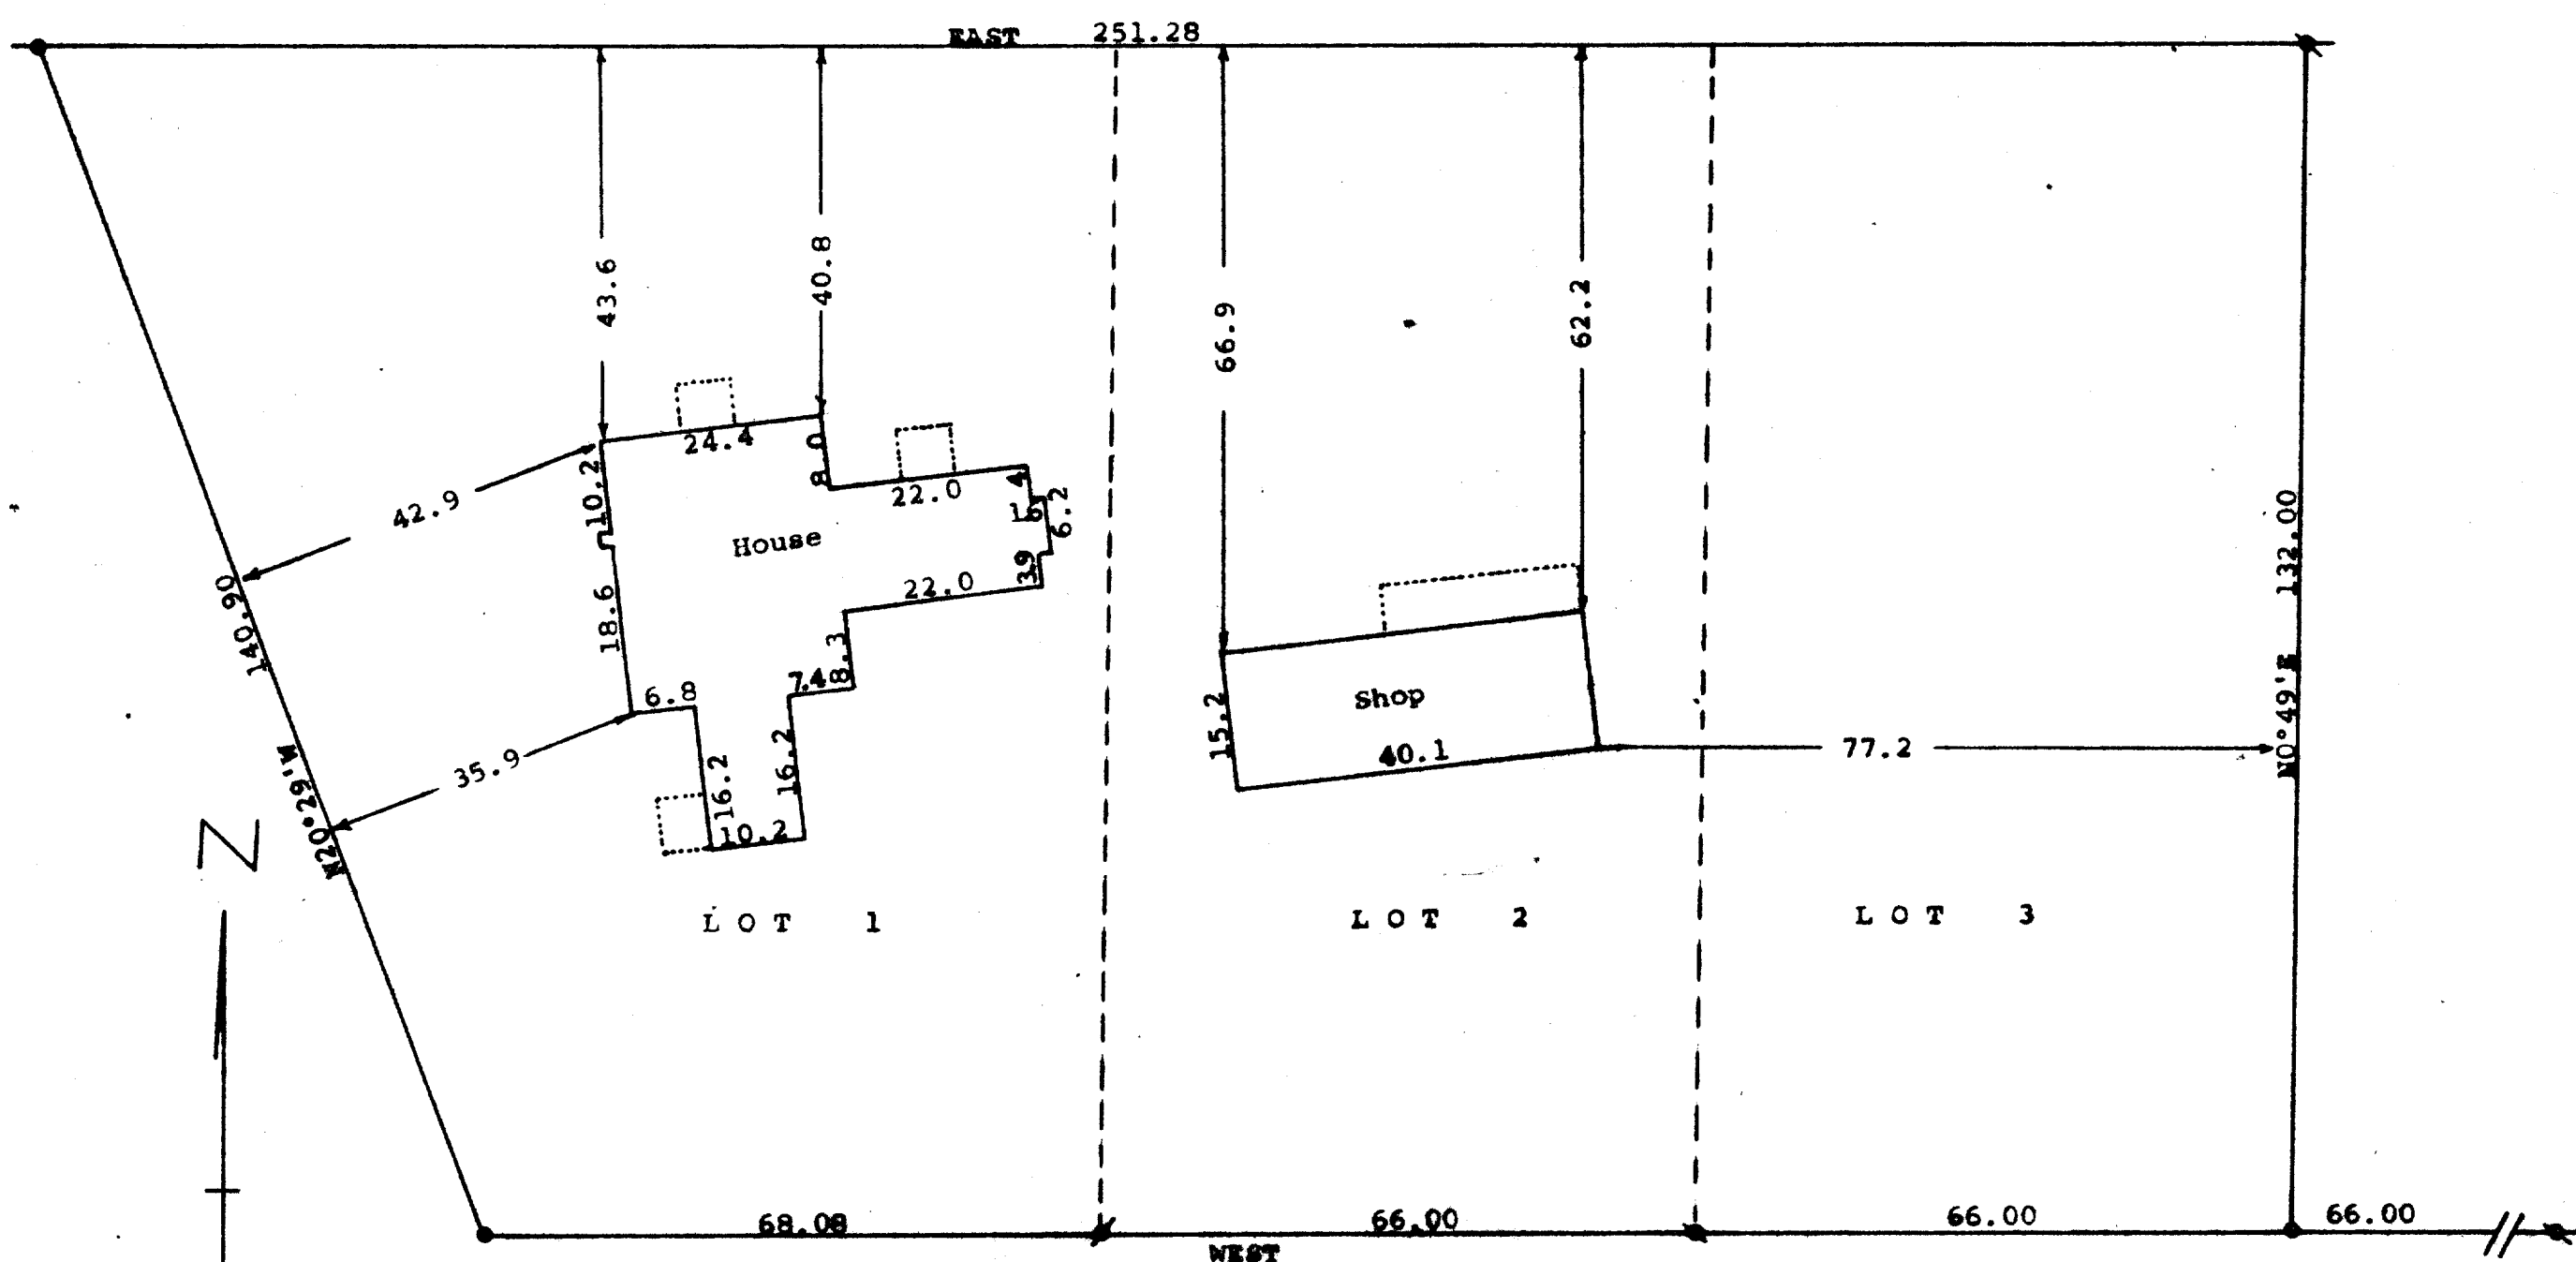

RECEIVED
NOV 9 1988

George T. Dunham, Surveyor

