


DUNHAM SURVEYING, S. C.  
SURVEYING & SUBDIVIDING  
DELAVAN, WISCONSIN 53115

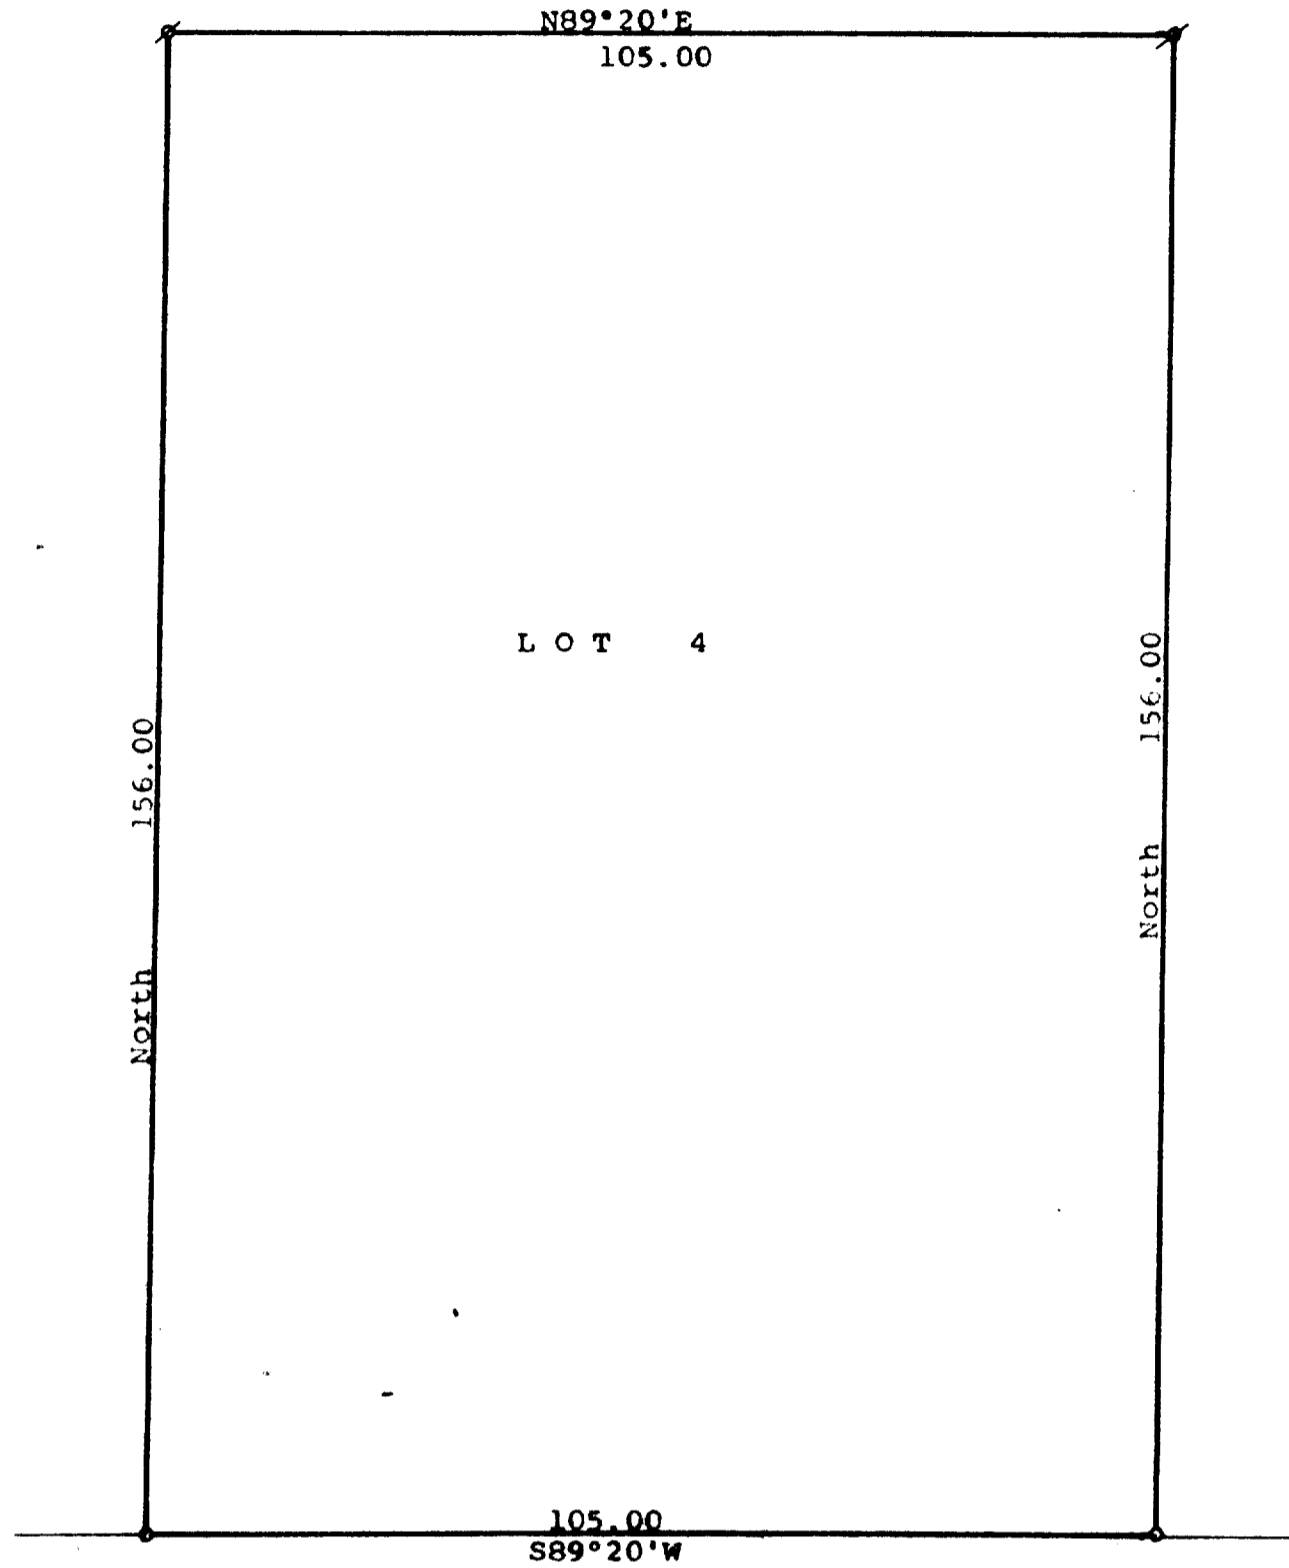

N

Scale - 1" = 20'  
o = 1" Iron Pipe Found  
p = 1/4" Iron Pipe Found  
Bearings are those on the recorded plat of  
CSM No. 357  
Survey ordered by: Danielson & Osman Realty  
25 N. Wisconsin Street  
Darien, WI 53114



WASHINGTON

STREET

STATE OF WISCONSIN)  
COUNTY OF WALWORTH)

I, George T. Dunham, Surveyor, certify that I have surveyed the property described as follows:  
Lot 4 of Certified Survey No. 357 recorded in Volume 2 of Certified Surveys on Page 137, Office of the Register of Deeds, being a parcel of land located in the Northwest 1/4 of Section 27, T 2 N, R 15 E, Village of Darien, Walworth County, Wisconsin and that the plat hereon is a correct representation thereof and shows the size and location of the property, its exterior boundaries, the location of all visible structures and dimensions of all principal buildings thereon, boundary fences, apparent easements, roadways and visible encroachments, if any, and that I have surveyed the property hereon described, according to the official records, to the best of my knowledge and belief.  
December 5, 1989

*George T. Dunham*  
George T. Dunham, Surveyor

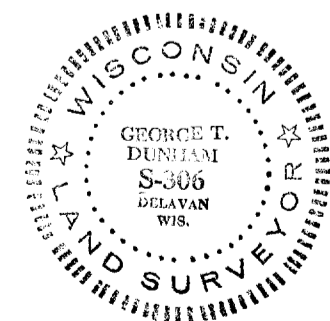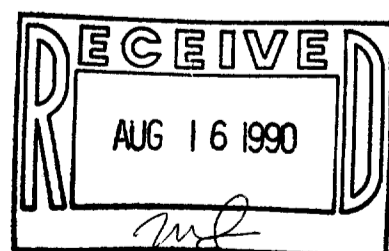

TAX KEY # QA-357-4

SURVEY # 1-232