
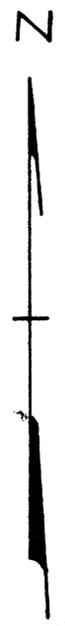


DUNHAM SURVEYING, S. C.  
 SURVEYING & SUBDIVIDING  
 DELAVAN, WISCONSIN 53115

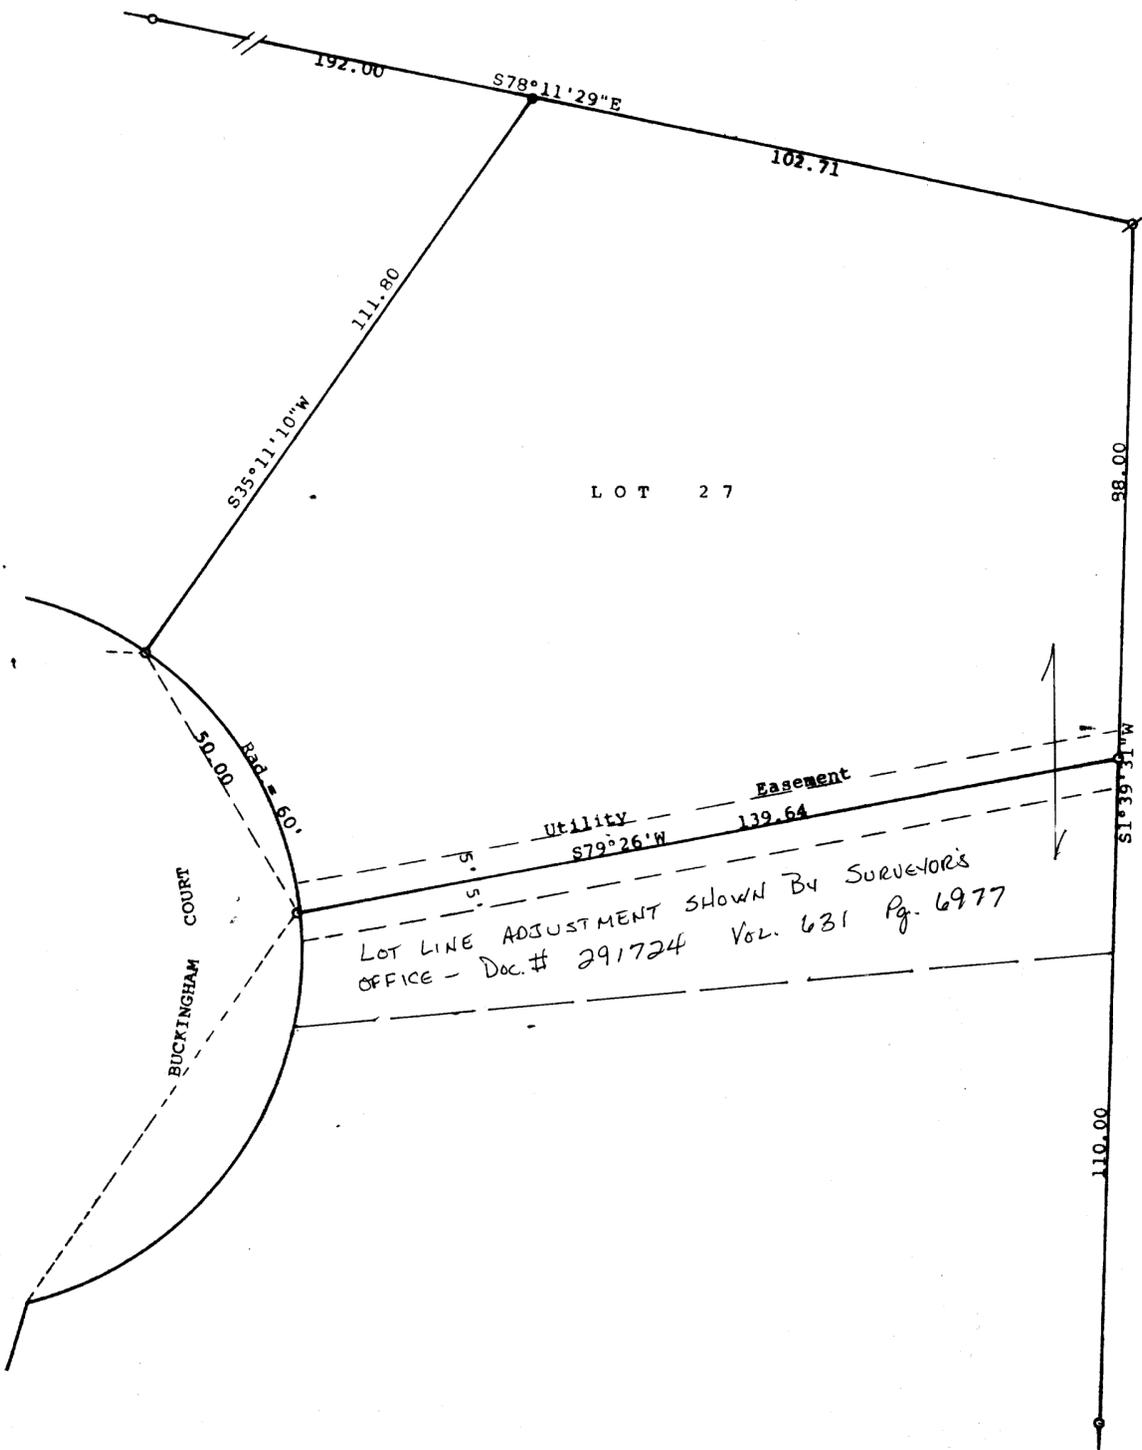

Scale - 1" = 20'  
 ○ = Iron Rod Found  
 ⌀ = 3/4" Iron Pipe Found  
 ● = Iron Rod Found Laying Down.  
 Set at lot corner

Bearings are those on the recorded plat of  
 Oak Ridge Subdivision  
 Survey ordered by: Danielson & Osman Realty  
 27 North Wisconsin  
 Darien, WI 53114

LOT LINE ADJUSTMENT SHOWN BY SURVEYOR'S  
 OFFICE - Doc. # 291724 Vol. 631 Pg. 6977

STATE OF WISCONSIN)  
 COUNTY OF WALWORTH) ss  
 I, George T. Dunham, Surveyor, certify that I have surveyed the  
 property described as follows:  
 Lot 27 in Oak Ridge Subdivision located in the Village of Darien,  
 Walworth County, Wisconsin,  
 and that the plat shown hereon is a correct representation thereof and shows  
 the size and location of the property, its exterior boundaries, the location  
 of all visible structures and dimensions of all principal buildings thereon,  
 boundary fences, apparent easements, roadways and visible encroachments, if  
 any, and that I have surveyed the property hereon described, according to the  
 official records, to the best of my knowledge and belief.  
 December 2, 1992

*George T. Dunham*  
 George T. Dunham, Surveyor

