


**ABELL  
SURVEYING & MAPPING  
DELAVER, WISCONSIN 53115  
414-728-6737**

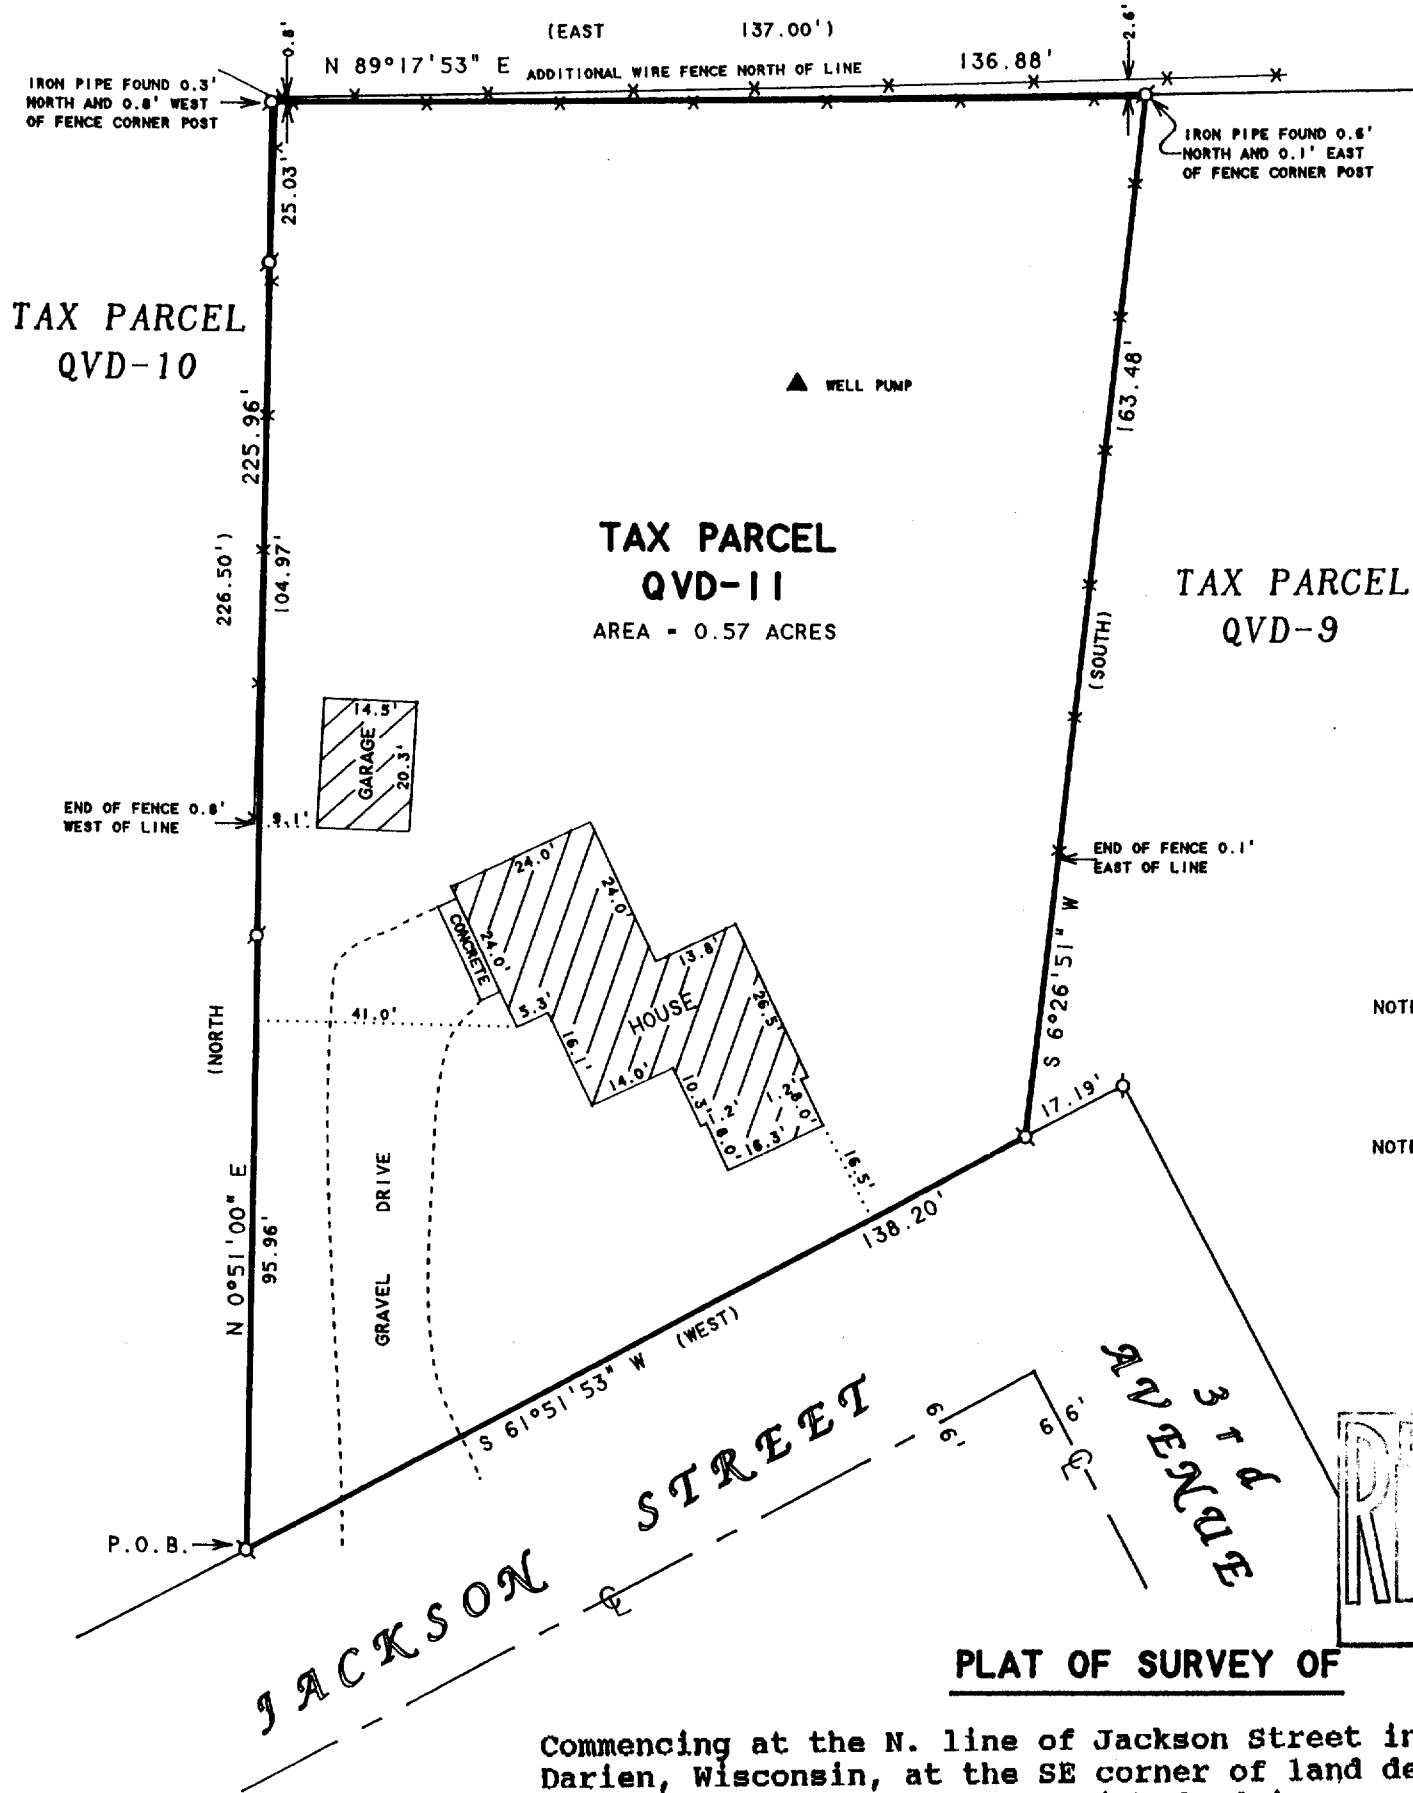

NOTE: BEARINGS ARE REFERENCED TO EXISTING SURVEY RECORDS.

NOTE: LOCATION OF DRIVEWAY IS APPROXIMATE DUE TO SNOW COVER ON DATE OF SURVEY.

ORDERED BY: DANIELSON & OSMAN REALTY  
23 WISCONSIN STREET  
DARIEN, WI 53114

Tax Key Number: QVD 00011



LEGEND  
 ○ - IRON PIPE FOUND  
 \* - WIRE FENCE  
 ( ) - RECORDED AS

Commencing at the N. line of Jackson Street in the Village of Darien, Wisconsin, at the SE corner of land deeded by I. N. Waite and wife, to Jacob Hoffman which deed is on record in the office of the Register of Deeds in and for Walworth County, Wisconsin, being recorded Dec. 15, 1869 in Vol. 47 of Deeds on page 439; running thence N. along the E. line of aforesaid Hoffman land 13 rods and 12 feet, thence E. 8 rods and 5 feet, thence S. to the N. line of Jackson Street, thence W. along the N. line of Jackson Street to the place of beginning.

I HEREBY CERTIFY THAT I HAVE SURVEYED THE ABOVE DESCRIBED PROPERTY AND THAT THE ABOVE MAP IS A TRUE REPRESENTATION THEREOF AND SHOWS THE SIZE AND LOCATION OF THE PROPERTY, ITS EXTERIOR BOUNDARIES, THE LOCATION OF ALL VISIBLE STRUCTURES AND DIMENSIONS OF ALL PRINCIPAL BUILDINGS THEREON, BOUNDARY FENCES, APPARENT EASEMENTS, ROADWAYS AND VISIBLE ENCROACHMENTS, IF ANY, TO THE BEST OF MY KNOWLEDGE AND BELIEF.

THIS SURVEY IS MADE FOR THE USE OF THE PRESENT OWNERS OF THE PROPERTY, AND ALSO THOSE WHO PURCHASE, MORTGAGE, OR GUARANTEE THE TITLE THERETO WITHIN ONE (1) YEAR FROM DATE HEREON.

*David F. Abell*

DAVID F. ABELL  
WISCONSIN REGISTERED LAND SURVEYOR, S-1596

*December 14, 1994*

DATE: December 14, 1994 JOB NUMBER - 94224  
NOTE: THIS IS NOT A CERTIFIED COPY UNLESS SEALED.