
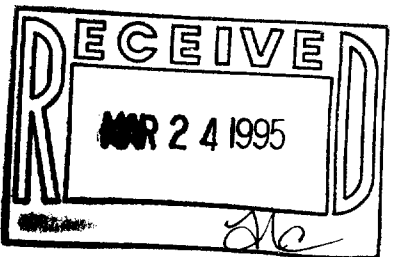
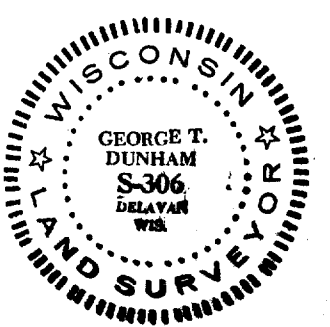


**DUNHAM SURVEYING, S.C.**  
SURVEYING & ENGINEERING  
DARIEN, WISCONSIN 53114

N

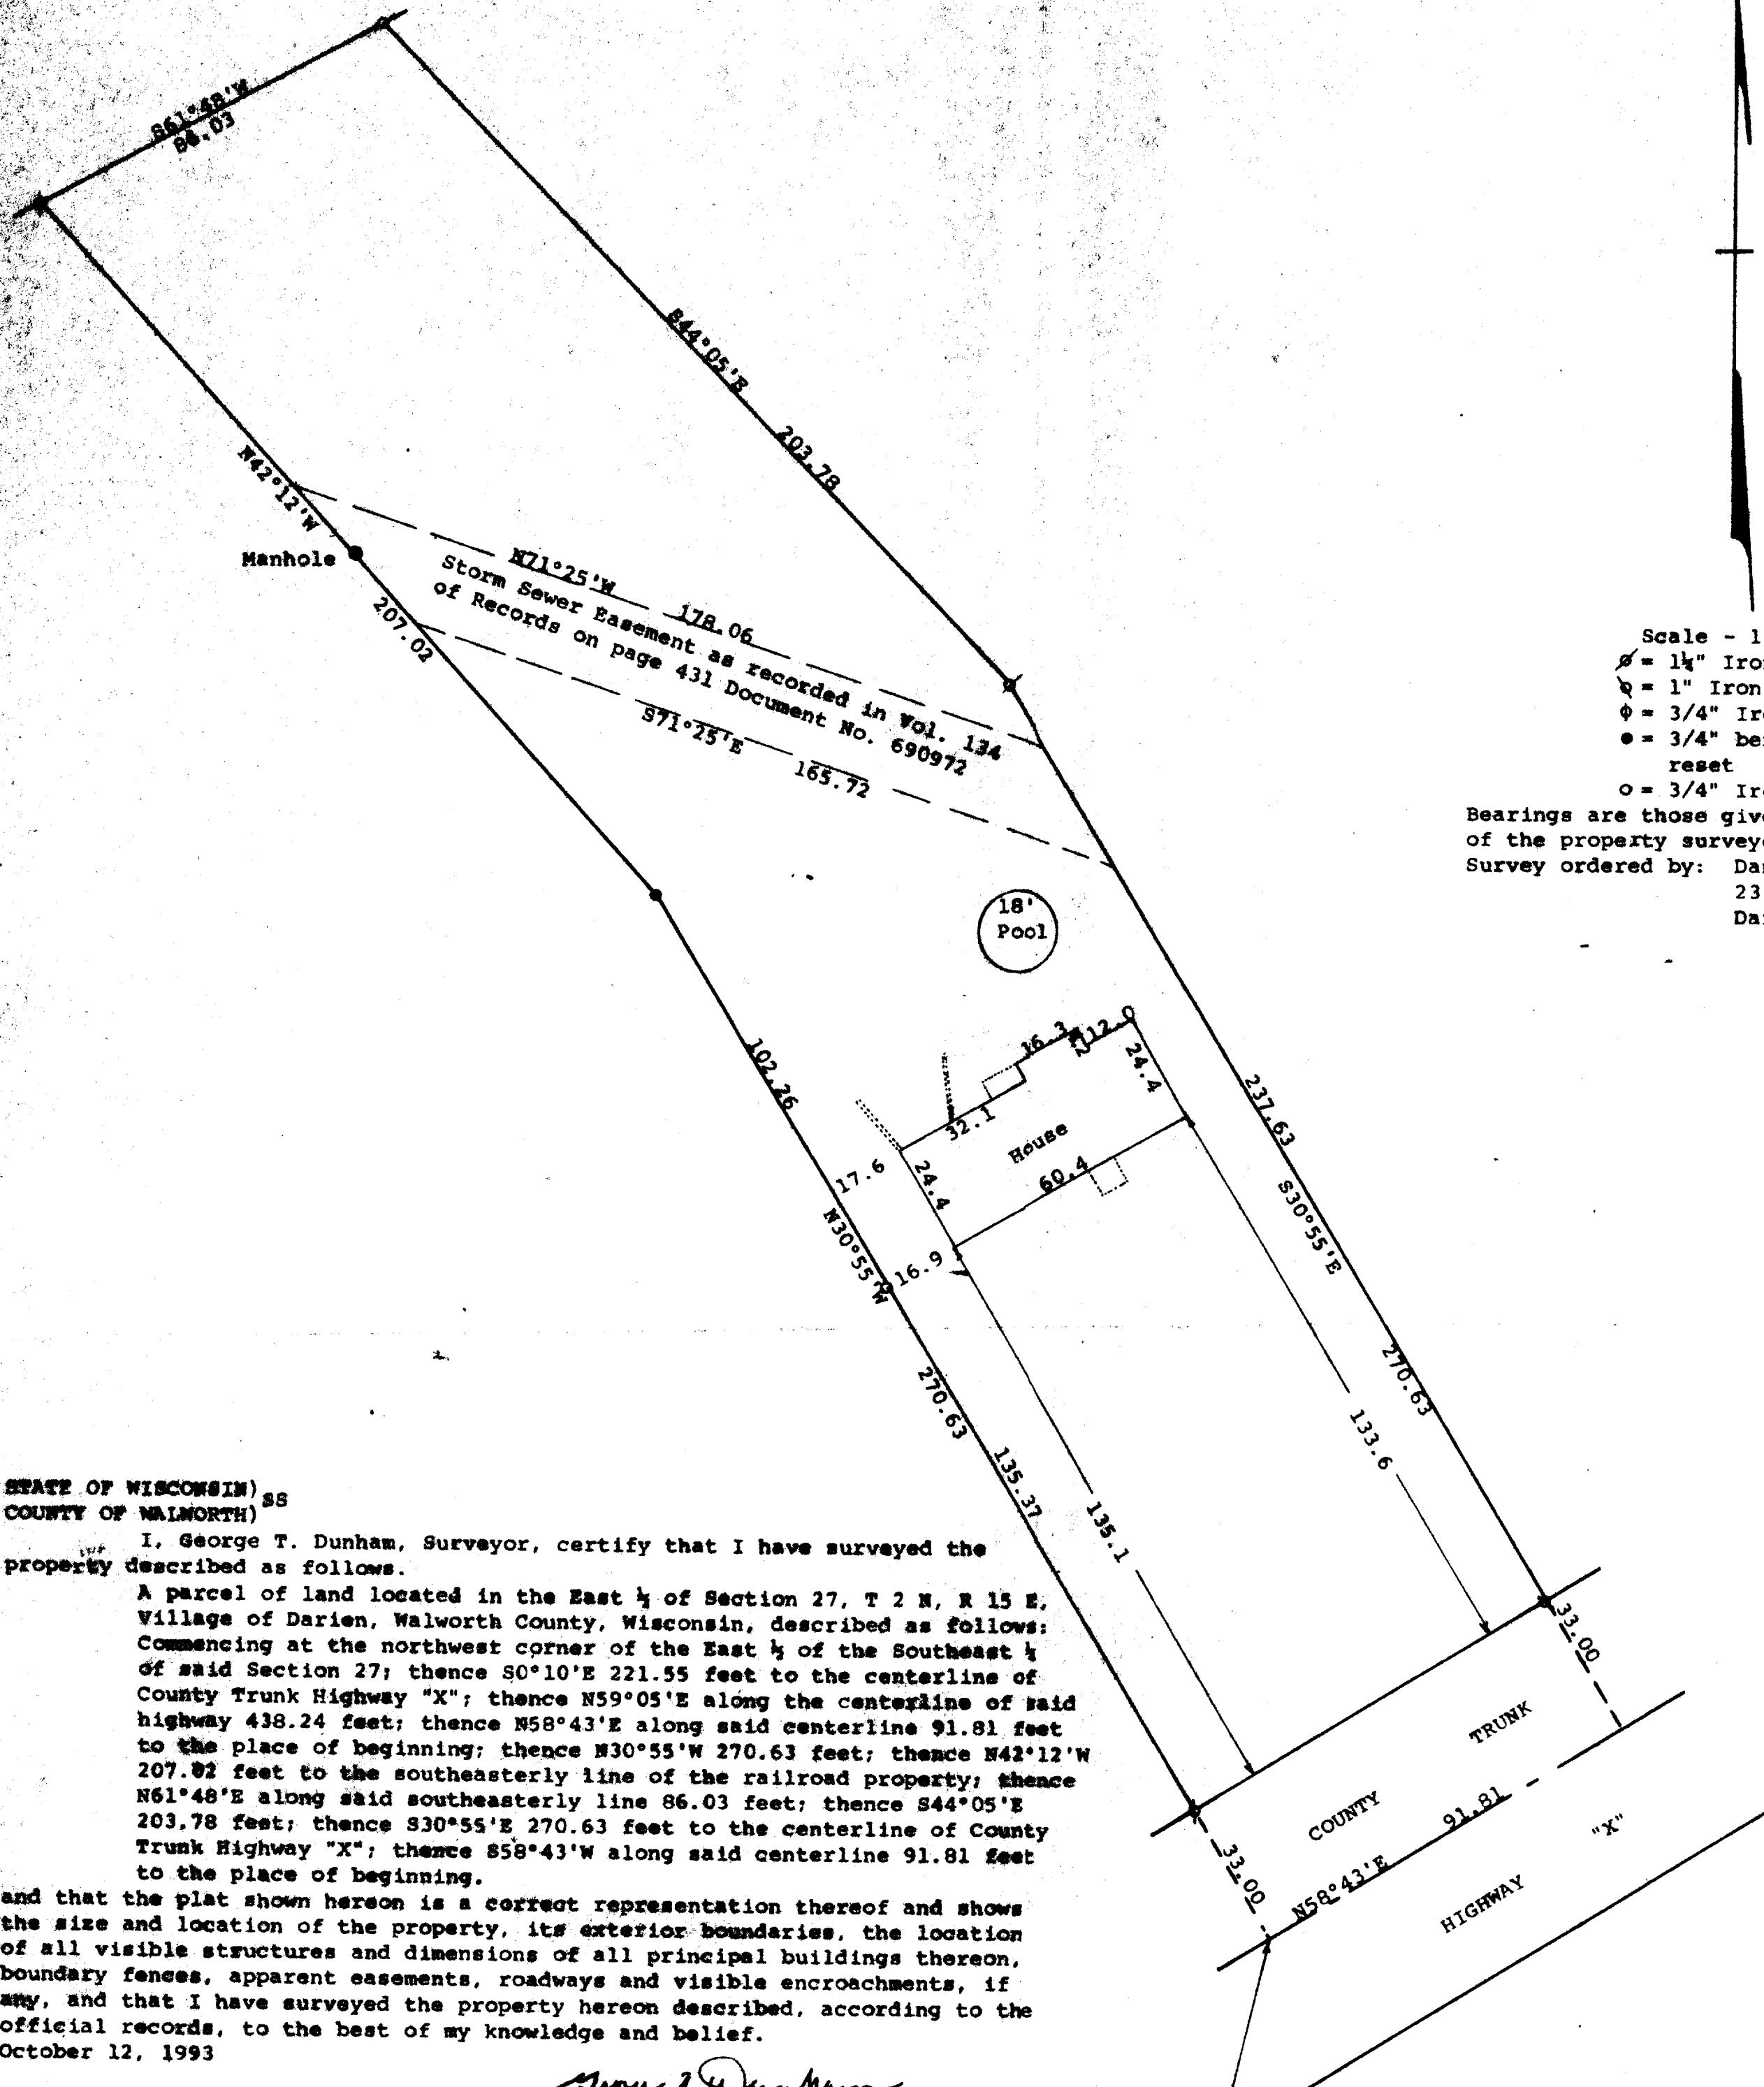

QUD-4

001-300