
## ABELL SURVEYING & MAPPING DELAVAN, WISCONSIN 53115 414-728-6737

JEFFERSON

66' WIDE

STREET

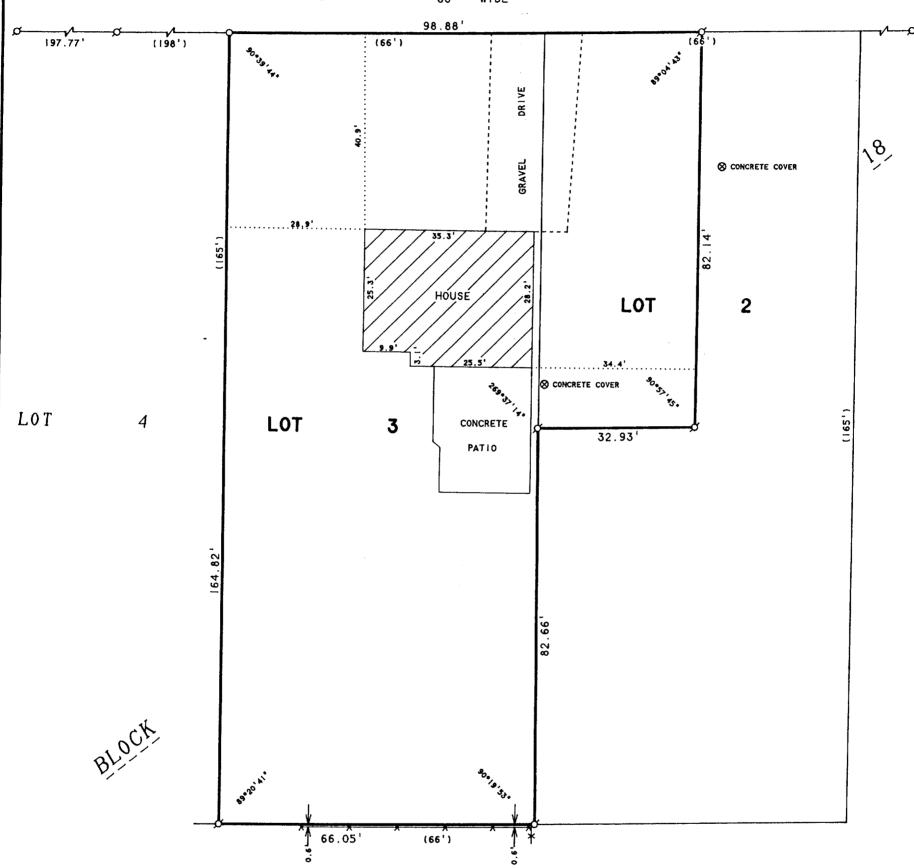

ORDERED BY: DANIELSON & OSMAN REALTY
23 N. WISCONSIN
DARIEN, WI 53114

## PLAT OF SURVEY OF

THE WEST 1/2 OF THE NORTH 1/2 OF LOT 2. BLOCK 18 AND LOT 3. BLOCK 18. STONE AND TOPPING ADDITION TO THE VILLAGE OF DARIEN, WALWORTH COUNTY, WISCONSIN.

N



SCALE | " = 20 '

LEGEND

Ø -IRON PIPE FOUND
O -IRON ROD SET
X -WOOD FENCE
( )-RECORDED AS

I HEREBY CERTIFY THAT I HAVE SURVEYED THE ABOVE DESCRIBED PROPERTY AND THAT THE ABOVE MAP IS A TRUE REPRESENTATION THEREOF AND SHOWS THE SIZE AND LOCATION OF THE PROPERTY, ITS EXTERIOR BOUNDARIES, THE LOCATION OF ALL VISIBLE STRUCTURES AND DIMENSIONS OF ALL PRINCIPAL BUILDINGS THEREON, BOUNDARY FENCES, APPARENT EASEMENTS, ROADWAYS AND VISIBLE ENCROACHMENTS, IF ANY, TO THE BEST OF MY KNOWLEDGE AND BELIEF.

THIS SURVEY IS MADE FOR THE USE OF THE PRESENT OWNERS OF THE PROPERTY, AND ALSO THOSE WHO PURCHASE, MORTGAGE, OR GUARANTEE THE TITLE THERETO WITHIN ONE (I) YEAR FROM DATE HEREON.

David 7. Stell

DAVID F. ABELL WISCONSIN REGISTERED LAND SURVEYOR, S-1596 August 9, 1995

DATE NOTE: THIS IS NOT A CERTIFIED COPY UNLESS SEALED.

QSaT-35A