


GEORGE T. DUNHAM  
SURVEYING & SUBDIVIDING  
DELAVAN, WISCONSIN

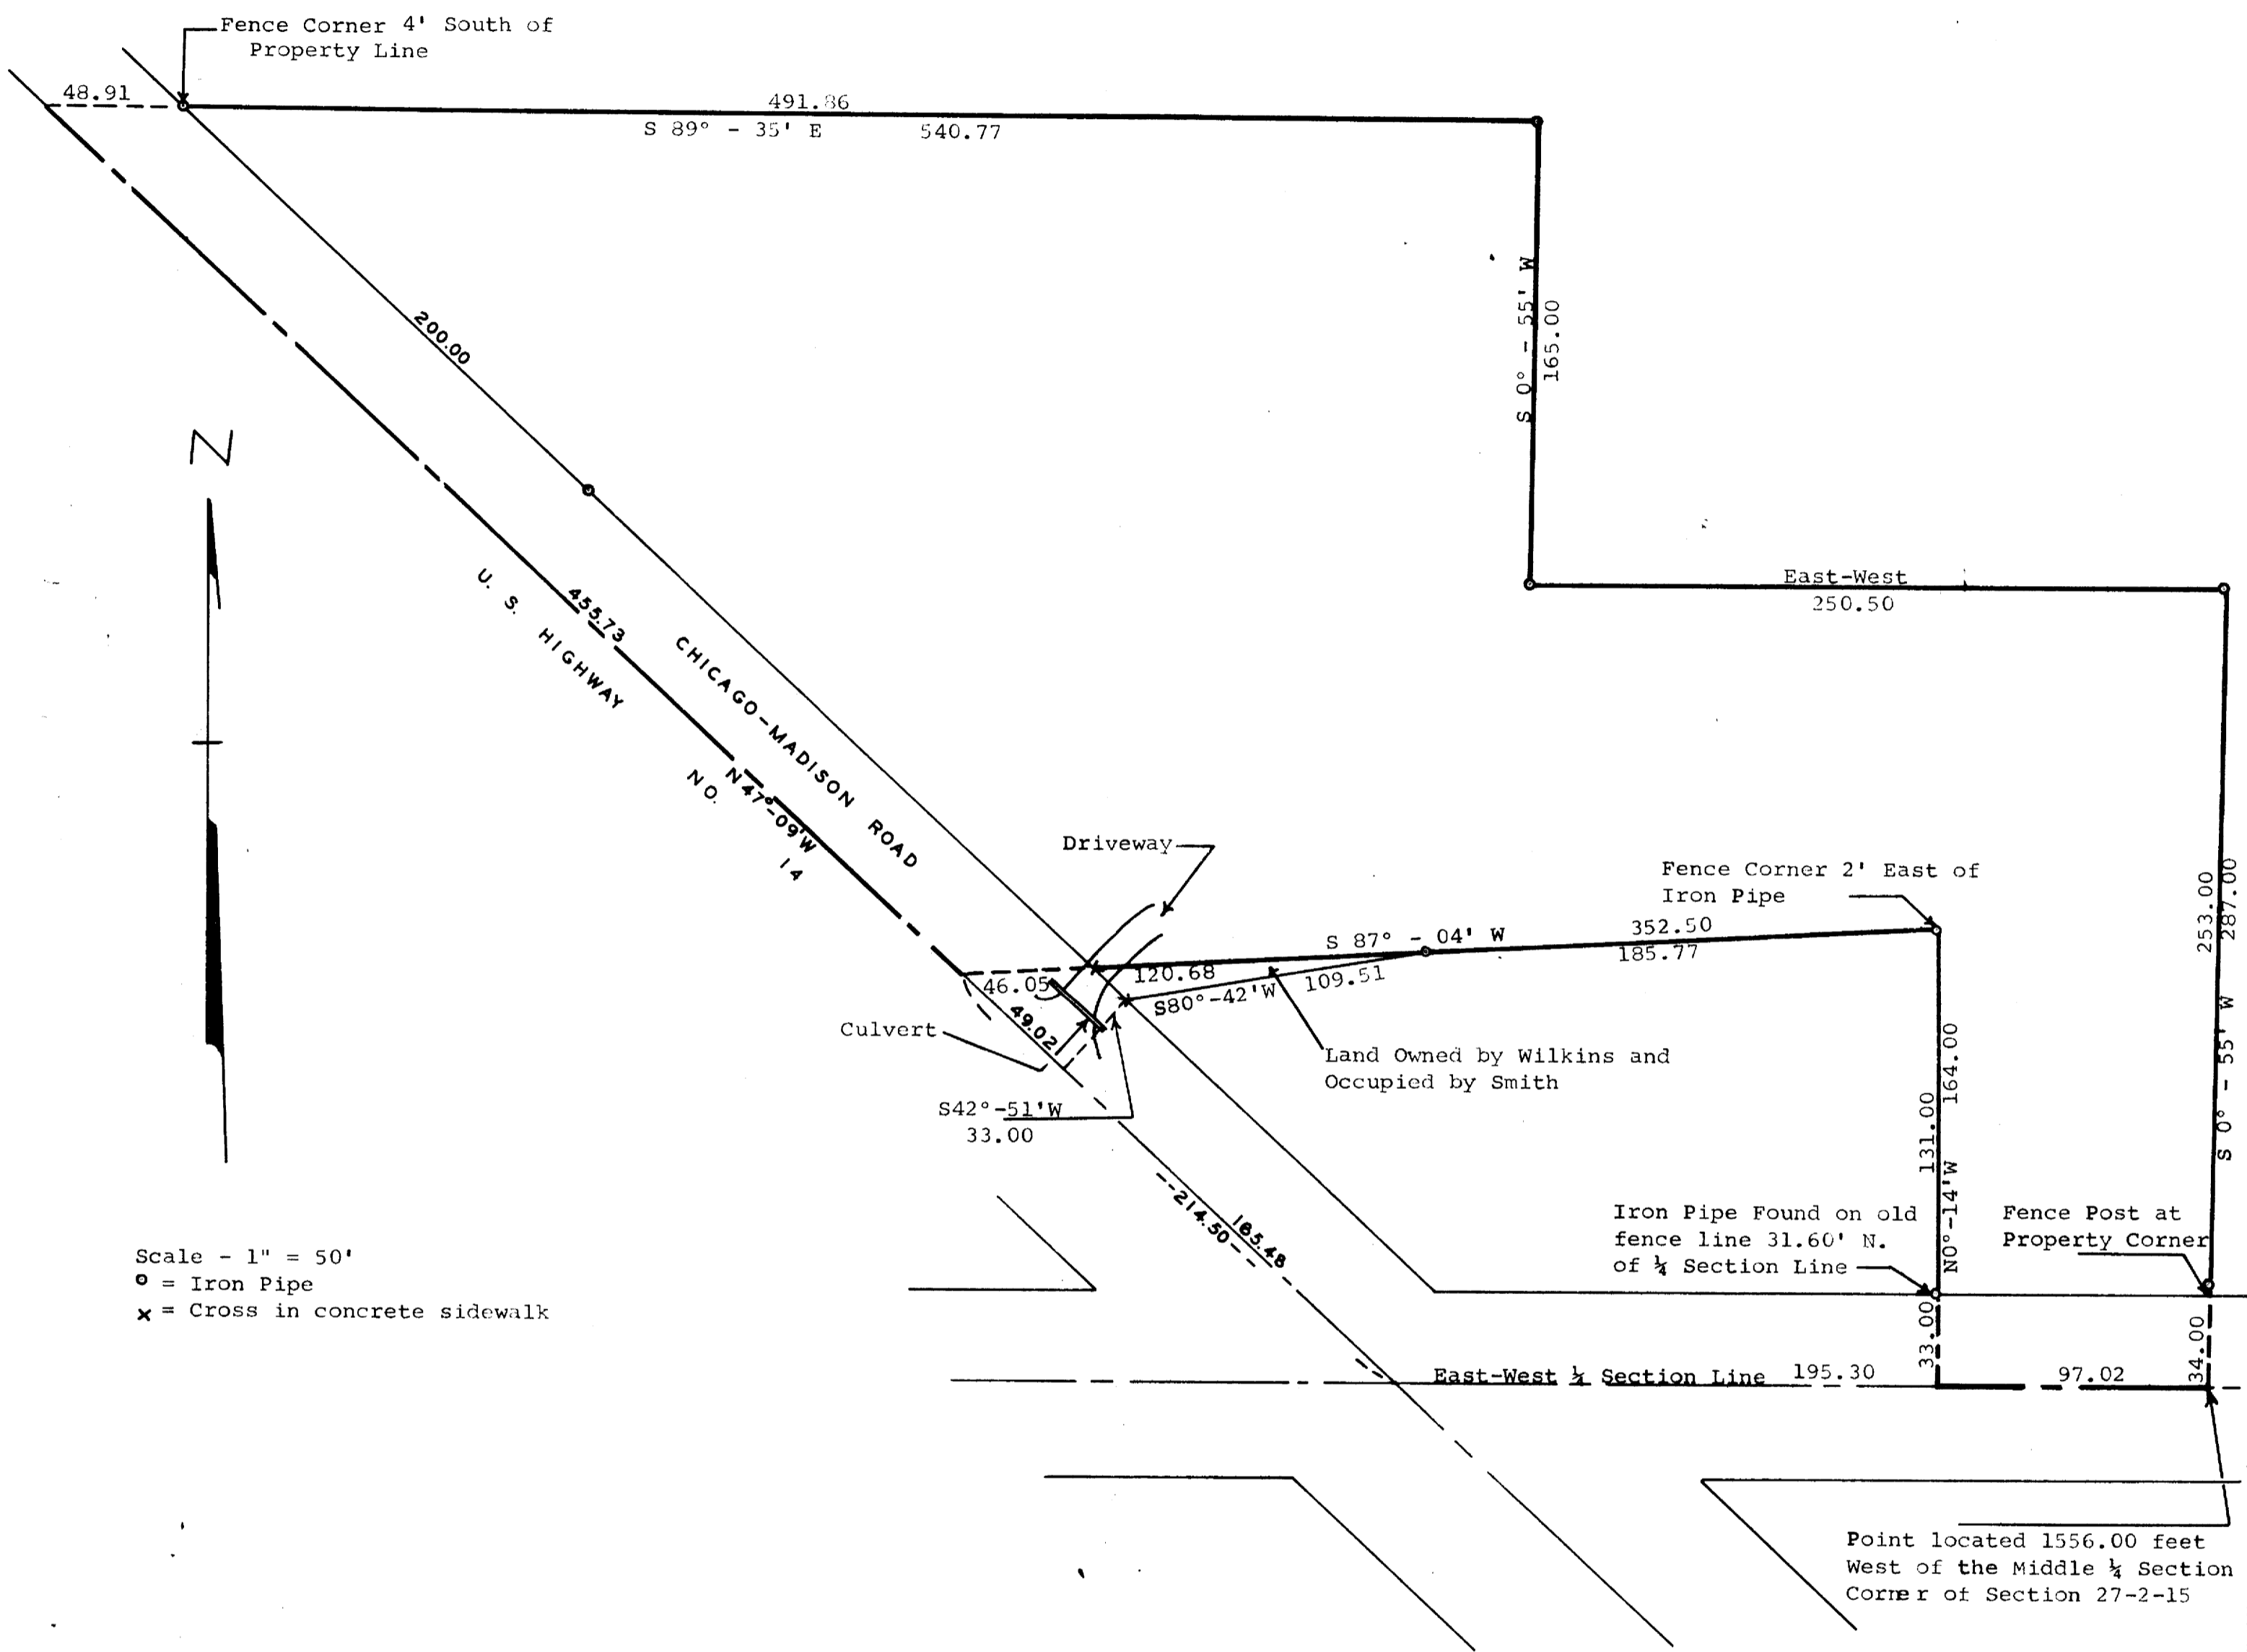

Scale - 1" = 50'  
o = Iron Pipe  
x = Cross in concrete sidewalk

Plat of survey of Eddie J. Smith Estate Property located in the Northwest 1/4 of Section 27, T 2 N, R 15 E, Village of Darien, Walworth County, Wisconsin.  
August 4, 1966

*George T. Dunham*  
George T. Dunham, Surveyor