


**SURVEYING & SUBDIVIDING
DELAN, WISCONSIN 53115**

十

Lake Geneva, WI 53147

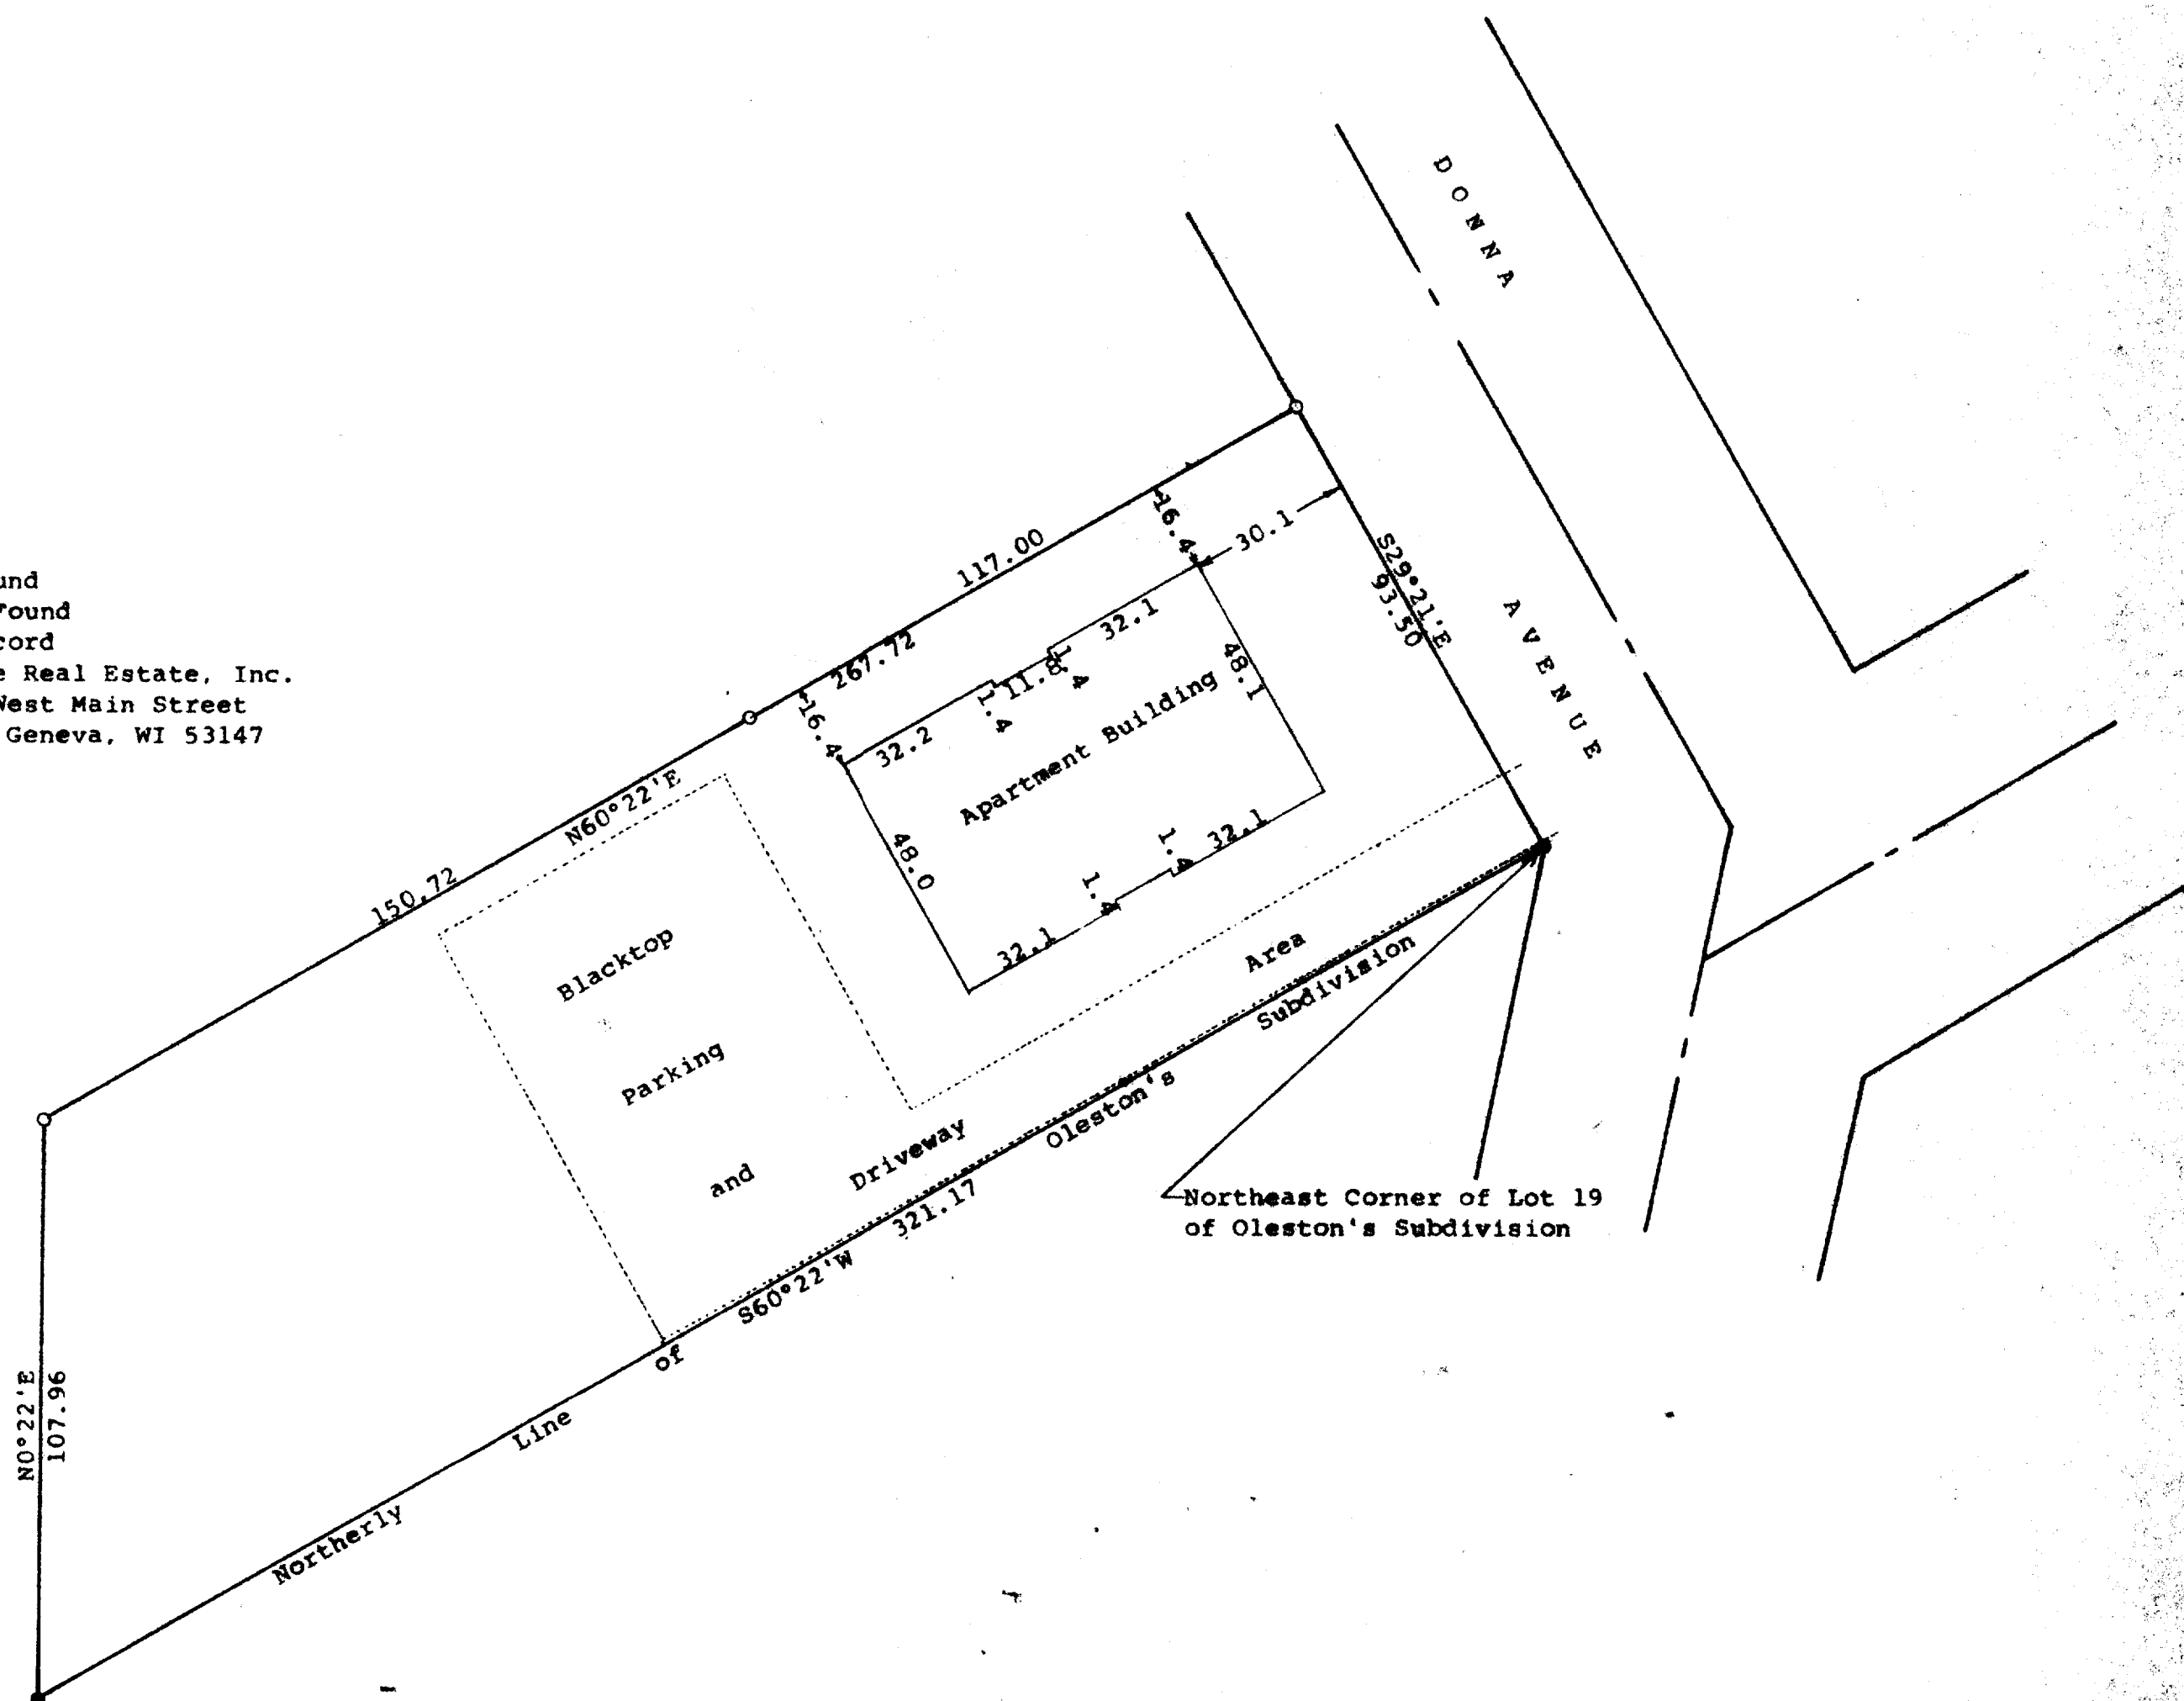

August 23, 1995

George T. Dunham, Surgeon

