


1140 SEQUOIA STREET • DELAVAN, WISCONSIN 53115
262-728-6737

RECEIVED
AUG 8 2000
de

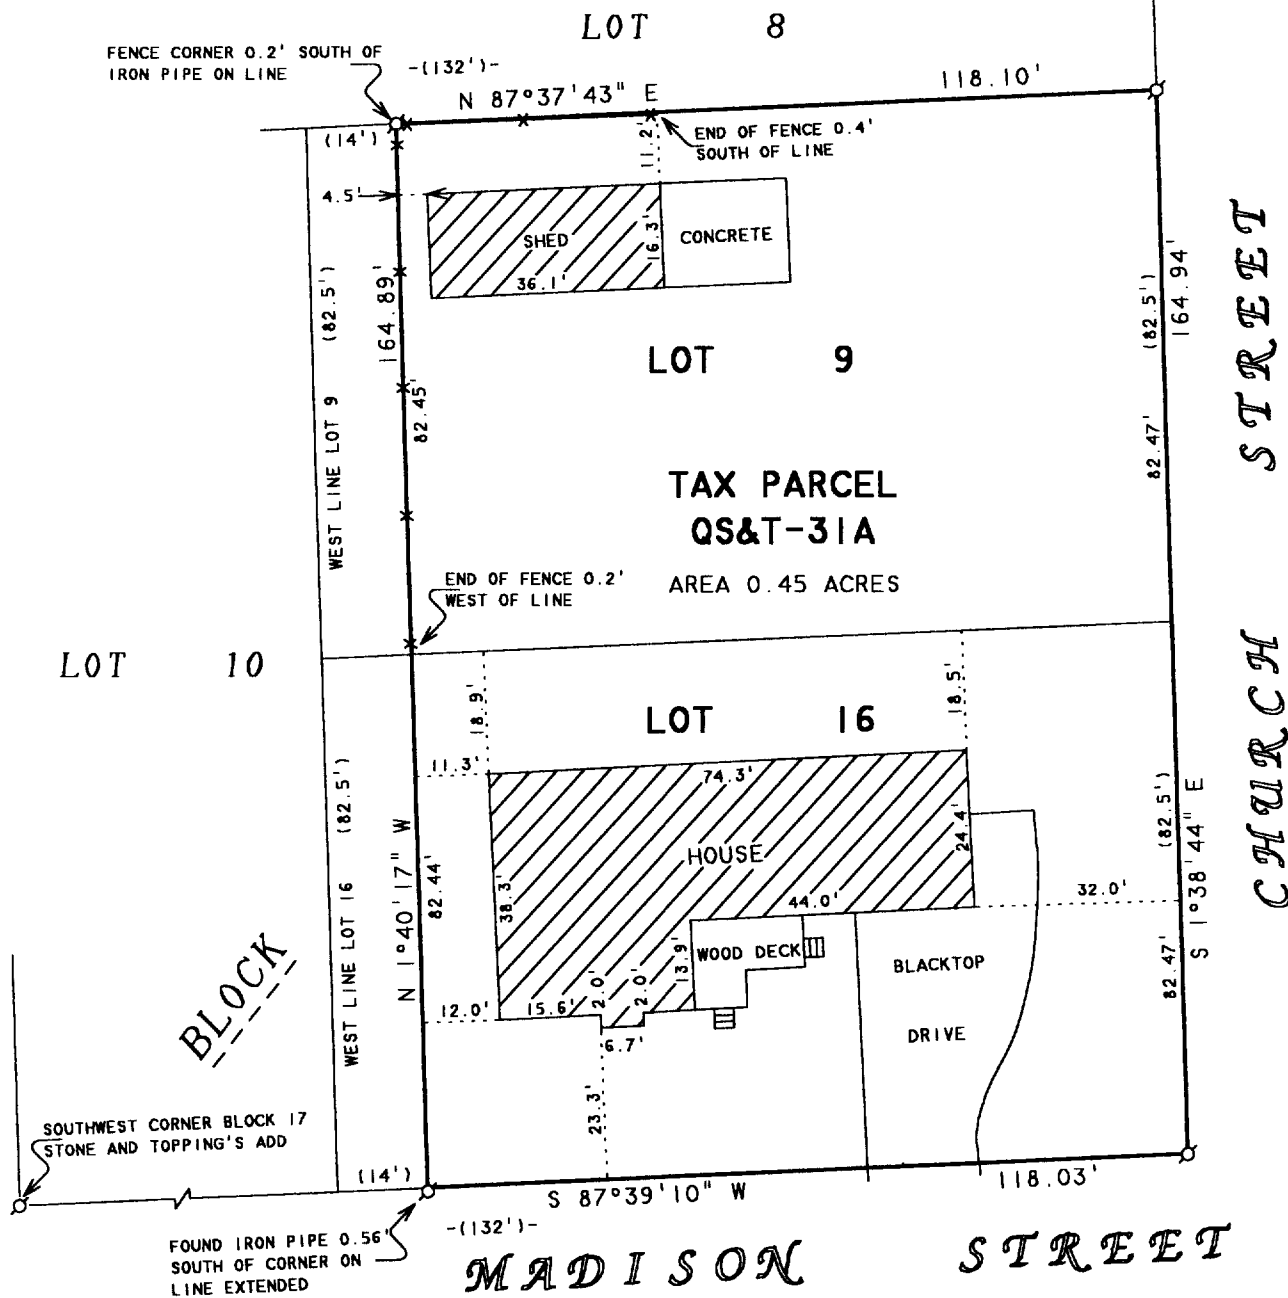

PLAT OF SURVEY OF

LOT 9 AND LOT 16, BLOCK 17, EXCEPT THE WEST 14 FEET THEREOF OF STONE AND TOPPING'S ADDITION TO THE VILLAGE OF DARIEN, WALWORTH COUNTY, WISCONSIN

LEGEND

DAVID F. ABELL
WISCONSIN REGISTERED LAND SURVEYOR. S-1596

DATE _____ JOB NUMBER - 00019
NOTE: THIS IS NOT A CERTIFIED COPY UNLESS SEALED.

O - IRON PIPE FOUND
 ----- - WOOD FENCE
 () - RECORDED AS

Q54T-31A

001-415