

FARRIS, HANSEN & ASSOCIATES, INC.

7 RIDGEWAY COURT, P.O. BOX 437
ELKHORN, WISCONSIN 53121

PLAT OF SURVEY

PHONE: (414) 723-2000
FAX: (414) 723-6000


LOCATION: LOT 23 OAK RIDGE SUBDIVISION
SEC. 27, T. 2 N., R. 15 E.
WALWORTH COUNTY, WISCONSIN

WORK ORDERED BY: ROSEMARY COX
C/O DANIELSON & OSMAN REALTY
23 N. WISCONSIN ST.
DARIEN, WI.

MAP LEGEND

- IRON PIPE STAKE FOUND
- IRON PIPE STAKE SET
- - IRON ROD STAKE FOUND
- IRON ROD STAKE SET
- CONCRETE MONUMENT FOUND
- RECORD DIMENSION

(XXXX)

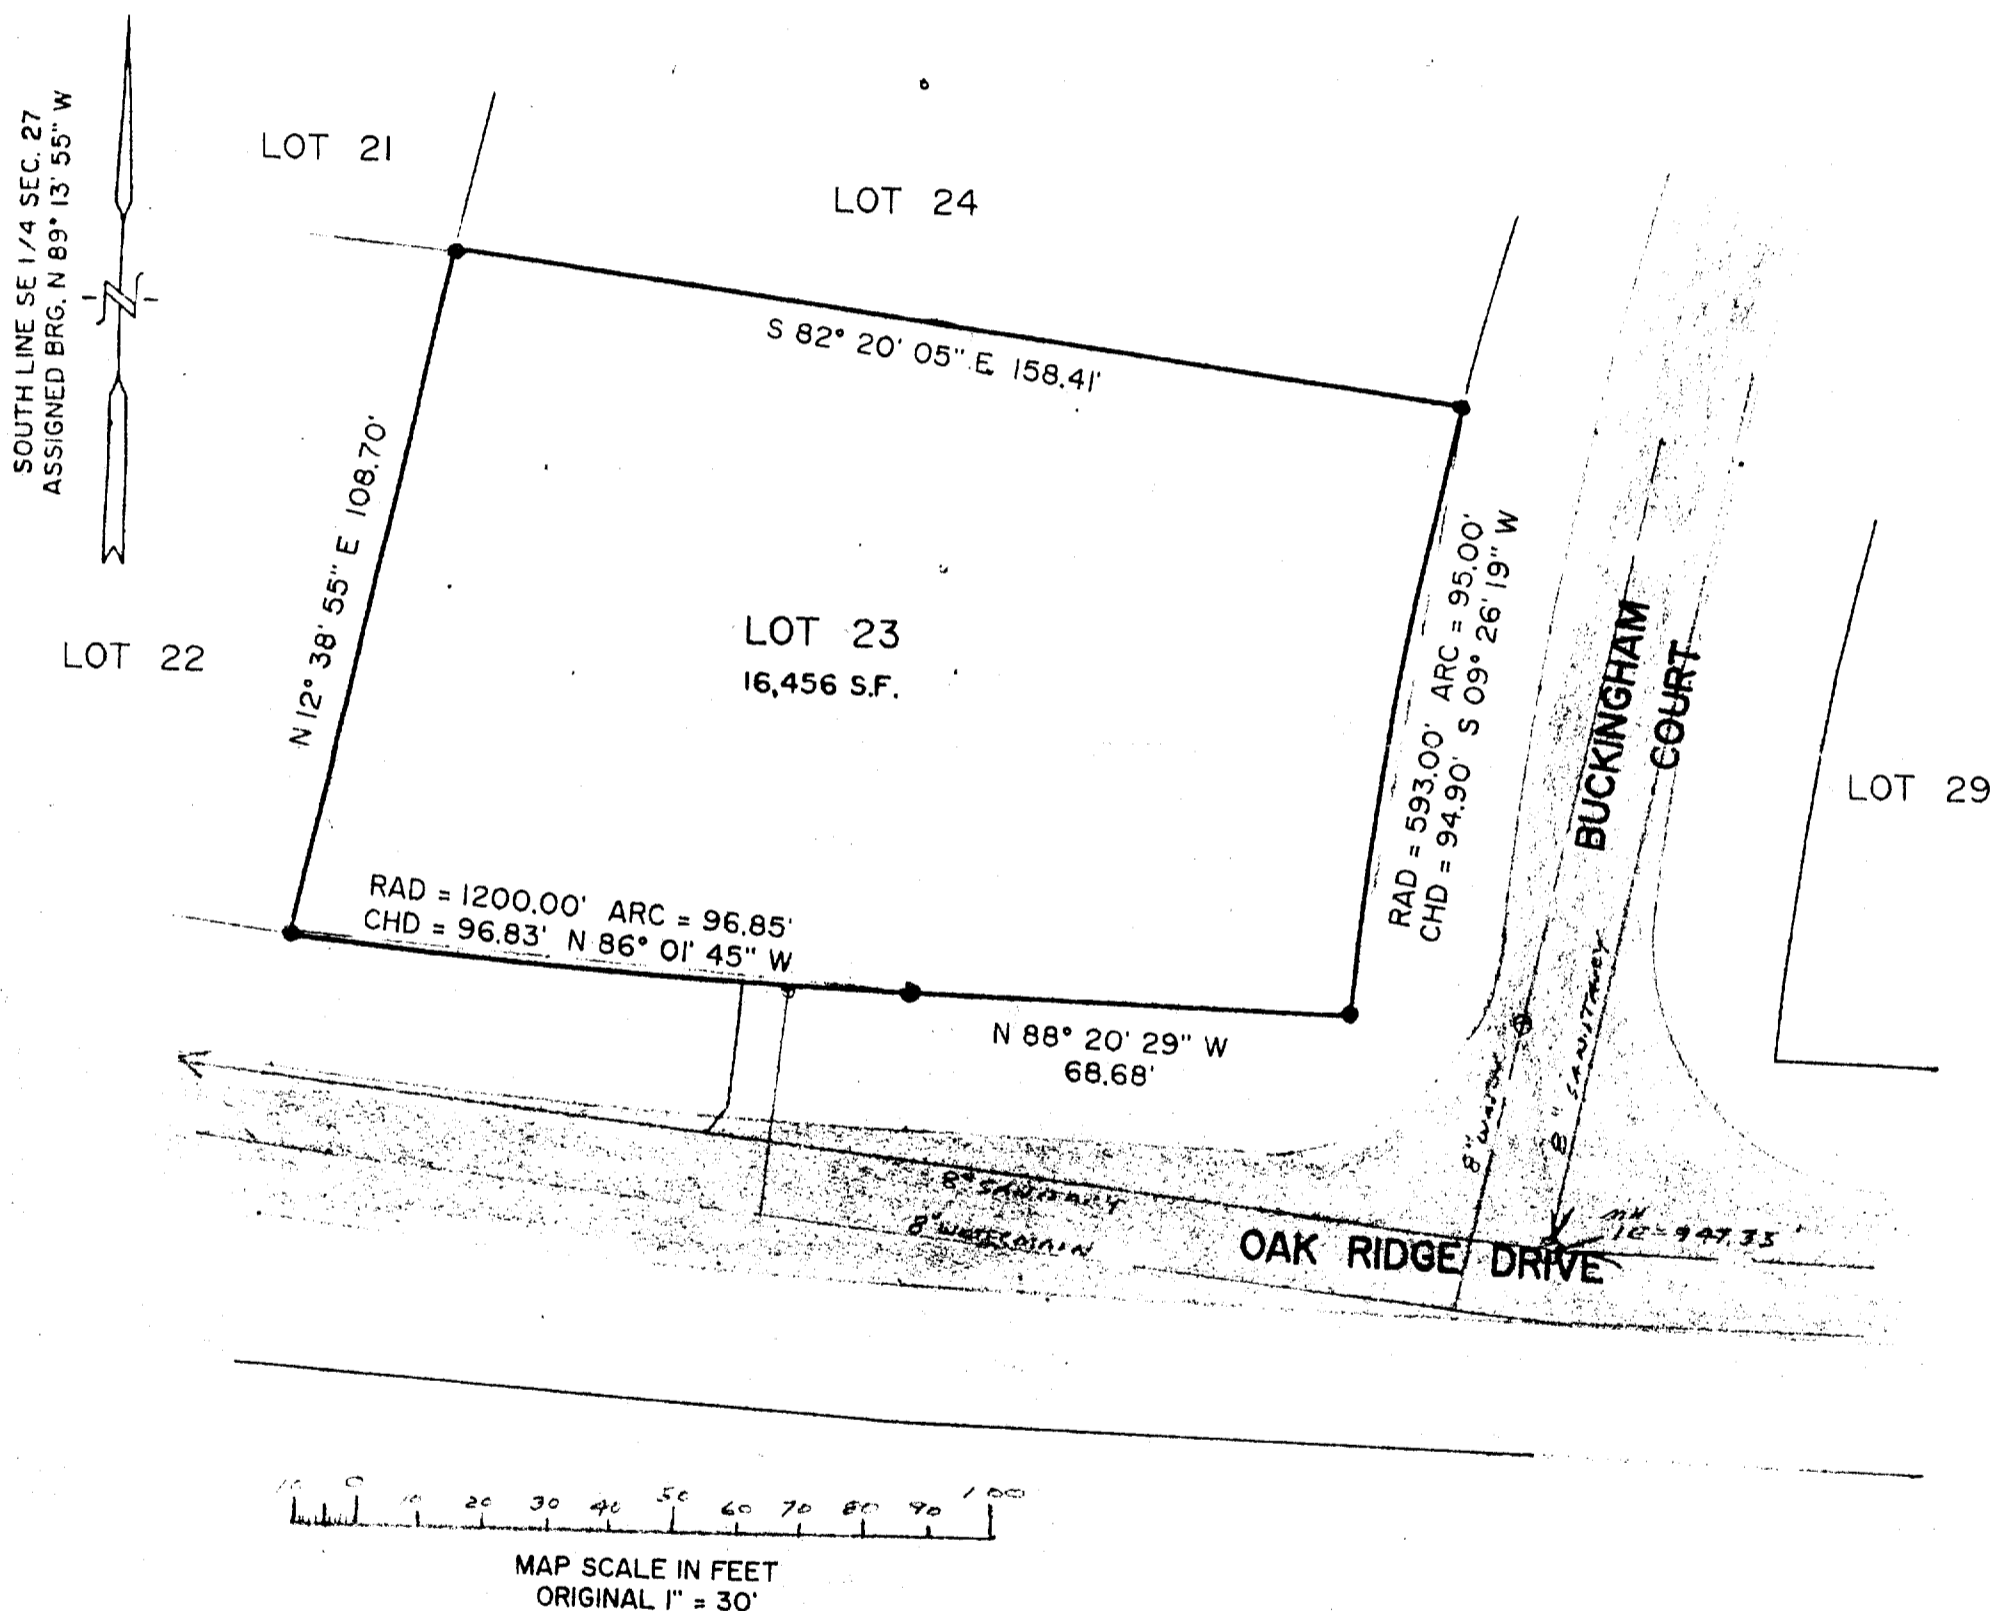



NOTE; COPIES OF THIS MAP TO WHICH THE FOLLOWING CERTIFICATE WILL APPLY ARE BLUE LINE PRINTS SHOWING SURVEYOR'S ORIGINAL SEAL AND SIGNATURE IN BLACK INK. COPIES BY ANY OTHER MEANS MAY HAVE ALTERATIONS WHICH DO NOT REPRESENT THE SURVEYOR'S WORK PRODUCT.

I HEREBY CERTIFY THAT THE ABOVE DESCRIBED PROPERTY HAS BEEN SURVEYED UNDER MY DIRECTION AND THAT THE ABOVE MAP IS A TRUE AND ACCURATE REPRESENTATION THEREOF AND SHOWS THE SIZE AND LOCATION OF THE PROPERTY AND IT'S EXTERIOR BOUNDARIE TO THE BEST OF MY PROFESSIONAL KNOWLEDGE AND BELIEF. THIS SURVEY IS MADE FOR THE USE OF THE PRESENT OWNERS OF THE PROPERTY, AND ALSO THOSE WHO PURCHASE, MORTGAGE, OR GUARANTEE THE TITLE THERETO WITHIN ONE YEAR FROM THE DATE HEREOF.

DATED: JAN 05, 1999

Peter S. Gordon
PETER S. GORDON A.L.S. 2101

90R-23

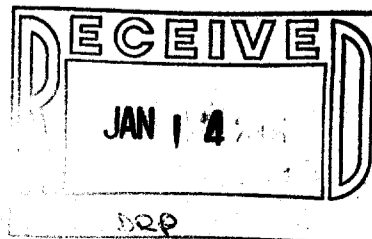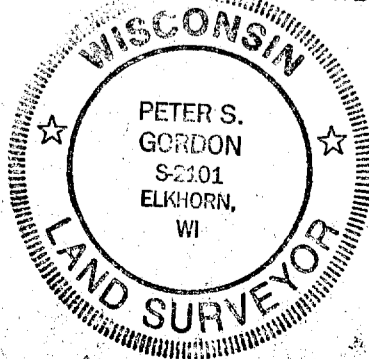

PROJ # 3575.23
01/05/1994

001-489