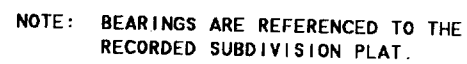


1140 SEQUOIA STREET • DELAVAN, WISCONSIN 53115  
262-728-6737

 $\mathcal{N}$ 

SCALE 1" = 30'

## LEGEND

Ø - IRON PIPE FOUND  
□□ - UTILITY PEDS  
( ) - RECORDED AS

LOT 6, BLOCK 1, BELLA VISTA SUBDIVISION,  
LOCATED IN THE VILLAGE OF DARIEN, WALWORTH  
COUNTY, WISCONSIN.

BLOCK

BELLA VISTA DRIVE

2005

ORDERED BY: SHOREWEST REALTORS  
830 E. GENEVA STREET  
DELAVER, WI 53115

I HEREBY CERTIFY THAT I HAVE SURVEYED THE ABOVE DESCRIBED PROPERTY AND THAT THE ABOVE MAP IS A TRUE REPRESENTATION THEREOF AND SHOWS THE SIZE AND LOCATION OF THE PROPERTY, ITS EXTERIOR BOUNDARIES, THE LOCATION OF ALL VISIBLE STRUCTURES AND DIMENSIONS OF ALL PRINCIPAL BUILDINGS THEREON, BOUNDARY FENCES, APPARENT EASEMENTS, ROADWAYS AND VISIBLE ENCROACHMENTS, IF ANY, TO THE BEST OF MY KNOWLEDGE AND BELIEF.

THIS SURVEY IS MADE FOR THE USE OF THE PRESENT OWNERS OF THE PROPERTY, AND ALSO THOSE WHO PURCHASE, MORTGAGE, OR GUARANTEE THE TITLE THERETO WITHIN ONE (1) YEAR FROM DATE HEREON.

THOSE WHO PURCHASE, MORTGAGE,  
FROM DATE HEREON.

*David F. Phil*

DAVID F. ABELL  
WISCONSIN REGISTERED LAND SURVEYOR, S-1596

August 17, 2005

DATE \_\_\_\_\_ JOB NUMBER - 05106  
NOTE: THIS IS NOT A CERTIFIED COPY UNLESS SEALED.