

— WORK ORDERED BY —  
GLEN HAWKINS  
1478 BROOKSIDE DRIVE  
HOFFMAN ESTATES, IL 60194

FARRIS, HANSEN & ASSOCIATES, INC.  
ENGINEERING — ARCHITECTURE — SURVEYING  
7 RIDGWAY COURT P.O. BOX 437  
ELKHORN, WISCONSIN 53121  
OFFICE: (262) 723-2098 FAX: (262) 723-5886


REVISIONS  
02/15/2006  
TO SHOW SIZE  
AND LOCATION  
OF AS-BUILT  
RESIDENCE

PROJECT NO.  
5458.05  
DATE:  
12/02/2005  
SHEET NO.  
1 OF 1

# PLAT OF SURVEY


LOT 2 OF CERTIFIED SURVEY MAP NO. 3378  
REC. IN VOL. 19 ON PG. 172 AS DOC. NO. 490762

LOCATED IN THE VILLAGE OF DARIEN  
WALWORTH COUNTY, WISCONSIN

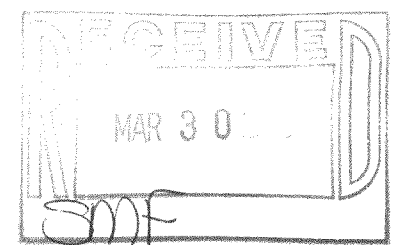

LINE	BEARING	DISTANCE
L1	S 40°17'25" W	17.27
L2	S 40°05'19" W	10.62

LEGEND  
○ = FOUND IRON PIPE STAKE  
● = FOUND IRON REBAR STAKE  
(XXX) = RECORDED AS

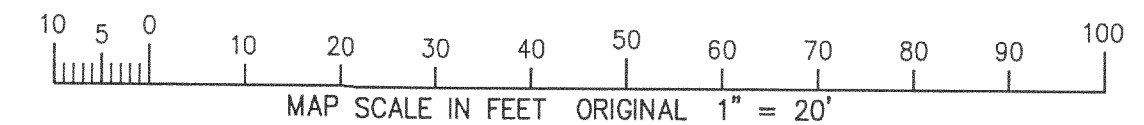

NOTE: COPIES OF THIS MAP TO WHICH THE FOLLOWING CERTIFICATE WILL APPLY SHOW THE SURVEYOR'S ORIGINAL SEAL AND SIGNATURE IN RED INK. COPIES BY ANY OTHER MEANS MAY HAVE ALTERATIONS WHICH DO NOT REPRESENT THE SURVEYOR'S WORK PRODUCT.

I HEREBY CERTIFY THAT THE ABOVE DESCRIBED PROPERTY HAS BEEN SURVEYED UNDER MY DIRECTION AND THAT THE ABOVE MAP IS A TRUE REPRESENTATION THEREOF AND SHOWS THE SIZE AND LOCATION OF THE PROPERTY, ITS EXTERIOR BOUNDARIES, THE LOCATION OF ALL VISIBLE STRUCTURES, AND DIMENSIONS OF ALL PRINCIPLE BUILDINGS THEREON, BOUNDARY FENCES, APPARENT EASEMENTS, ROADWAYS, AND VISIBLE ENCROACHMENTS, IF ANY. THIS SURVEY IS MADE FOR THE USE OF THE PRESENT OWNERS OF THE PROPERTY, AND ALSO THOSE WHO PURCHASE, MORTGAGE, OR GUARANTEE THE TITLE THERETO WITHIN ONE YEAR FROM THE DATE HEREOF.

DATED: DECEMBER 2, 2005 2/17/2006  
PETER S. GORDON

001-517

GRID NORTH  
WISCONSIN COORDINATE SYSTEM  
ASSIGNED SOUTH LINE SE 1/4  
SECTION 27-2-15  
N 87°35'15" E

EDGE OF PAVEMENT

SOUTH SHARON STREET  
VARIABLE WIDTH

LOT 2  
16,144 S.F.

LOT 1 C.S.M. 3378

UNPLATTED LANDS

LOT 3 C.S.M. 3378

