

1140 SEQUOIA STREET • DELAVAN, WISCONSIN 53115  
262-728-6737

NOTE: BEARINGS ARE REFERENCED TO THE  
WISCONSIN COORDINATE SYSTEM -  
SOUTH ZONE.



SCALE 1" = 30'


### LEGEND

- ♂ - IRON PIPE FOUND  
 ⊗ - 10' SPIKE SET IN TREE ROOT  
 ( ) - RECORDED AS

## PLAT OF SURVEY OF

LOT 3 AND THAT PART OF LOT 2, BLOCK 17, STONE & TOPPING ADDITION TO THE VILLAGE OF DARIEN, WALWORTH COUNTY, WISCONSIN, THAT PART OF SAID LOT 2 IS DESCRIBED AS FOLLOWS: PART OF LOT 2, BLOCK 17, STONE & TOPPING ADDITION, LOCATED IN THE SOUTHEAST 1/4 OF THE NORTHWEST 1/4 OF SECTION 17, T2N,R15E, VILLAGE OF DARIEN, WALWORTH COUNTY, WISCONSIN AND DESCRIBED AS FOLLOWS: COMMENCING AT AN IRON PIPE MARKING THE NORTHEAST CORNER OF LOT 1, BLOCK 17, OF SAID STONE & TOPPING ADDITION: THENCE S 87°38'02" W 132.07 FEET ALONG THE SOUTH LINE OF JEFFERSON STREET TO AN IRON PIPE MARKING THE NORTHEAST CORNER OF SAID LOT 2, BLOCK 17 AND THE PLACE OF BEGINNING: THENCE S 1°43'53" E 82.48 FEET TO AN IRON PIPE MARKING THE SOUTHWEST CORNER OF SAID LOT 1, BLOCK 17: THENCE S 87°38'36" W 66.04 FEET TO A POINT ON THE WEST LINE OF SAID LOT 2, BLOCK 17: THENCE N 1°41'14" W 82.50 FEET ALONG SAID WEST LINE TO THE NORTHWEST CORNER OF SAID LOT 2 AND THE SOUTH LINE OF SAID JEFFERSON STREET: THENCE N 87°39'35" E 65.98 FEET TO AN IRON PIPE MARKING THE NORTHEAST CORNER OF SAID LOT 2 AND THE PLACE OF BEGINNING. CONTAINING 0.125 ACRES OF LAND WITH A TOTAL ACRES INCLUDING LOT 3 OF 0.375 ACRES OF LAND.

THIS IS A LOT LINE ADJUSTMENT BETWEEN LOT 3 AND THAT PART OF LOT 2, BLOCK 17, STONE & TOPPING ADDITION.

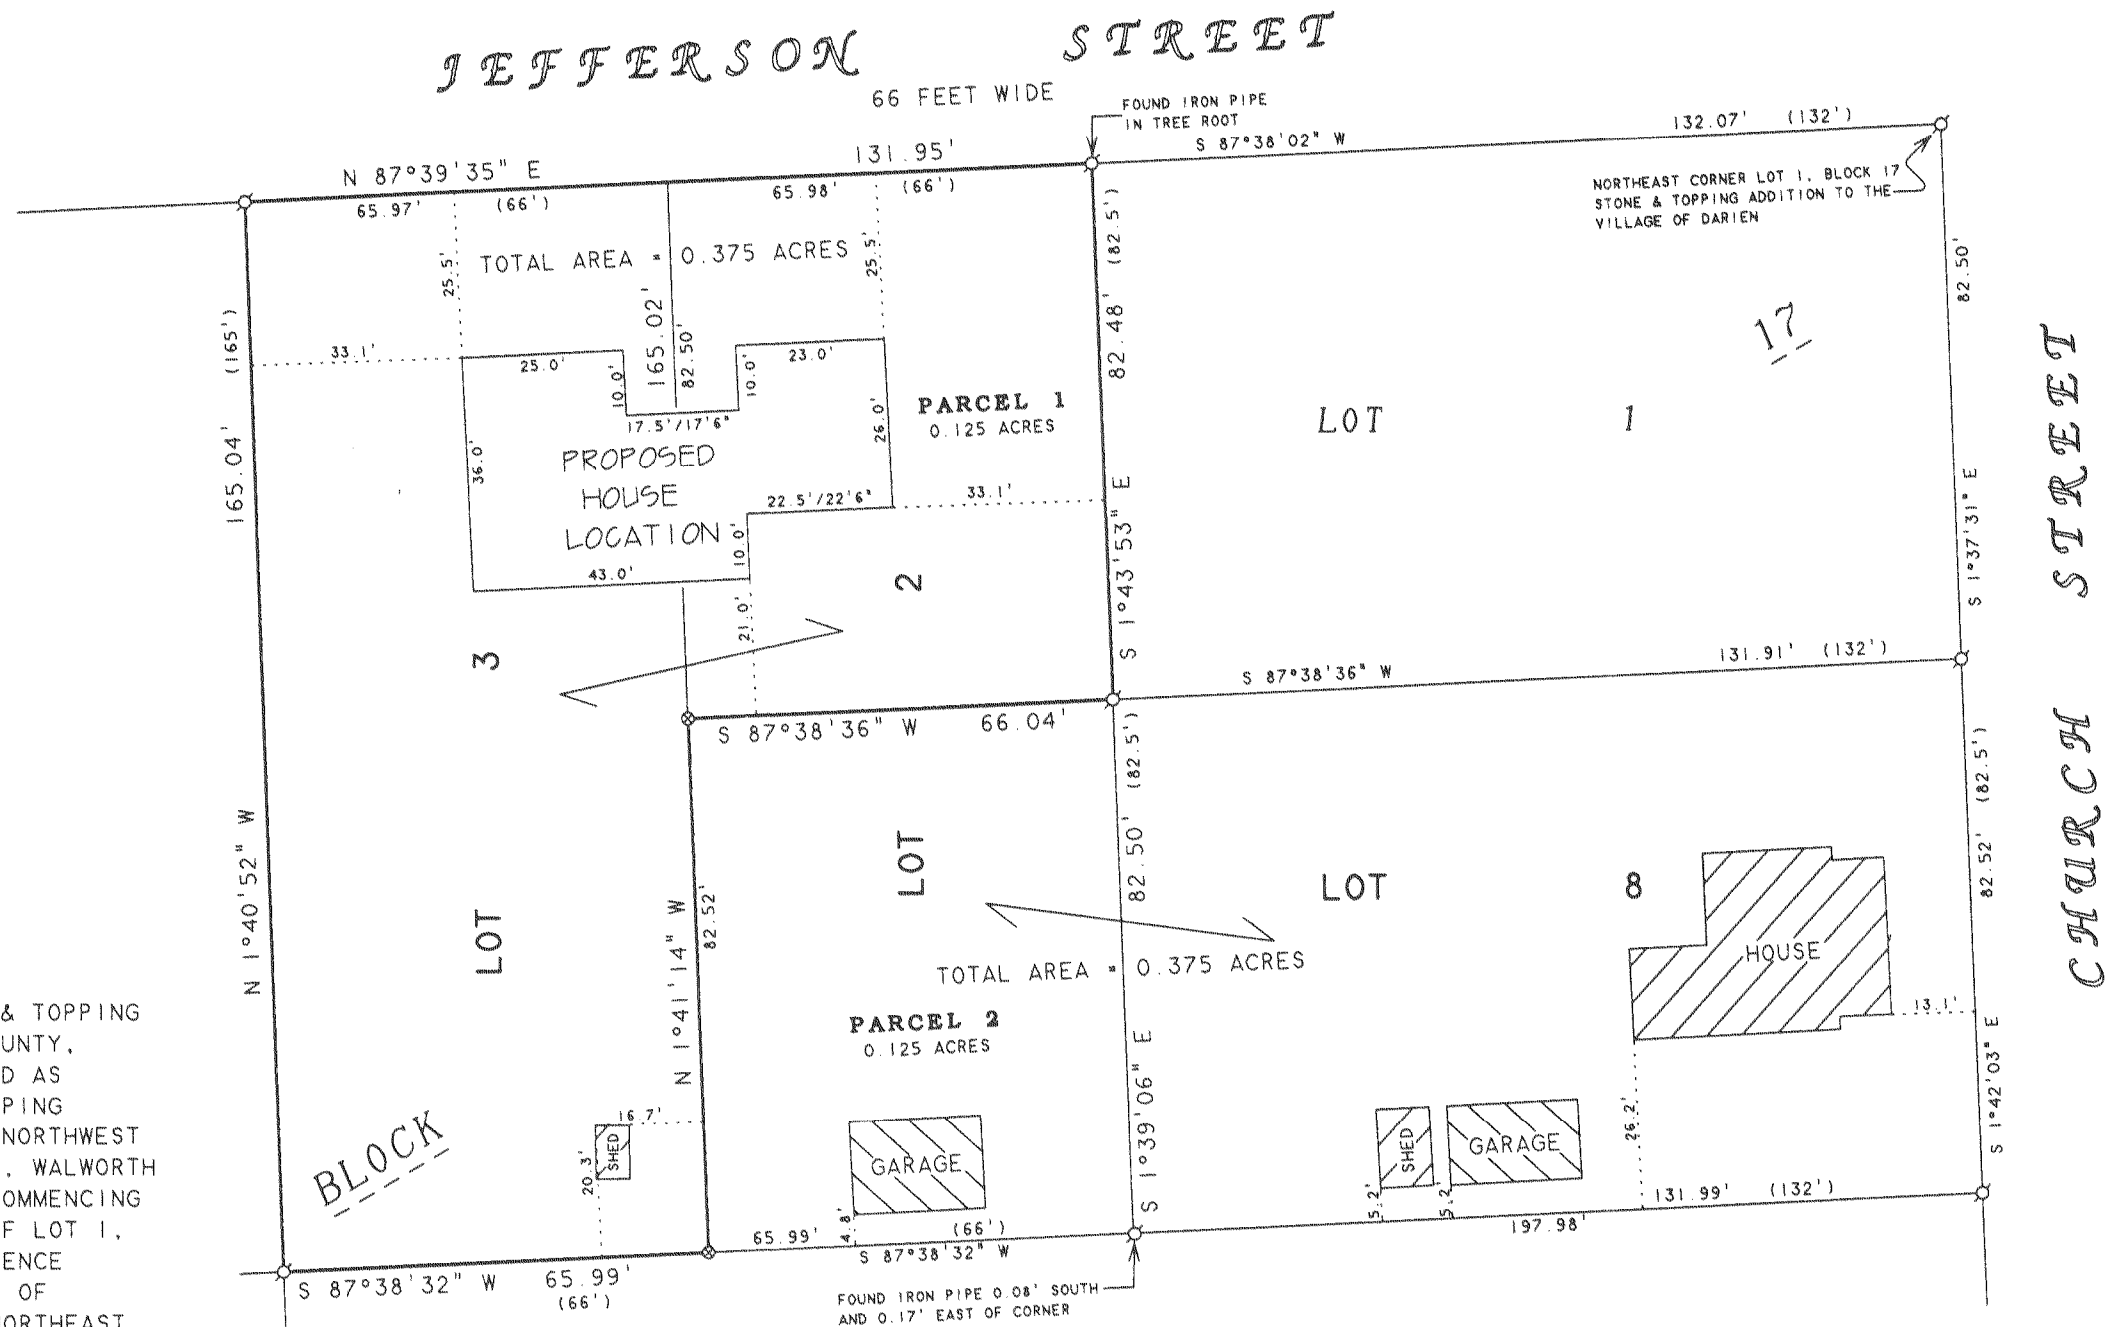

JUN 2006

8mf

I, DAVID F. ABELL, DO HEREBY CERTIFY THAT I HAVE SURVEYED THE PROPERTY HEREON DESCRIBED ACCORDING TO THE OFFICAL RECORDS AND THAT THE PLAT HEREON IS A CORRECT REPRESENTATION OF THE PROPERTY LINES TO THE BEST OF MY KNOWLEDGE AND BELIEF.

David F. Bell

DAVID F. ABELL  
WISCONSIN REGISTERED LAND SURVEYOR, S-1596

ORDERED BY: PHILIP PUTMAN  
206 OAK STREET  
DARIEN, WI 53114

March 8, 2006

DATE \_\_\_\_\_ JOB NUMBER - 06015  
NOTE: THIS IS NOT A CERTIFIED COPY UNLESS SEALED.

QS+T-27 QS+T-28

001-520