

FARRIS, HANSEN & ASSOCIATES, INC.


ENGINEERING — ARCHITECTURE — SURVEYING
7 RIDGWAY COURT — P.O. BOX 437 — ELKHORN, WISCONSIN 53121
PHONE: (262) 723-2098 FAX: (262) 723-5886

PLAT OF SURVEY

LEGAL DESCRIPTION

LOTS 4 AND 5 OF BLOCK 10 OF THE ORIGINAL PLAT OF THE VILLAGE OF DARIEN, WALWORTH COUNTY, WISCONSIN; TOGETHER WITH A PARCEL BEING A PART OF THE RIGHT OF WAY FOR FREMONT STREET DESCRIBED AS FOLLOWS: BEGINNING AT THE NORTHEAST CORNER OF LOT 4 OF BLOCK 10 OF THE ORIGINAL PLAT FOR THE VILLAGE OF DARIEN; THENCE S 60DEG 21MIN 51SEC W, 131.98 FEET; THENCE N 29DEG 31MIN 24SEC W, 15.46 FEET; THENCE N 60DEG 23MIN 27SEC E, 131.98 FEET; THENCE S 29DEG 31MIN 22SEC E, 15.40 FEET TO THE POINT OF BEGINNING.



— WORK ORDERED FOR —
DAVID BLISS
BY: SHOREWEST REALTY
DELAVAN, WI. 53115

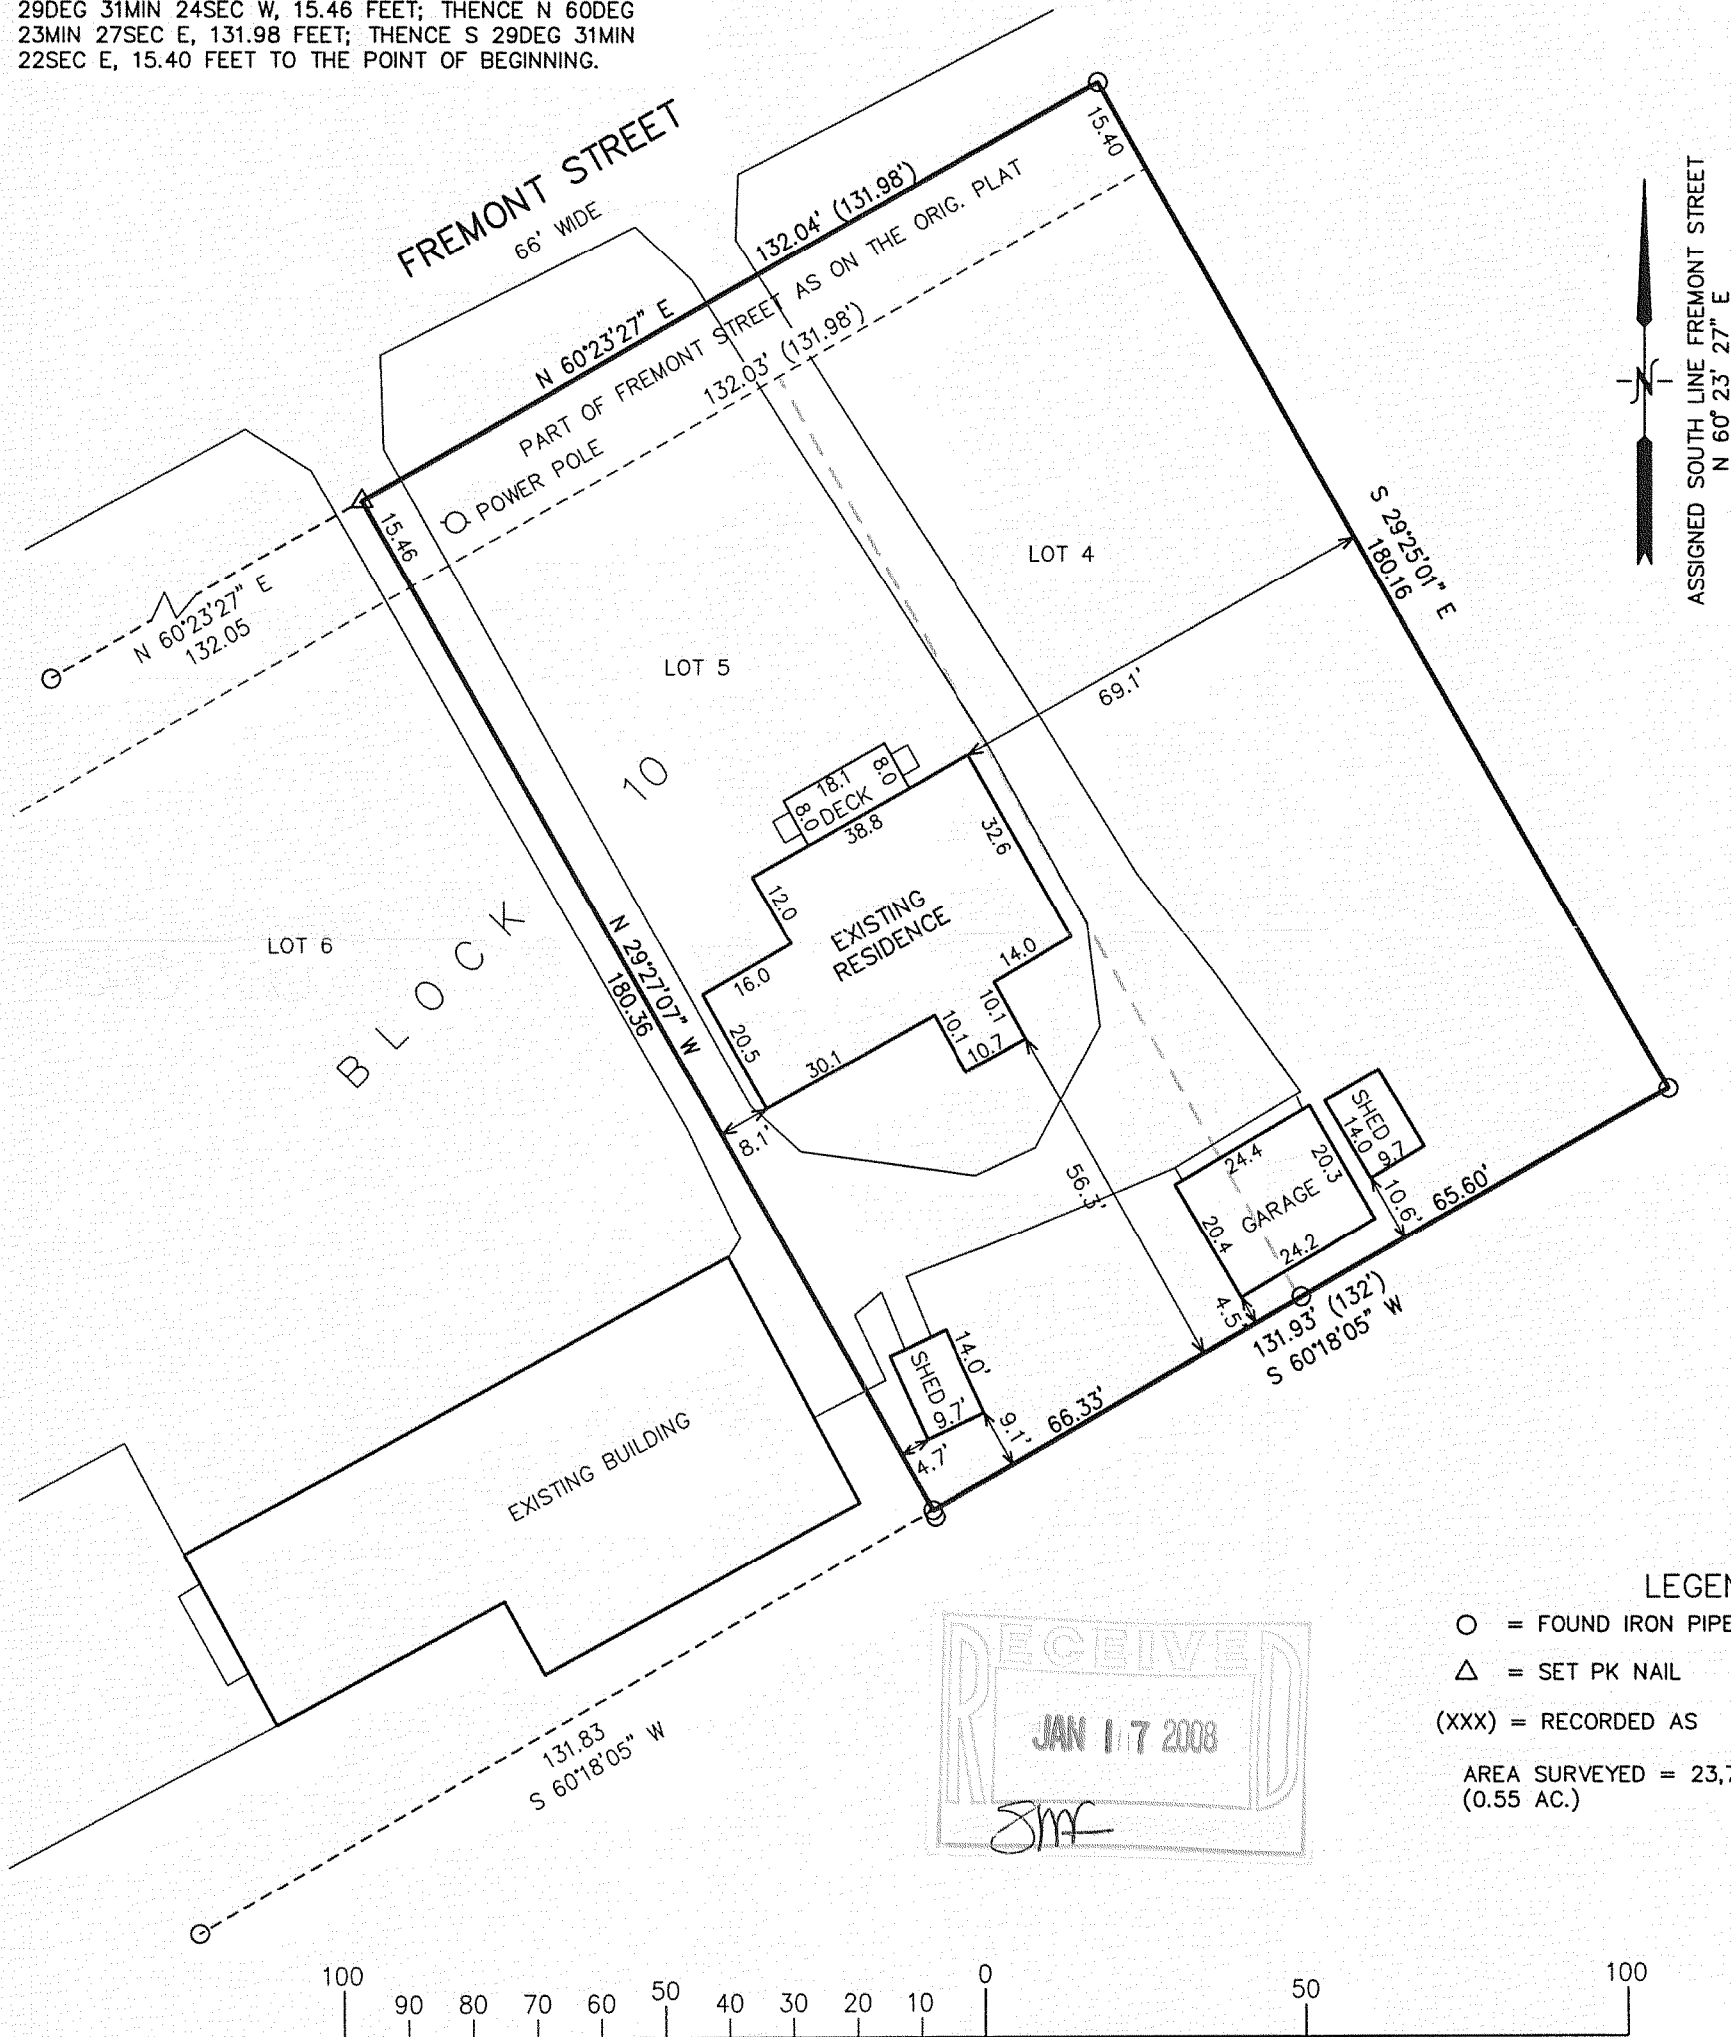

ASSIGNED SOUTH LINE FREMONT STREET
N 60° 23' 27" E

LEGEND

- = FOUND IRON PIPE STAKE
- △ = SET PK NAIL
- (XXX) = RECORDED AS
- AREA SURVEYED = 23,790 S.F.
(0.55 AC.)

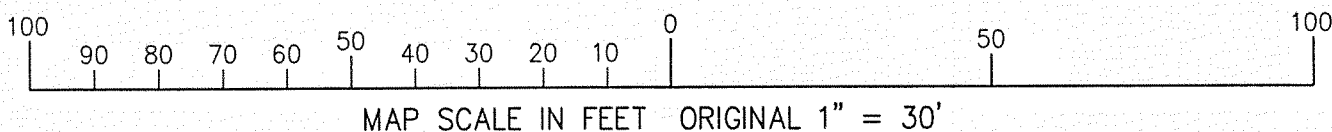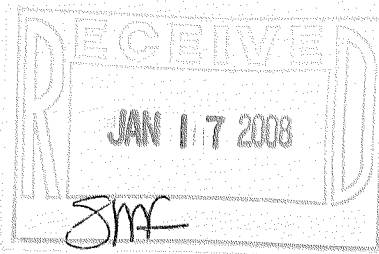

NOTE: COPIES OF THIS MAP TO WHICH THE FOLLOWING CERTIFICATE WILL APPLY SHOW SURVEYOR'S ORIGINAL SEAL AND SIGNATURE IN RED INK. COPIES BY ANY OTHER MEANS MAY HAVE ALTERATIONS WHICH DO NOT REPRESENT THE SURVEYOR'S WORK PRODUCT.

I HEREBY CERTIFY THAT THE ABOVE DESCRIBED PROPERTY HAS BEEN SURVEYED UNDER MY DIRECTION AND THAT THE ABOVE MAP IS A TRUE REPRESENTATION THEREOF AND SHOWS THE SIZE AND LOCATION OF THE PROPERTY, ITS EXTERIOR BOUNDARIES, THE LOCATION OF ALL VISIBLE STRUCTURES, AND DIMENSIONS OF ALL PRINCIPLE BUILDINGS THEREON, BOUNDARY FENCES, APPARENT EASEMENTS, ROADWAYS, AND VISIBLE ENCROACHMENTS, IF ANY. THIS SURVEY IS MADE FOR THE USE OF THE PRESENT OWNERS OF THE PROPERTY, AND ALSO THOSE WHO PURCHASE, MORTGAGE, OR GUARANTEE THE TITLE THERETO WITHIN ONE YEAR FROM THE DATE HEREOF.

DATED: JANUARY 13, 2008

PETER S. GORDON R.L.S. 2101



PROJECT: 7515
DATE: 12-28-2007
SHEET 1 OF 1