


Plat of Survey

LOT 2, CERTIFIED SURVEY MAP NO. 2412, being a redivision of Lot 2, Oleston's Subdivision, being a part of the Northeast 1/4 of the Southeast 1/4 of Section 27, Town 2 North, Range 15 East, Village of Darien, Walworth County, Wisconsin.

Surveyed for: Monica Krey


Survey address: 67 Donna Ave.

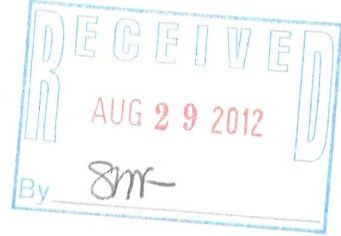

SCALE 1"=30'

BEARINGS ARE REFERENCED TO THE EASTERLY LINE OF DONNA AVE. AND IS ASSUMED TO BEAR N05°30'00"W PER RECORDED CSM.

- FOUND 2" IRON PIPE
- FOUND 1" IRON PIPE
- ⊙ FOUND 3/4" REBAR
- () RECORDED AS DIMENSIONS

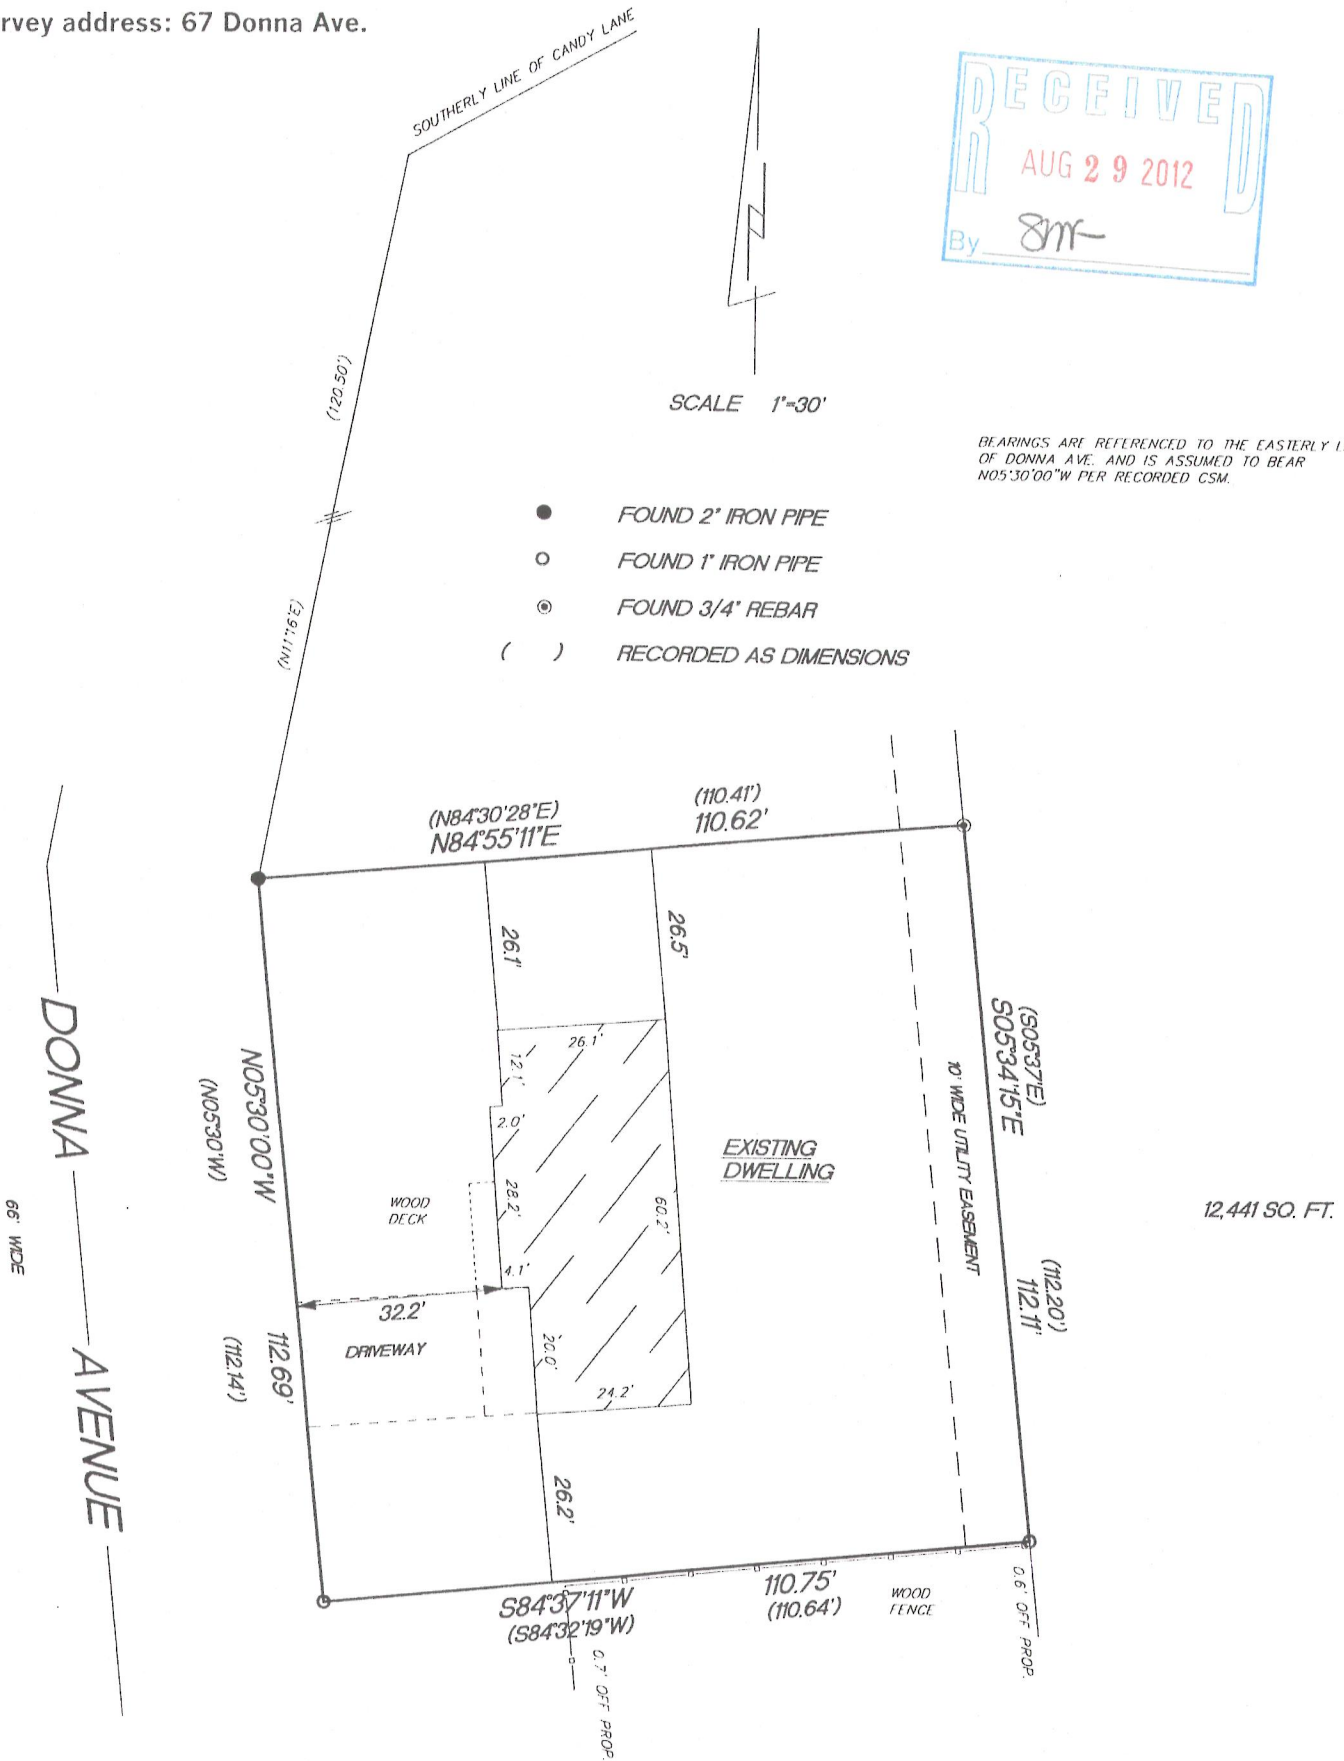

12,441 SQ. FT.

"I hereby certify that I have surveyed the above described property and that the above map is a true representation thereof and shows the size and location of the property, its exterior boundaries, the location of all visible structures and dimension of all principal buildings thereon, boundary fences, apparent easements, roadways and encroachments if any."

"This survey is made for the use of the present owners of the property, and also those who purchase, mortgage or guarantee the title thereto within one year from date hereof."

KETTLE MORaine SURVEYING INC.
 575 W36245 Wilton Road
 Eagle Wisconsin 53119
 P.O. Box 357
 (262) 594-3484

Terrance E. Pisarek R.L.S.



THIS IS NOT AN ORIGINAL SURVEY UNLESS THE SEAL IS RED.

6/25/12

TEP

TEP

12041

DATE

FIELD WORK BY

DRAWN BY

JOB NUMBER

QA2412-2

001-563