


GRID NORTH
WISCONSIN COORDINATE SYSTEM - SOUTH ZONE
S. LINE OF THE SW 1/4 OF SECTION 26-2-15
BEARS N 87°48'33" E

PLAT OF SURVEY



LOT 8 OF BLUEBIRD HILLS, A SUBDIVISION

LOCATED IN PART OF THE SOUTHWEST 1/4 OF THE SOUTHWEST 1/4 OF SECTION 26,
TOWN 2 NORTH, RANGE 15 EAST, VILLAGE OF DARIEN, WALWORTH COUNTY, WISCONSIN

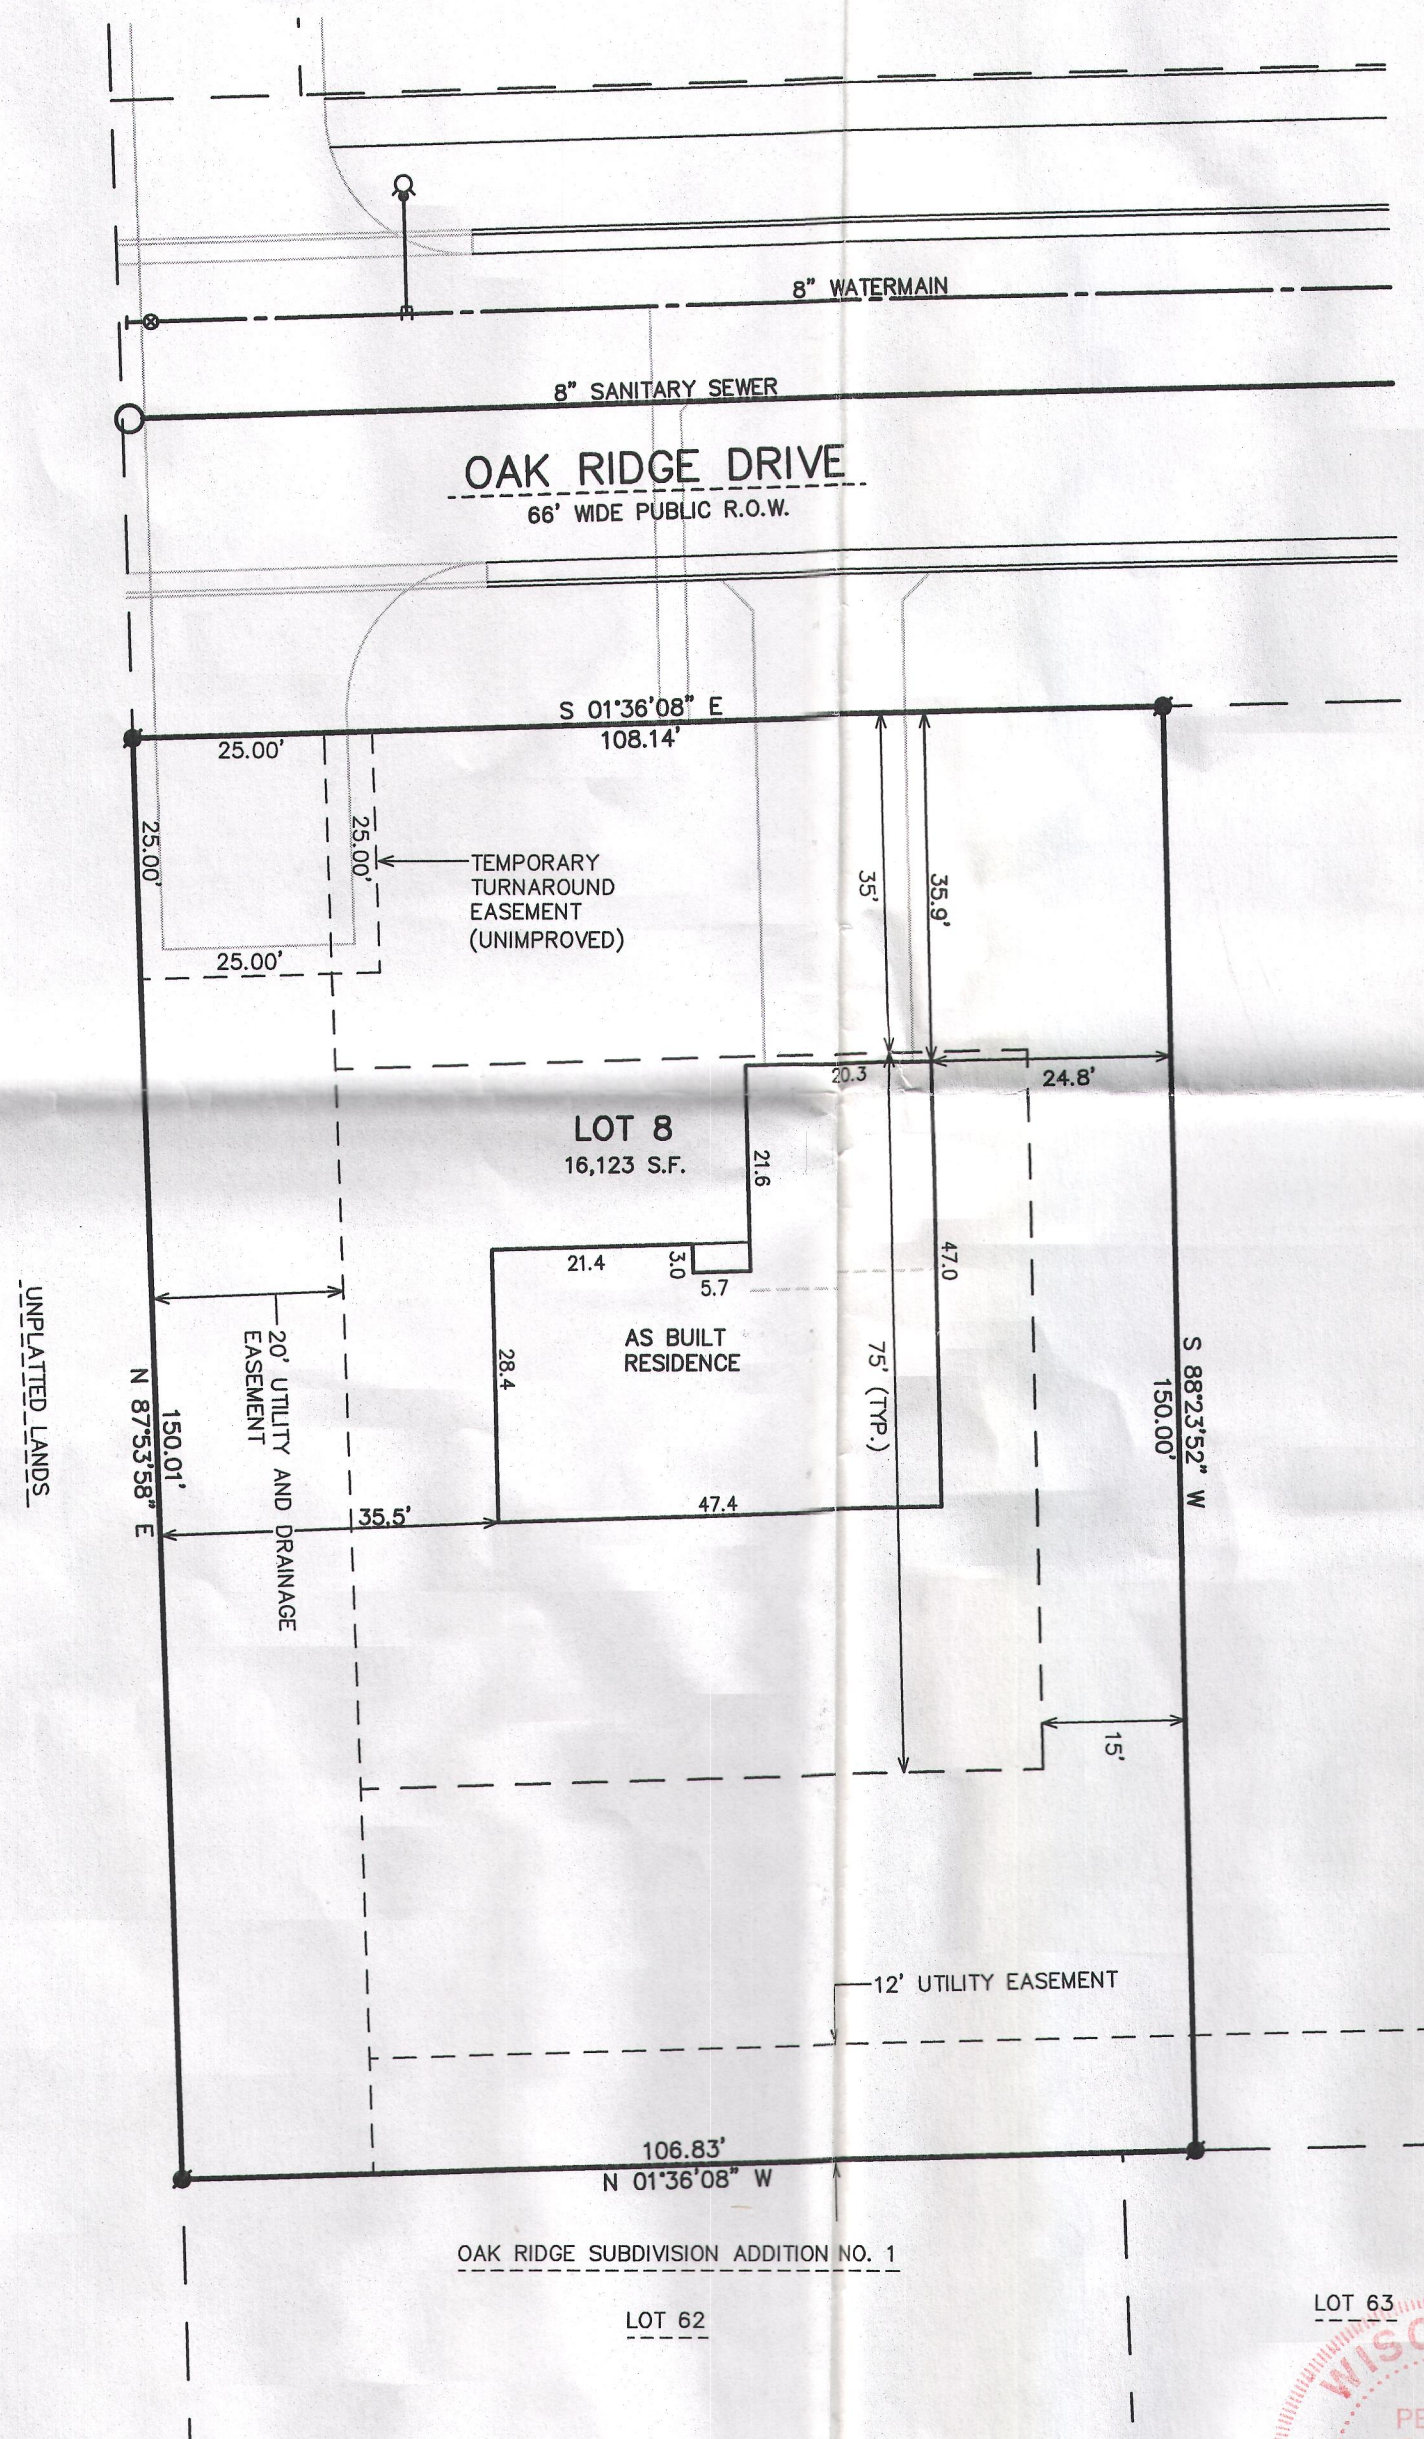


LEGEND

- = FOUND IRON REBAR STAKE
- = FOUND CONCRETE COUNTY MONUMENT WITH BRASS CAP
- {xxx} = RECORDED AS
- Y.G. = YARD GRADE
- T.F. = TOP OF FOUNDATION

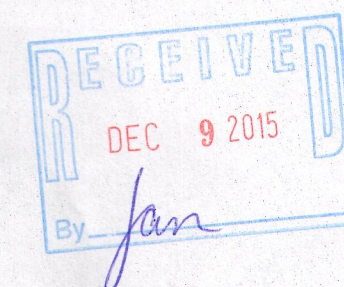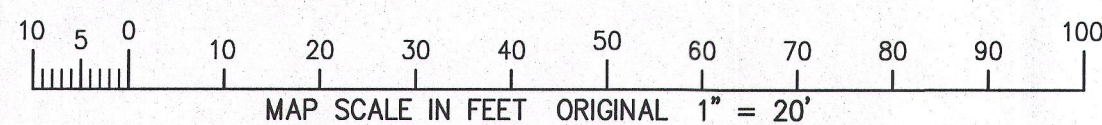

NOTE: COPIES OF THIS MAP TO WHICH THE FOLLOWING CERTIFICATE WILL APPLY SHOW THE SURVEYOR'S ORIGINAL SEAL AND SIGNATURE IN RED INK. COPIES BY ANY OTHER MEANS MAY HAVE ALTERATIONS WHICH DO NOT REPRESENT THE SURVEYOR'S WORK PRODUCT.

I HEREBY CERTIFY THAT THE ABOVE DESCRIBED PROPERTY HAS BEEN SURVEYED UNDER MY DIRECTION AND THAT THE ABOVE MAP IS A TRUE REPRESENTATION THEREOF AND SHOWS THE SIZE AND LOCATION OF THE PROPERTY AND ITS EXTERIOR BOUNDARIES. THIS SURVEY IS MADE FOR THE USE OF THE PRESENT OWNERS OF THE PROPERTY, AND ALSO THOSE WHO PURCHASE, MORTGAGE, OR GUARANTEE THE TITLE THERETO WITHIN ONE YEAR FROM THE DATE HEREOF.

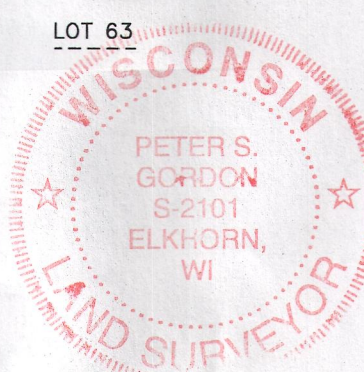

DATED: SEPTEMBER 11, 2006

REVISED 2-9-2015
TO SHOW PROPOSED RESIDENCE

Peter S. Gordon
PETER S. GORDON R.L.S. 2101

REVISED 07-09-2015
TO SHOW AS BUILT RESIDENCE

WORK ORDERED BY -
BERINGER HOMES
6595 N. LAZY RIVER ROAD
JANESVILLE, WI. 53545

FARRIS, HANSEN & ASSOCIATES, INC.
ENGINEERING - ARCHITECTURE - SURVEYING
7 RIDGWAY COURT P.O. BOX 437
ELKHORN, WISCONSIN 53121
OFFICE: (262) 723-2098 FAX: (262) 723-5886

REVISIONS

PROJECT NO.
6708.08
DATE:
09/11/06
SHEET NO.
1 OF 1

QBH-8

001-597