

ROBERS & BOYD, INC.
CONSULTING ENGINEERS & LAND SURVEYORS

PHONE (414) 763-2652

116 E. CHESTNUT ST.


BURLINGTON, WIS. 53105

PLAT OF SURVEY AND BUILDING LOCATION

The West 82 feet of Lot 14 and the West 82 feet of Lot 15, Block 16, Stone & Topping Addition to the Village of Darien, Walworth County, Wisconsin.



BUILDING

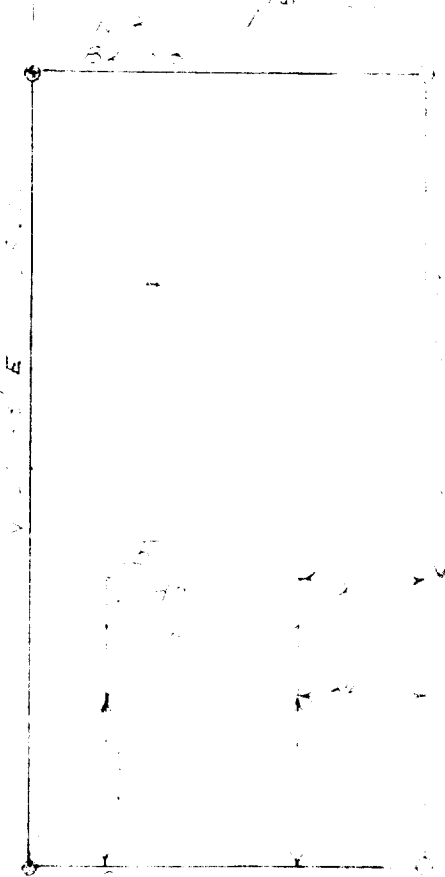

LEGEND

SCALE 1" = 40'

- ① FOUNDATION
- ② EXTERIOR WALL

I HEREBY CERTIFY THAT WE HAVE SURVEYED THE LANDS DESCRIBED ABOVE ACCORDING TO OFFICIAL RECORDS AND THAT THE PLAT DRAWN HEREON IS A CORRECT REPRESENTATION OF SAID SURVEY

WIS. REG. LAND SURVEYOR

DATE

JOB NO