
PLAT OF SURVEY

LOTS 34, 35 AND 36, THE PONDS OF DARIEN, AND LOCATED IN THE SW 1/4 OF THE NE 1/4 OF SECTION 27, T.2N., R. 15E. OF THE 4TH P.M., VILLAGE OF DARIEN, WALWORTH COUNTY, WISCONSIN.

STATE OF WISCONSIN COUNTY OF ROCK

I HEREBY CERTIFY THAT I HAVE SUPERVISED THE SURVEY OF THE PROPERTY DESCRIBED ABOVE FOR THE EXCLUSIVE USE OF RANDY GADDINI AND THAT TO THE BEST OF MY KNOWLEDGE AND BELIEF THE PLAT HEREON DRAWN CORRECTLY REPRESENTS SAID SURVEY AND ITS LOCATION AND COMPLIES WITH CHAPTER A-E7.

GIVEN UNDER MY HAND AND SEAL THIS 16th DAY OF MAY, 2017, AT JANESVILLE, WISCONSIN.

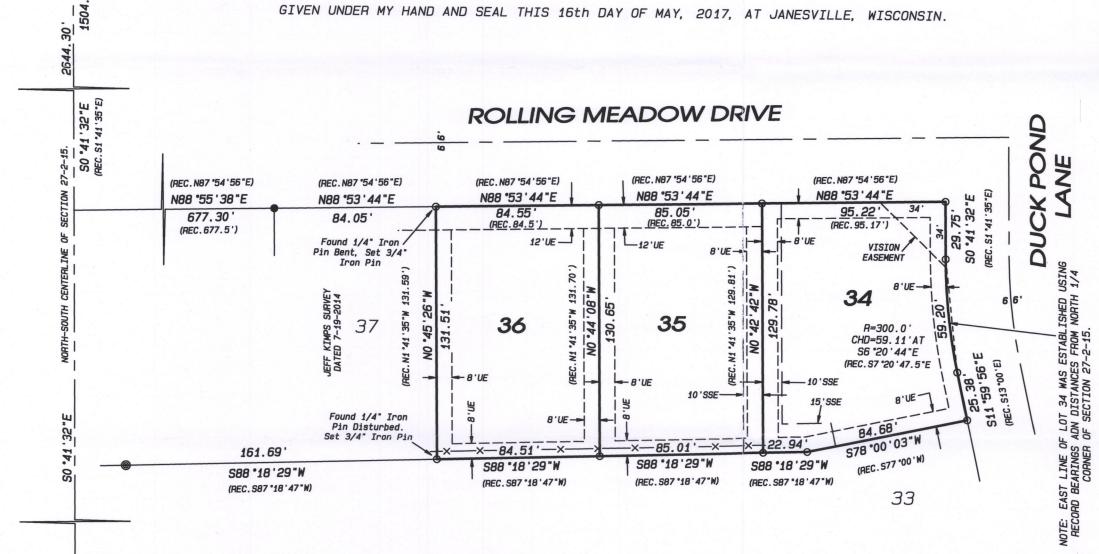

NOTES:

FIELD WORK COMPLETED MAY 12, 2017.


THIS SURVEY IS SUBJECT TO ANY AND ALL EASEMENTS AND AGREEMENTS, RECORDED AND UNRECORDED.


ASSUMED SO *41'32"E ALONG THE NORTH-SOUTH CENTERLINE OF SECTION 27-2-15.



RONALD J. COMBS. PLS NO. 1330

If the surveyor's signature is not red in color, the map is a copy and may contain unauthorized alterations. The certification contained hereon shall not apply to any copies.

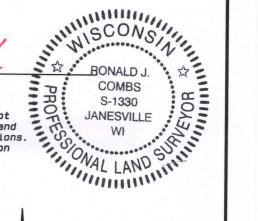

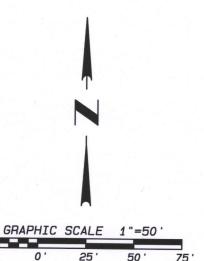

LEGEND:

- O SET IRON PIN, 3/4"x 24", 1.5 LBS./LIN.FT.
- FOUND 1/4" IRON PIN
- FOUND IRON PINCH PIPE
- ∅ FOUND DISK IN CONCRETE

UE UTILITY EASEMENT

SSE STORM SEWER EASEMENT

-x-x- FENCE



· LAND SURVEYING

· LAND PLANNING

109 W. Milwaukee St. Janesville, WI 53548

tel: 608 752-0575 fax: 608 752-0534 www.combssurvey.com

Project No. 117 - 171 For: GADDINI

NORTH 1/4 CORNER OF SECTION 27-2-15.

2

CENTER OF

Ø SECTION 27-2-15.