


GEORGE T. DUNHAM
NOTARY & SURVEYOR
DELAVAL, WISCONSIN

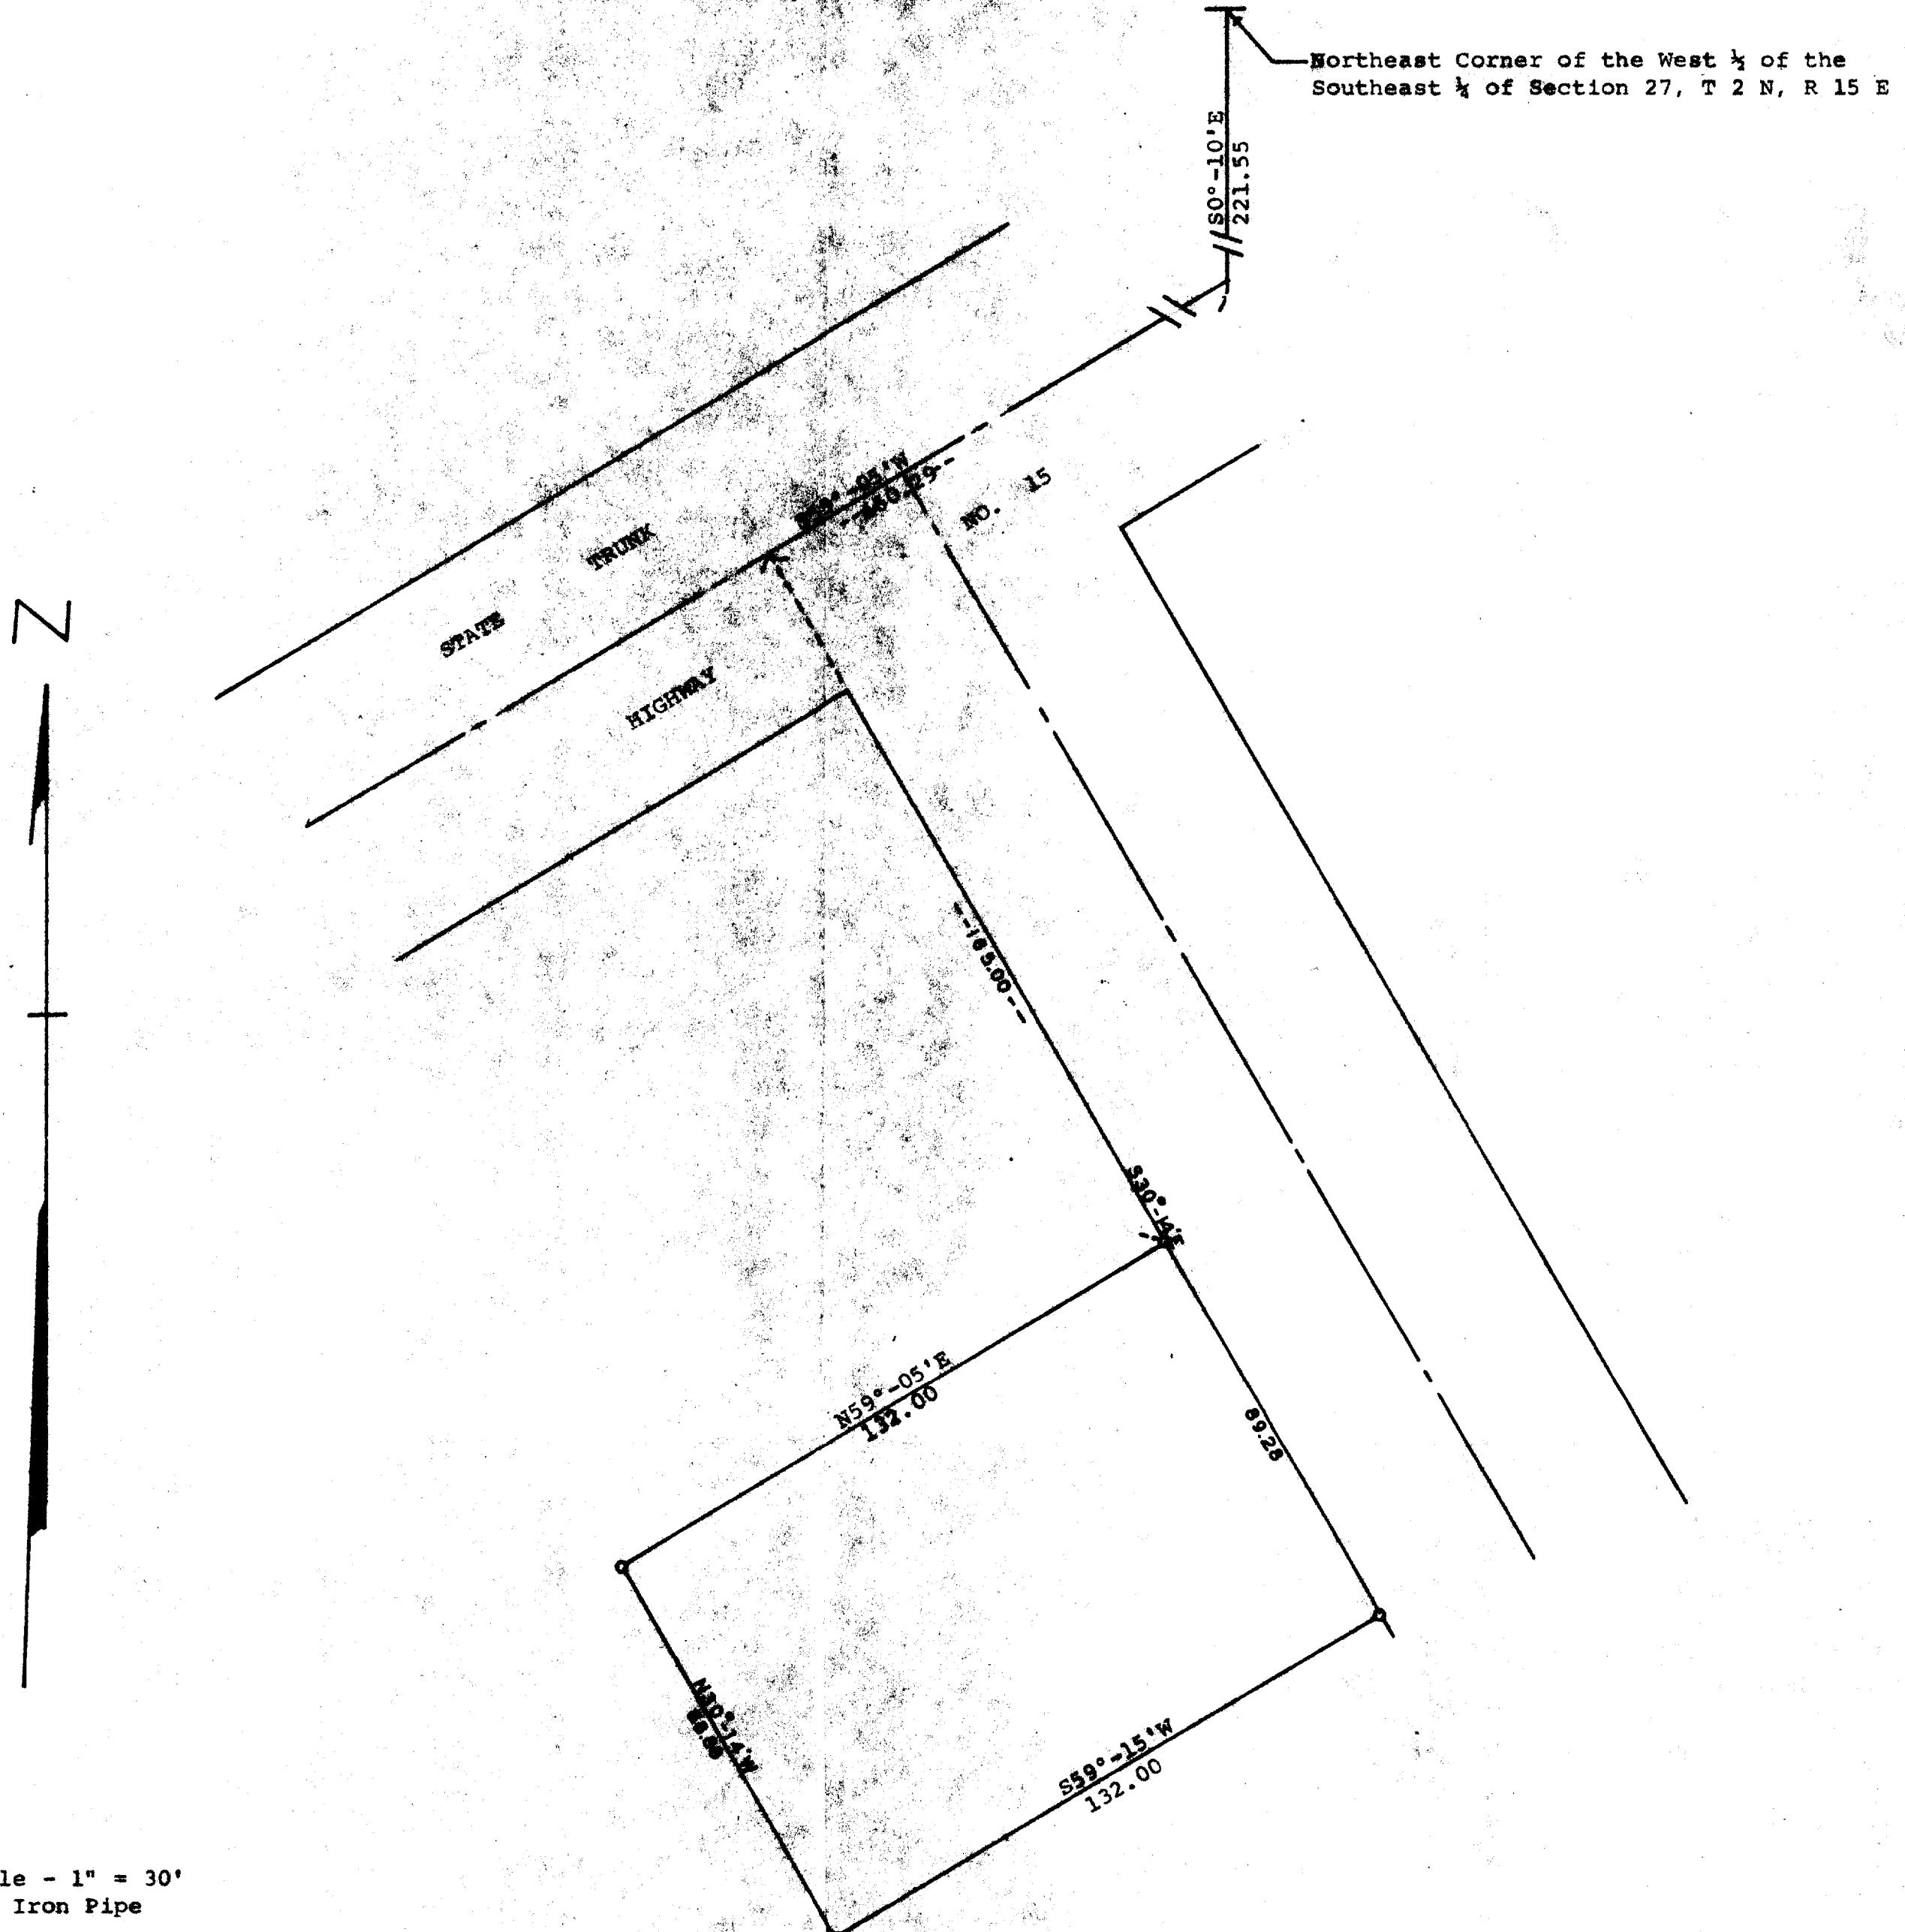

STATE OF WISCONSIN, ss
COUNTY OF WALWORTH)


I, George T. Dunham, Surveyor, certify that I have surveyed the property described as follows.

A parcel of land located in the West $\frac{1}{4}$ of the Southeast $\frac{1}{4}$ of Section 27, T2N, R15E, Village of Darien, Walworth County, Wisconsin, described as follows: to-wit: Commencing at the northeast corner of said West $\frac{1}{4}$, thence 80°10'E 221.55 feet to the centerline of State Trunk Highway No. 15; thence 80°08'W along the centerline of said highway 165.00 feet; thence S30°14'E 88.88 feet to the place of beginning; thence continue S30°14'E 88.88 feet; thence S59°15'W 132.00 feet; thence N30°14'W 88.88 feet; thence N59°05'E 132.00 feet to the place of beginning.

and that the above plat is an accurate survey and a true representation thereof and correctly shows the exterior boundary lines and that there are no buildings on said land at the present time.

March 7, 1974

George T. Dunham
George T. Dunham, Surveyor

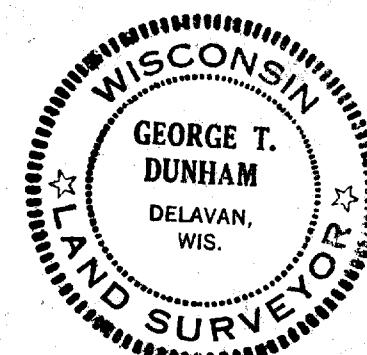

QD 04-1204

TD-120 (part of