


DUNHAM SURVEYING, S.C.
SURVEYING & SUBDIVISION
DELAVER, WISCONSIN 53115

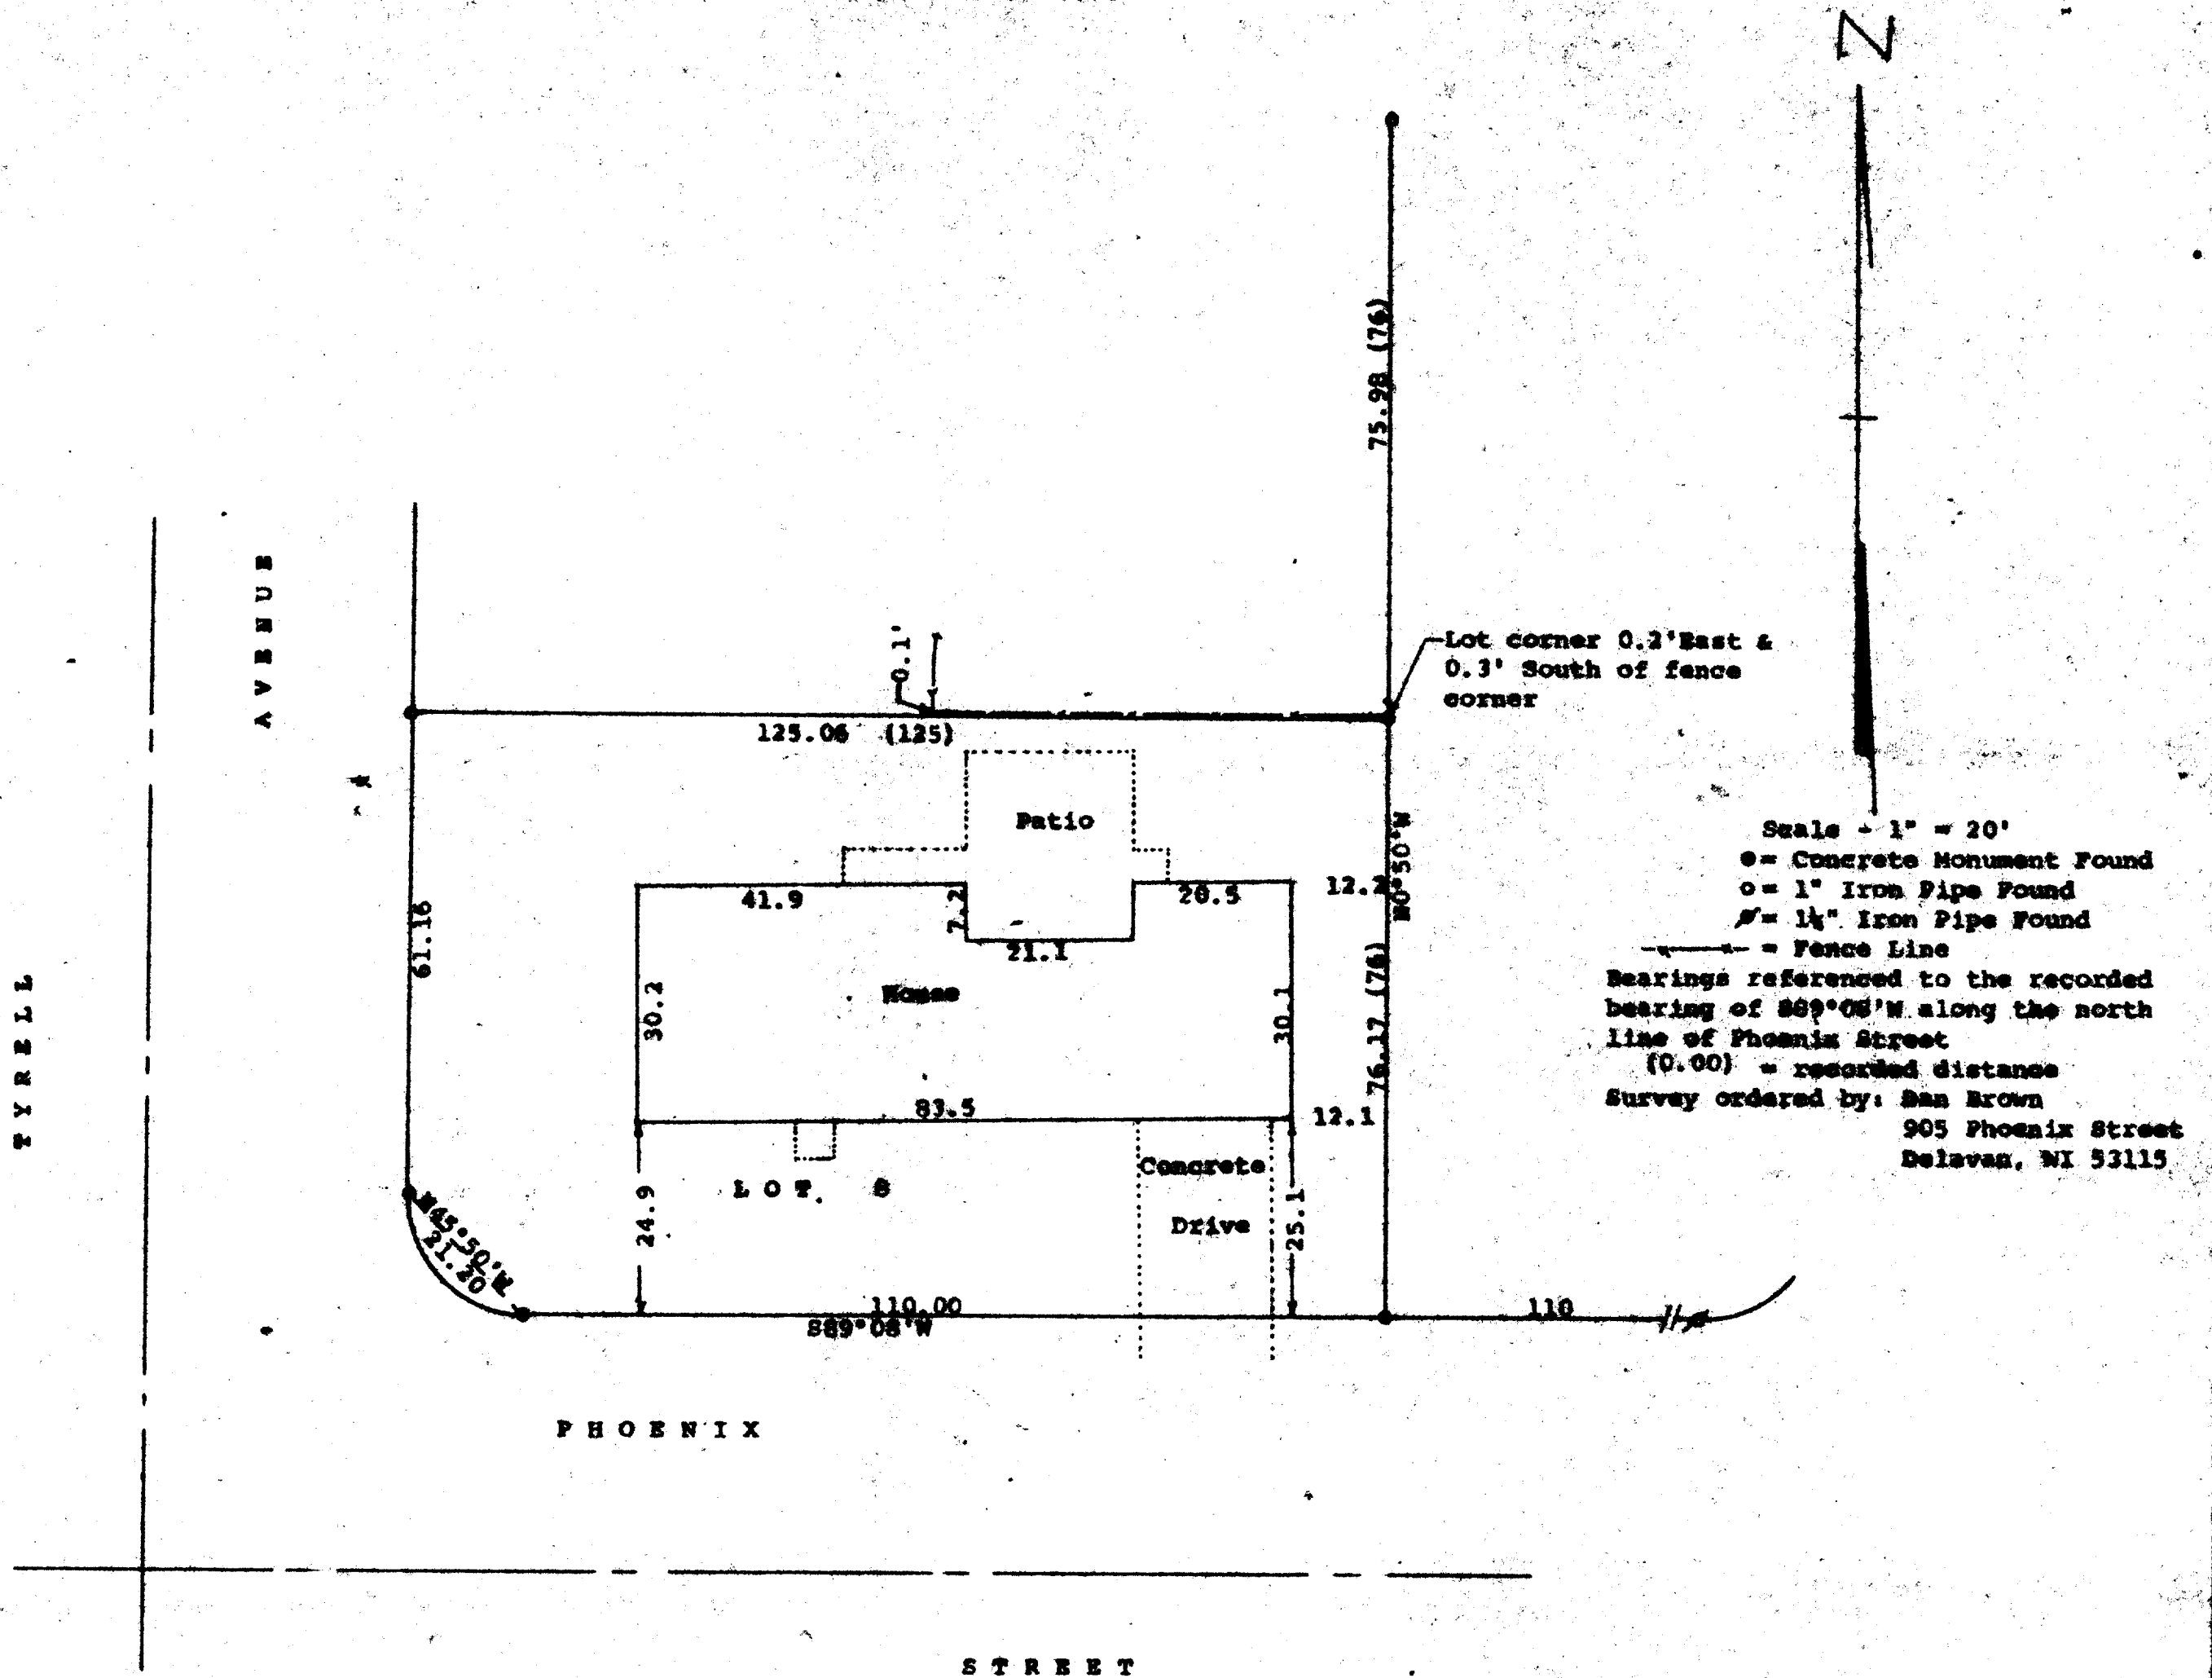



STATE OF WISCONSIN) SS
COUNTY OF WALNORTH)

I, George T. Dunham, Surveyor, certify that I have surveyed the property described as follows:

Lot 8 in Block 4 of Allynhurst Subdivision located in the City of Delavan, Walworth County, Wisconsin, and that the plat shown above is a correct representation thereof and shows the size and location of the property, its exterior boundaries, the location of all visible structures and dimensions of all principal buildings thereon, boundary fences, apparent easements, roadways and visible encroachments, if any, that the I have surveyed the property hereon described, according to the official records, to the best of my knowledge and belief.

June 29, 1989

George T. Dunham
George T. Dunham, Surveyor

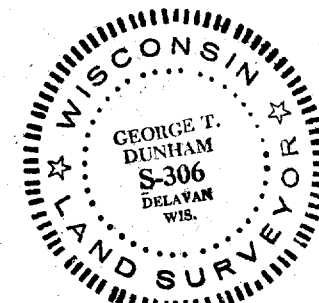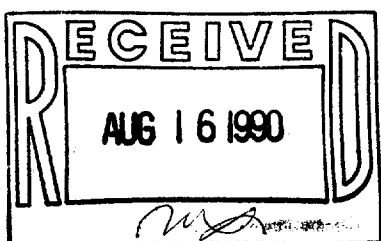

TAX KEY # XAS 6/6/48