


ABELL SURVEYING & MAPPING

DELAVAN, WISCONSIN 53115

414-728-6737

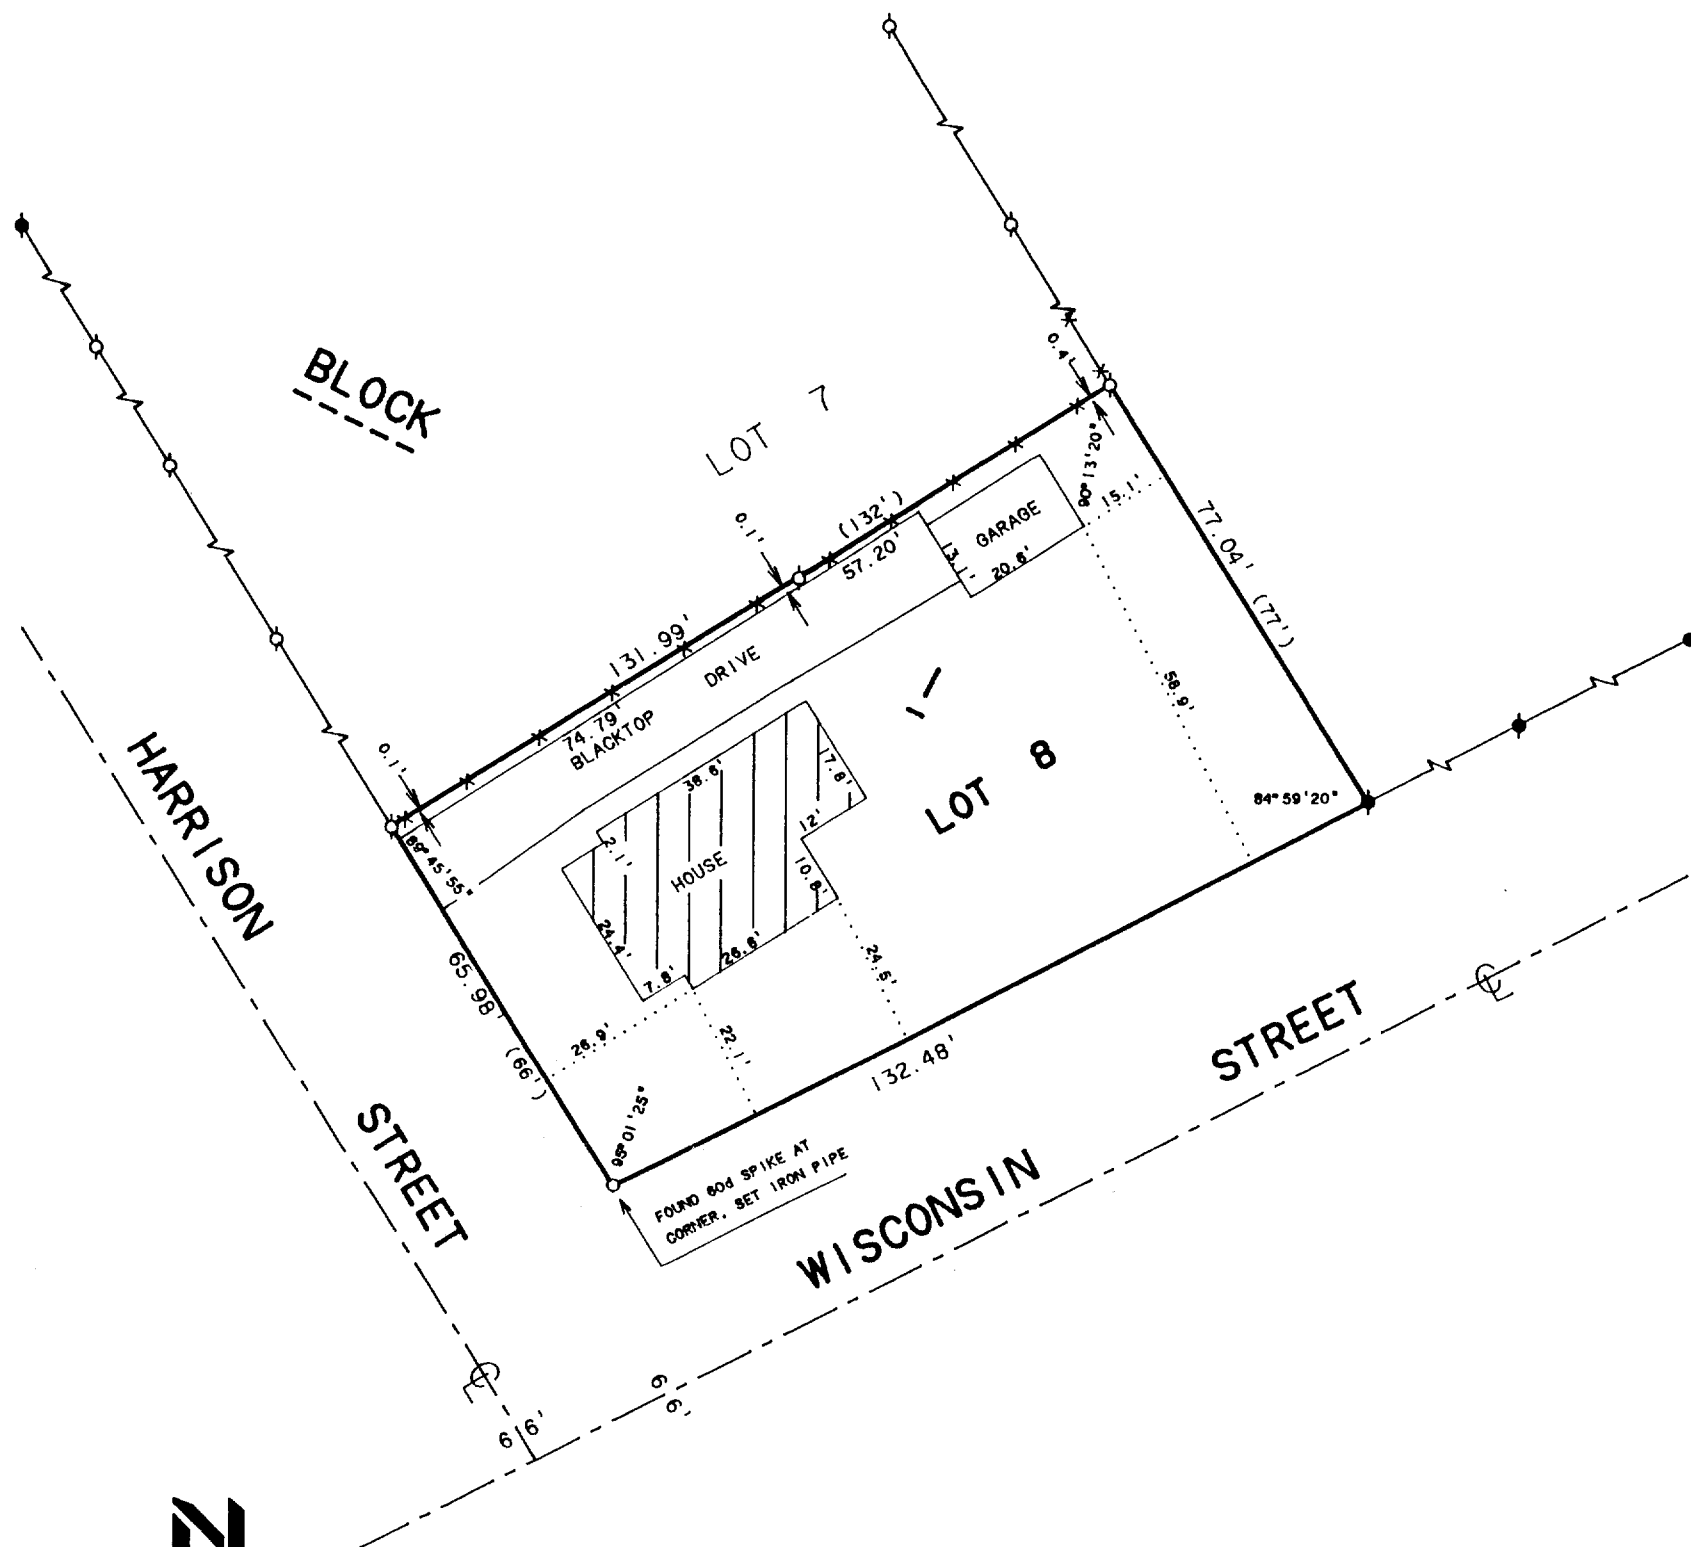


LEGEND

- - IRON PIPE FOUND
- ◆ - IRON ROD FOUND
- - CONCRETE MONUMENT FOUND
- - IRON PIPE SET
- * - CHAINLINK FENCE
- () - RECORDED AS

PLAT OF SURVEY OF

LOT 8, BLOCK 1, LARNARDS SUBDIVISION, CITY OF
DELAVAN, WALWORTH COUNTY, WISCONSIN.

ORDERED BY: CENTURY 21 - SKANDIA REALTY, INC
312 S. 7th STREET
DELAVAN, WI. 53115

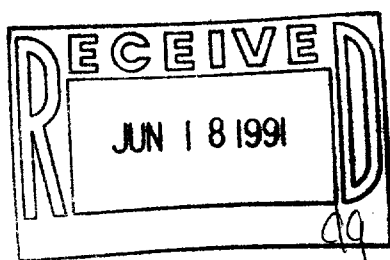

I, DAVID F. ABELL, DO HEREBY CERTIFY THAT I HAVE SURVEYED THE PROPERTY HEREON DESCRIBED ACCORDING TO THE OFFICIAL RECORDS AND THAT THE PLAT HEREON IS A CORRECT REPRESENTATION OF THE PROPERTY LINES TO THE BEST OF MY KNOWLEDGE AND BELIEF.

David F. Abell

DAVID F. ABELL

WISCONSIN REGISTERED LAND SURVEYOR, S-1596

April 17, 1991

DATE

JOB NUMBER - 91068

NOTE: THIS IS NOT A CERTIFIED COPY UNLESS SEALED.

002-1067

XLDA 00009