


N
SCALE 1"=20'
0"=IRON PIPE

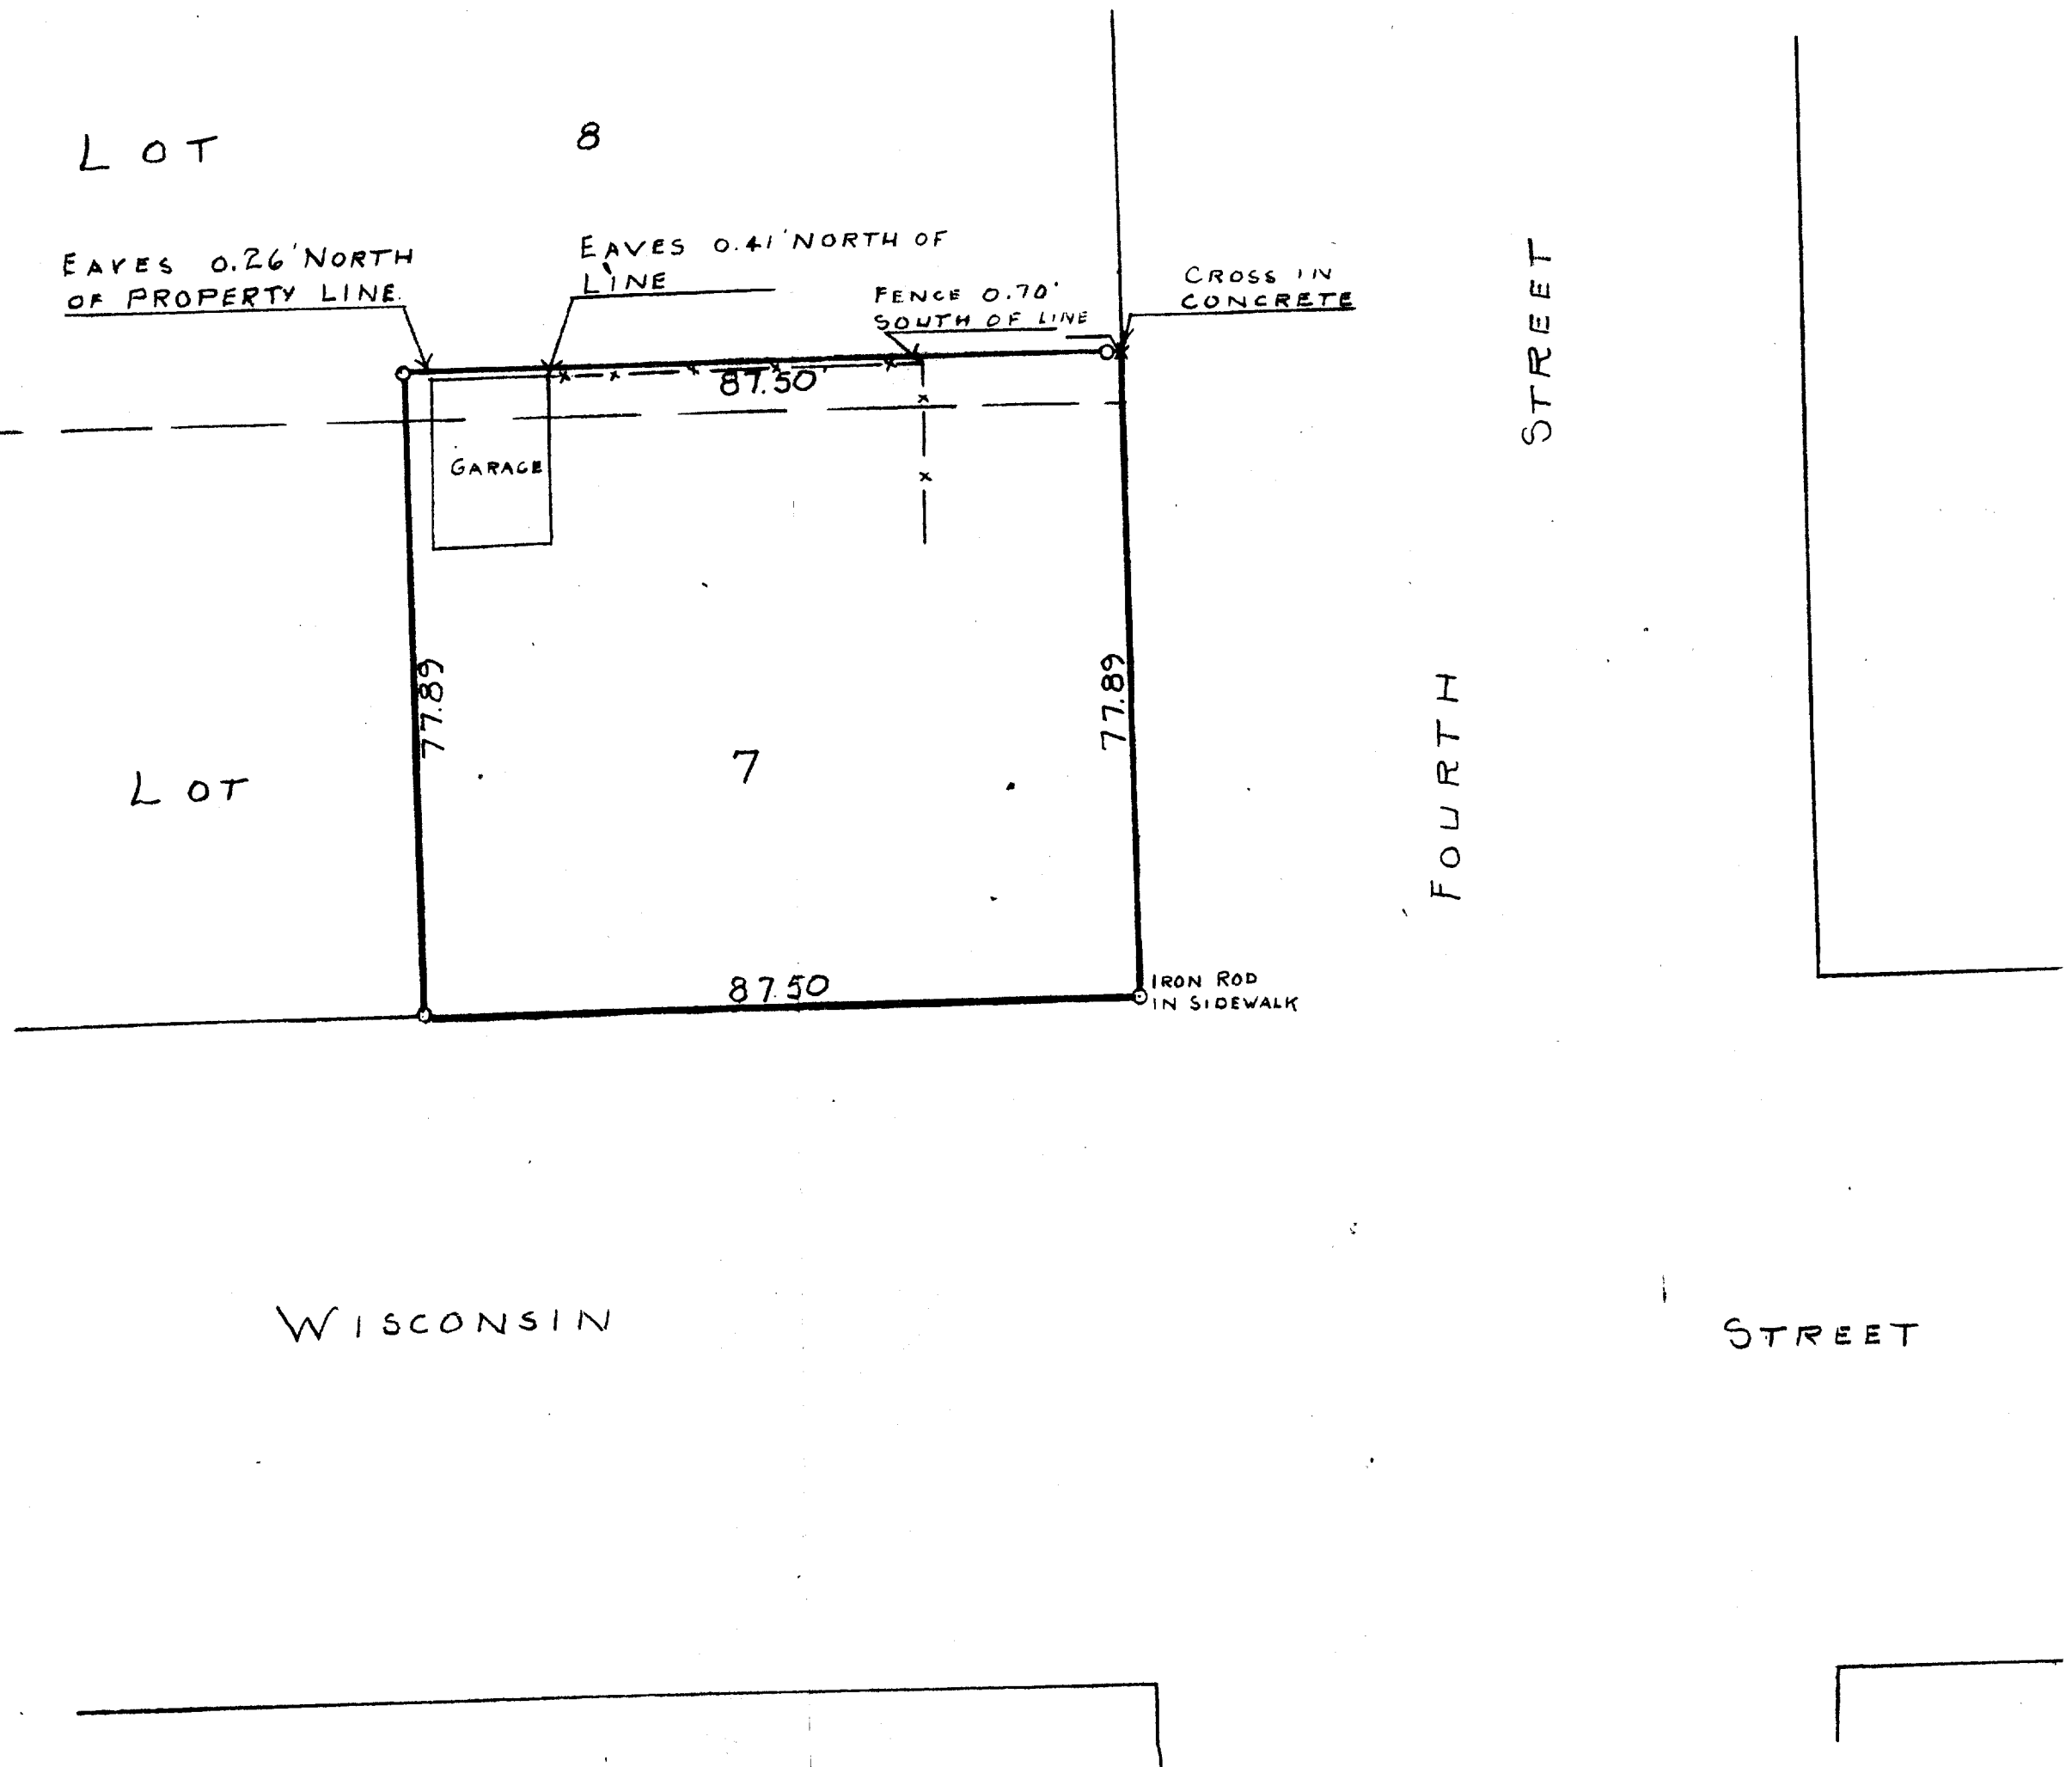

PLAT OF SURVEY OF PART OF LOTS 7 AND 8, BLOCK 18 OF
ANN PHOENIX ADDITION, CITY OF DELAVAN, WALWORTH COUNTY,
WISCONSIN
OCT 18, 1955

George T. Dunham
GEORGE T. DUNHAM, SURVEYOR
DELAVAN, WISCONSIN

2-11 ✓

XPAR 11