
DUNHAM SURVEYING, S.C.

SURVEYING & SUBDIVIDING DELAVAN, WISCONSIN 53115

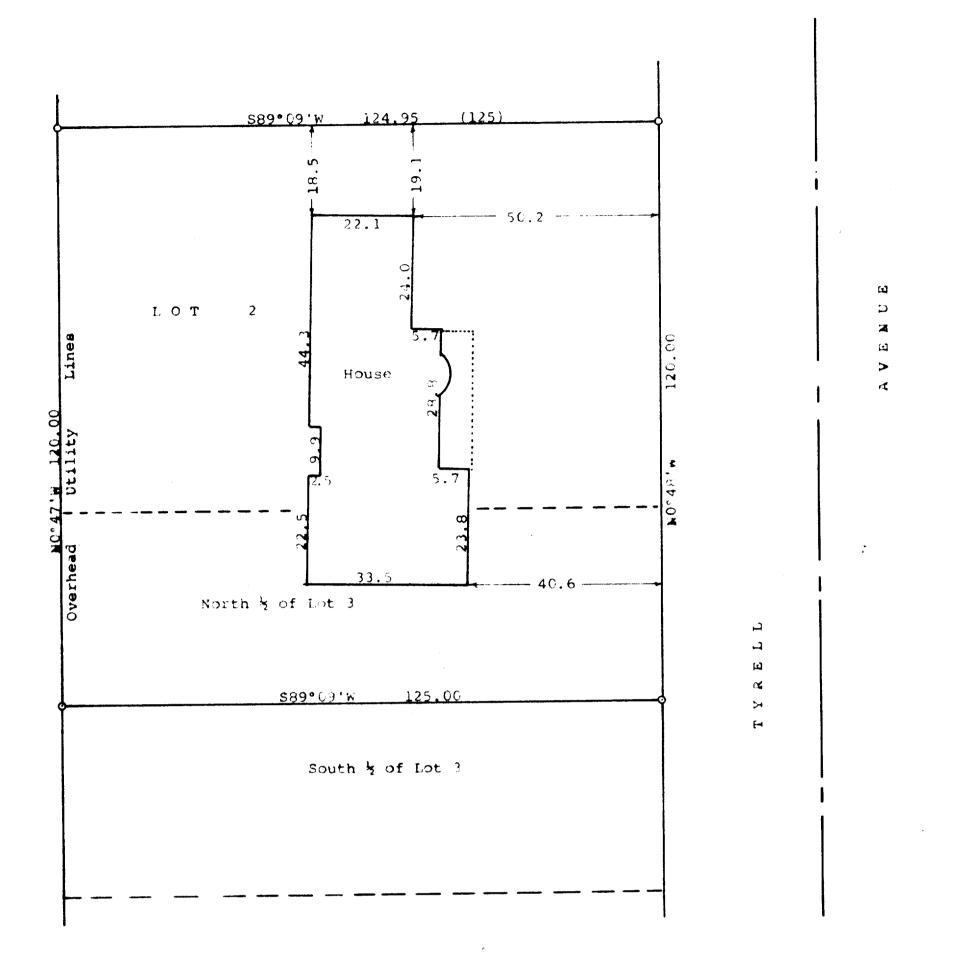

Scale -1" = 20'o = 1" Iron Pipe Found (0.00) = recorded distance Bearings referenced to the recorded bearing of NO°48'W along the west line of Tyrell Avenue. Survey ordered by: Dennis Positano 608 Tyrell Avenue Delavan, WI 53115

STATE OF WISCONSIN) SS

COUNTY OF WALWORTH)

I. George T. Dunham, Surveyor, certify that I have surveyed the property described as follows:

Lot 2 and the North 5 of Lot 3, located in Block 5 of Allynhurst Subdivision located in the City of Delavan, Walworth County,

Wisconsin, and that the plat shown hereon is a correct representation thereof and shows the size and location of the property, its exterior boundaries, the location of all visible structures and dimensions of all principal buildings thereon, boundary fences, apparent easements, roadways and visible encroachments, if any, and that I have surveyed the property hereon described, according to the official records, to the best of my knowledge and belief. May 8, 1991

George A. Dunham, Surveyor



