


**WALWORTH COUNTY
SURVEYING & MAPPING**
727 HENRY STREET
LAKE GENEVA, WISCONSIN
414-248-0505


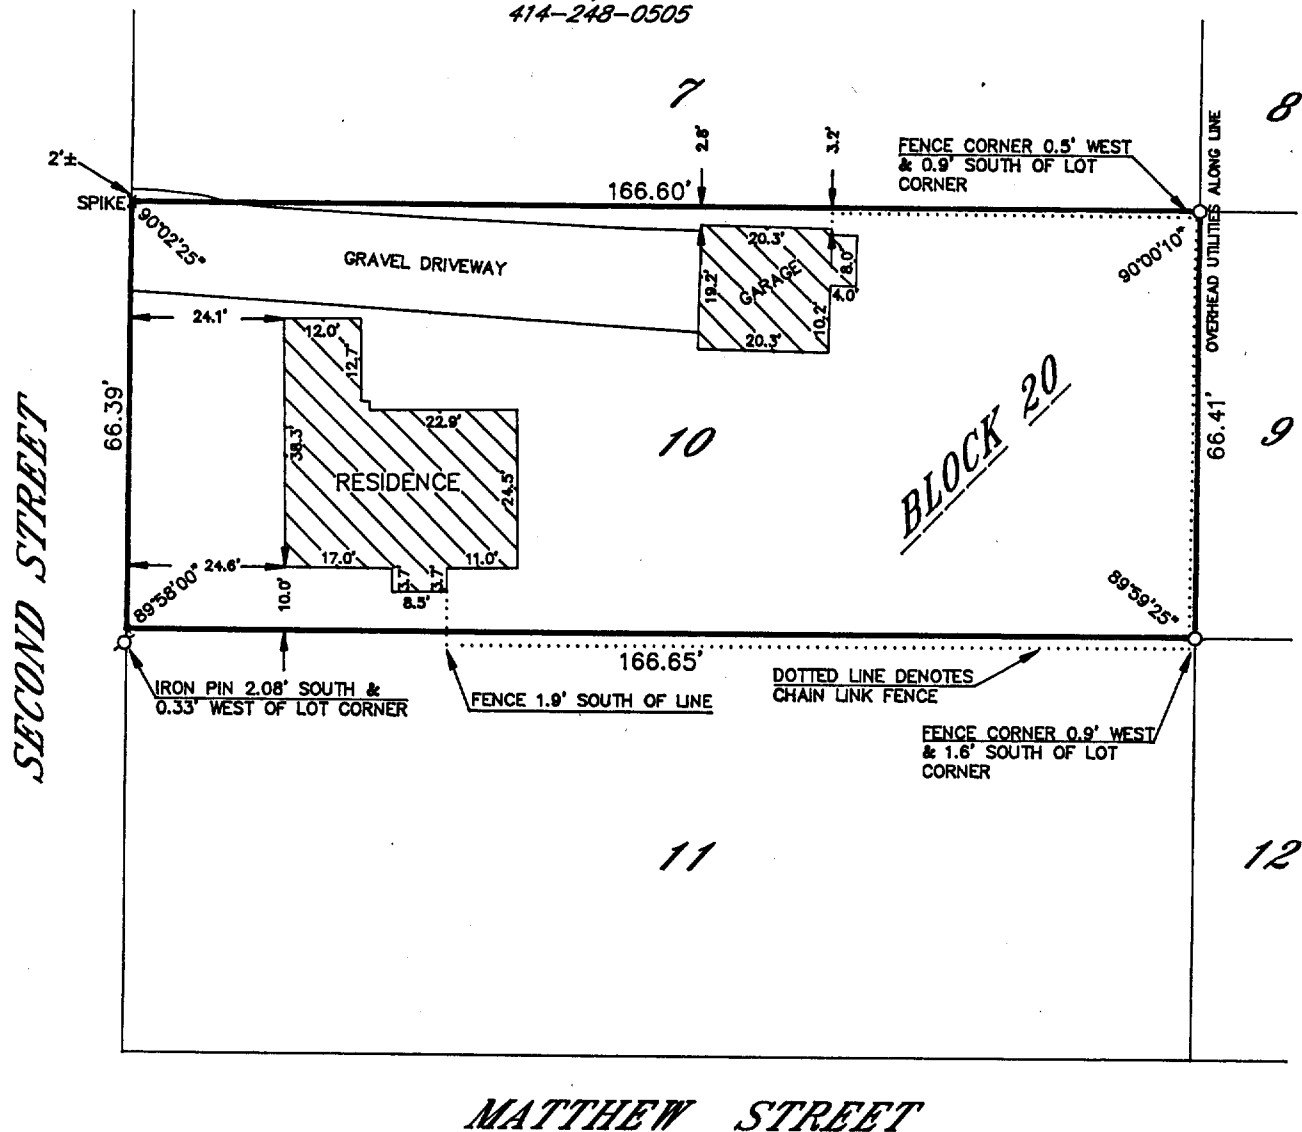


MATTHEW STREET

PLAT OF SURVEY OF

LOT 10, BLOCK 20 OF THE ORIGINAL PLAT OF THE CITY
OF DELAVAN, WALWORTH COUNTY, WISCONSIN.

ORDERED BY: SCOTT MARTIN
317 SOUTH SECOND STREET
DELAVAN, WISCONSIN

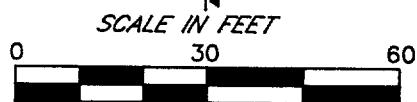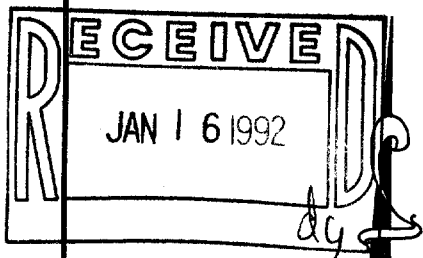

LEGEND
 (S) IRON PIPE FOUND
 (R) IRON ROD FOUND
 (C) CONCRETE MONUMENT FOUND
 (O) IRON PIPE PLACED
 (D) RECORDED AS

I HEREBY CERTIFY THAT I HAVE SURVEYED THE ABOVE DESCRIBED
PROPERTY AND THAT THE ABOVE MAP IS A TRUE REPRESENTATION
THEREOF AND SHOWS THE SIZE AND LOCATION OF THE PROPERTY,
ITS EXTERIOR BOUNDARIES, THE LOCATION OF ALL VISIBLE STRUCTURES
AND DIMENSIONS OF ALL PRINCIPAL BUILDINGS THEREON, BOUNDARY
FENCES, APPARENT EASEMENTS, ROADWAYS AND VISIBLE ENCROACH-
MENTS, IF ANY, TO THE BEST OF MY KNOWLEDGE AND BELIEF.

THIS SURVEY IS MADE FOR THE USE OF THE PRESENT OWNERS OF
THE PROPERTY AND ALSO THOSE WHO PURCHASE, MORTGAGE OR
GUARANTEE THE TITLE THERETO WITHIN ONE (1) YEAR FROM DATE
HEREOF.

Robert M. Baerenwald
ROBERT M. BAERENWALD
WISCONSIN REGISTERED LAND SURVEYOR, S-1508

DATE *Jan. 8, 1991* JOB NO. 2785

NOTE: THIS IS NOT A CERTIFIED COPY UNLESS SEALED.