
## DUNHAM SURVEYING, S.C. SURVEYING & SUBDIVIDING DELAYAN, WISCONSIN 53H5

BIRCHWOOD

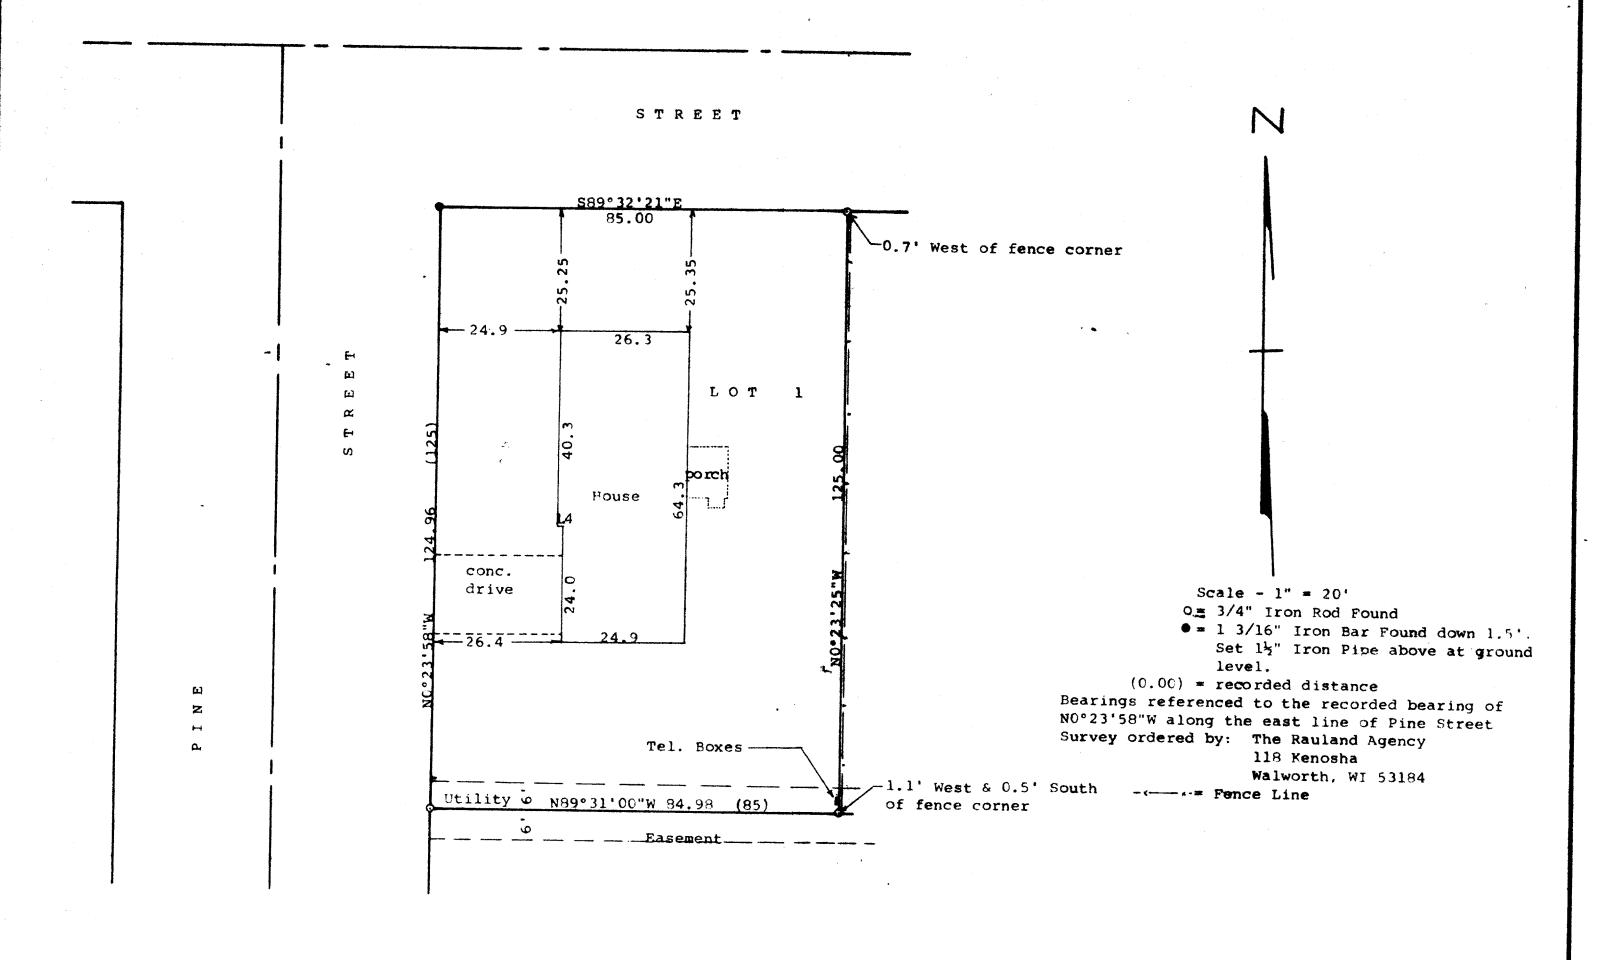

STATE OF WISCONSIN) SS COUNTY OF WALWORTH)

I. George T. Dunham, Surveyor, certify that I have surveyed the property described as follows:

Lot 1 in Turtle Creek, a subdivision located in the Southeast 1 of Section 13, T 2 N, R 15 E, City of Delavan, Walworth County, Wisconsin and that the plat shown hereon is a correct representation thereof and shows the size and location of the property, its exterior boundaries, the location of all visible structures and dimensions of all principal buildings thereon, boundary fences, apparent easements, roadways and visible encroachments, if any, and that I have surveyed the property hereon described, according to the official records, to the best of my knowledge and belief January 12, 1993

George T Duphan Surveyon

