


DUNHAM SURVEYING, S.C.  
SURVEYING & SUBDIVIDING  
DELAVER, WISCONSIN 53115

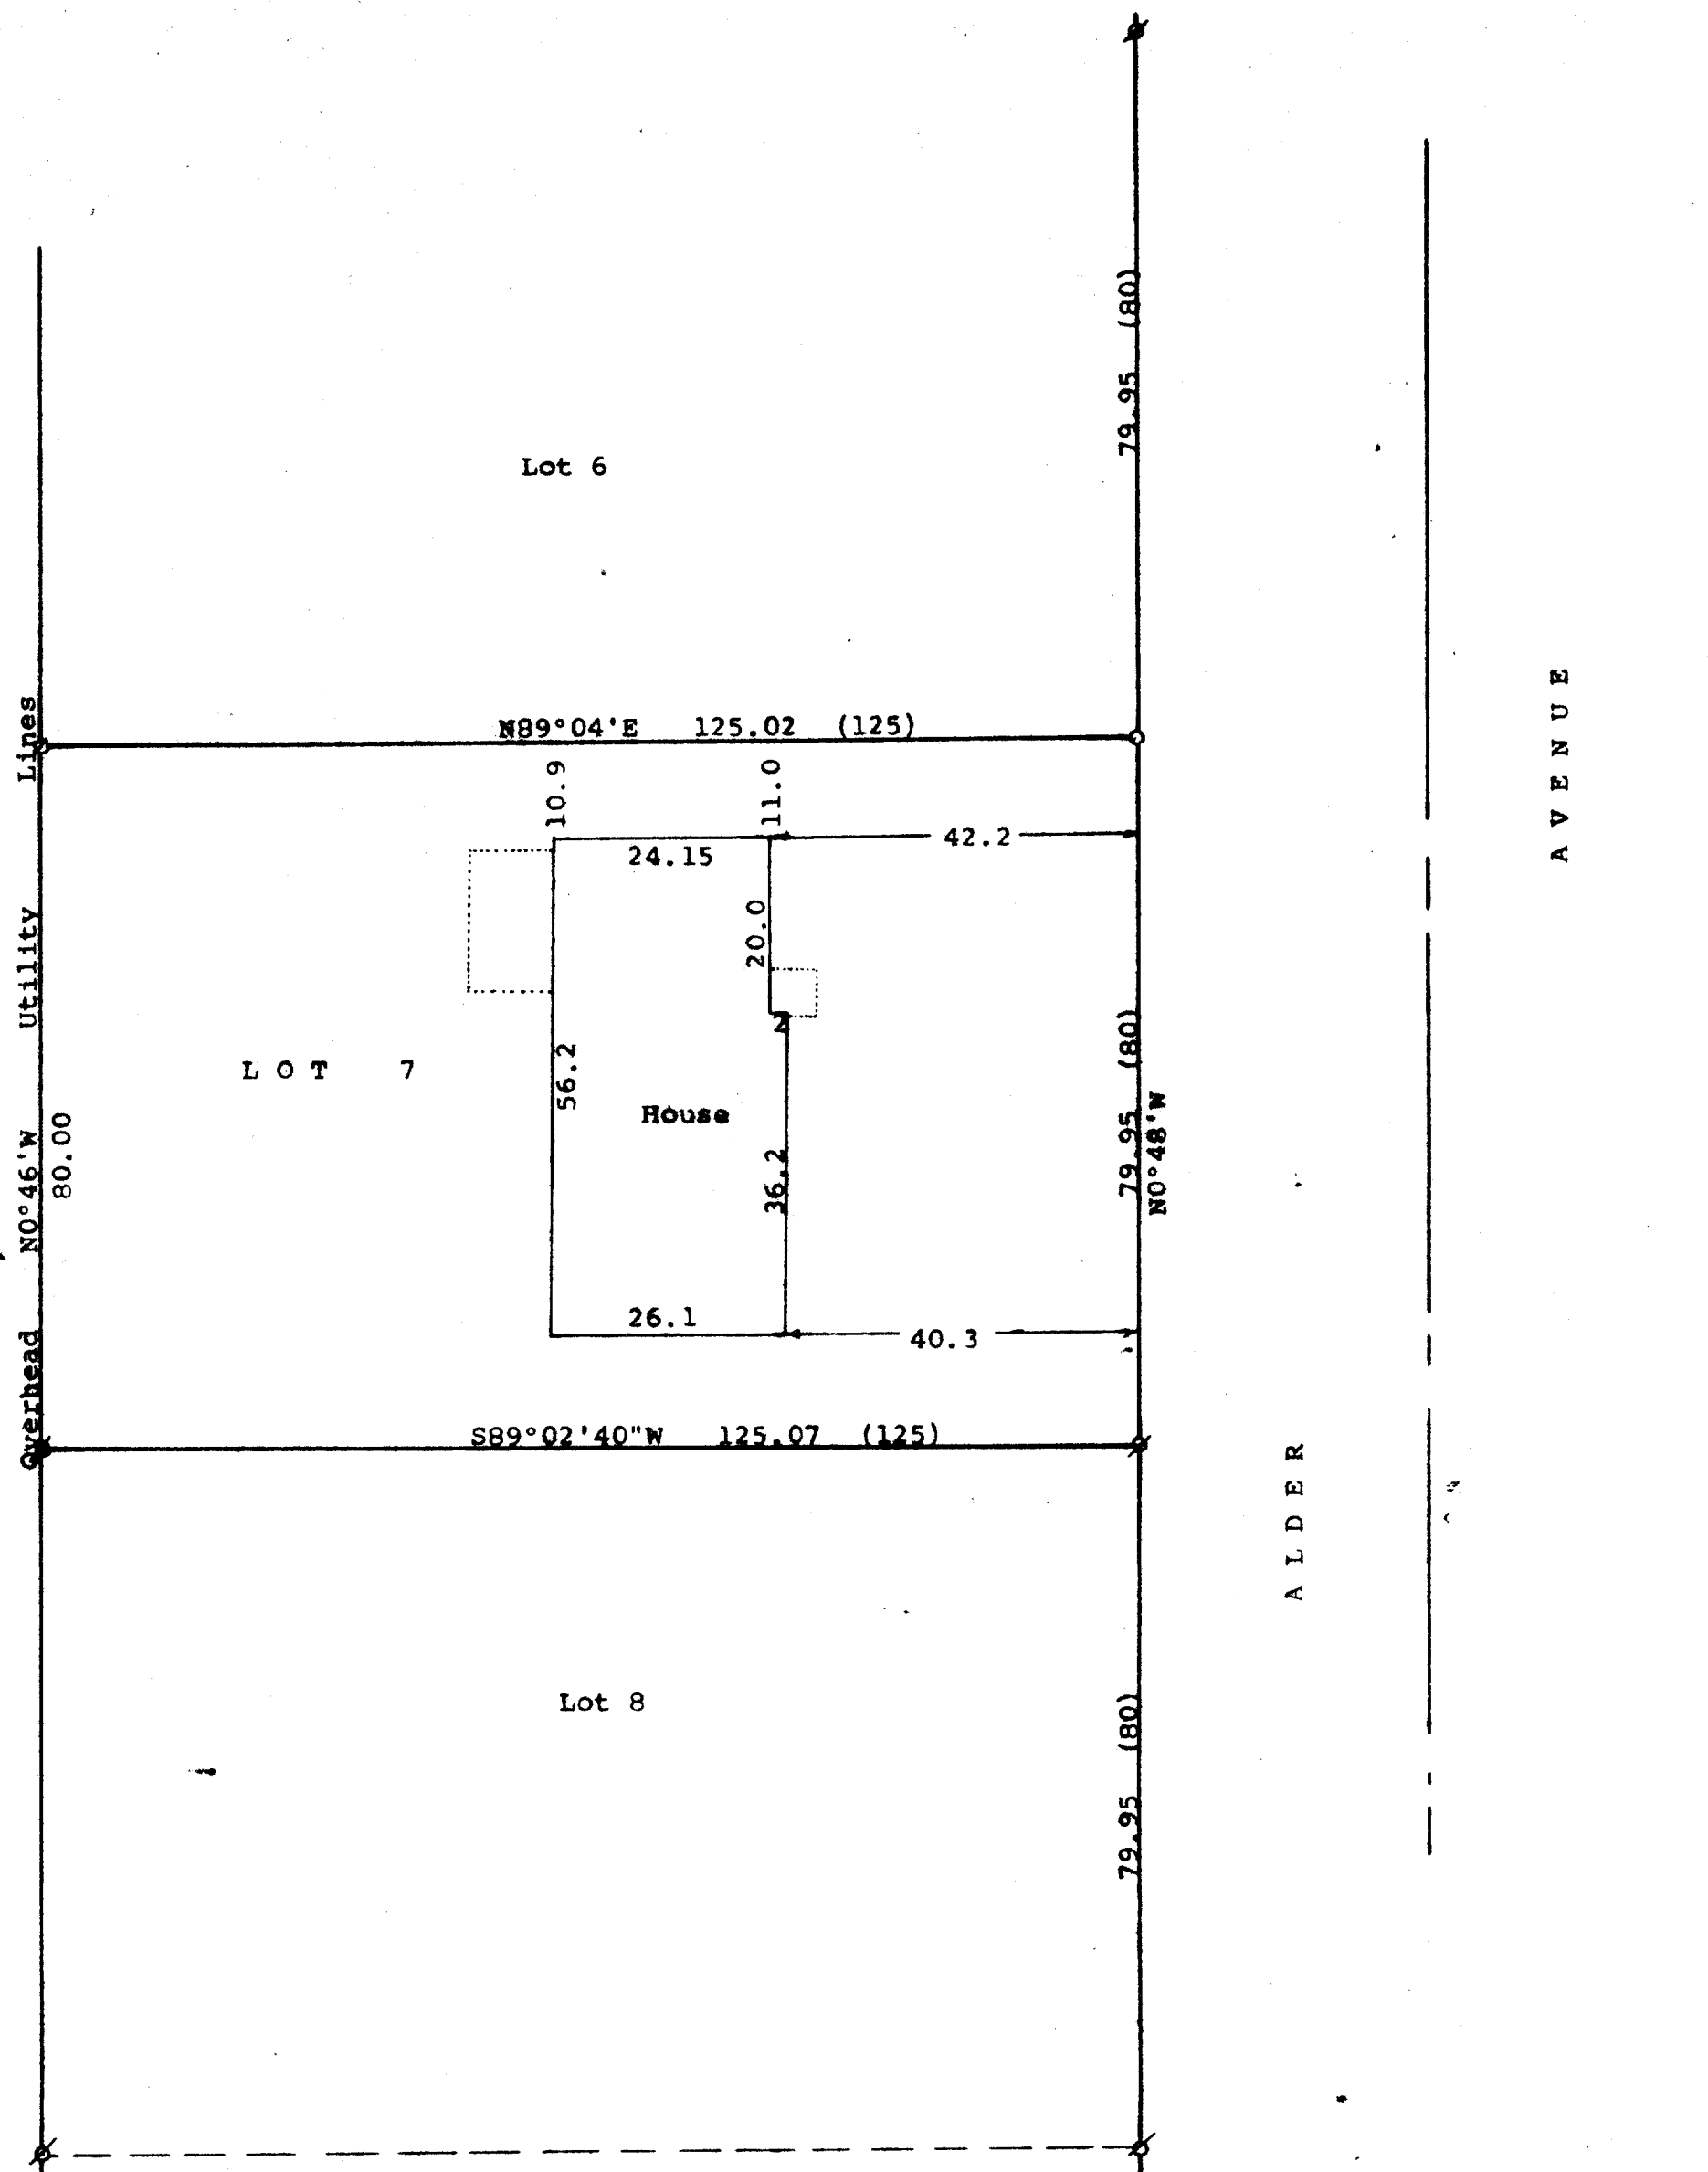

N

Scale - 1" = 20'  
 P = 1" Iron Pipe Found  
 R = 3/4" Iron Rod Found  
 O = 1" X 24" Iron Pipe Set  
 Bearings referenced to the west line of  
 Alder Avenue with the recorded bearing  
 of N0°48'W  
 Survey ordered by:  
 Century 21, Skandia Realty  
 312 South 7th Street  
 Delavan, WI 53115

STATE OF WISCONSIN)  
 COUNTY OF WALWORTH) SS

I, George T. Dunham, Surveyor, certify that I have surveyed the property  
 described as follows:

Lot 7 in Block 3 of Allynhurst Subdivision located in the City of Delavan,  
 Walworth County, Wisconsin, subject to easements of record,  
 and that the plat shown hereon is a correct representation thereof and shows  
 the size and location of the property, its exterior boundaries, the location  
 of all visible structures and dimensions of all principal buildings thereon,  
 boundary fences, apparent easements, roadways and visible encroachments, if  
 any, and that I have surveyed the property hereon described, according to the  
 official records, to the best of my knowledge and belief.  
 October 26, 1992

*George T. Dunham*  
 George T. Dunham, Surveyor

