


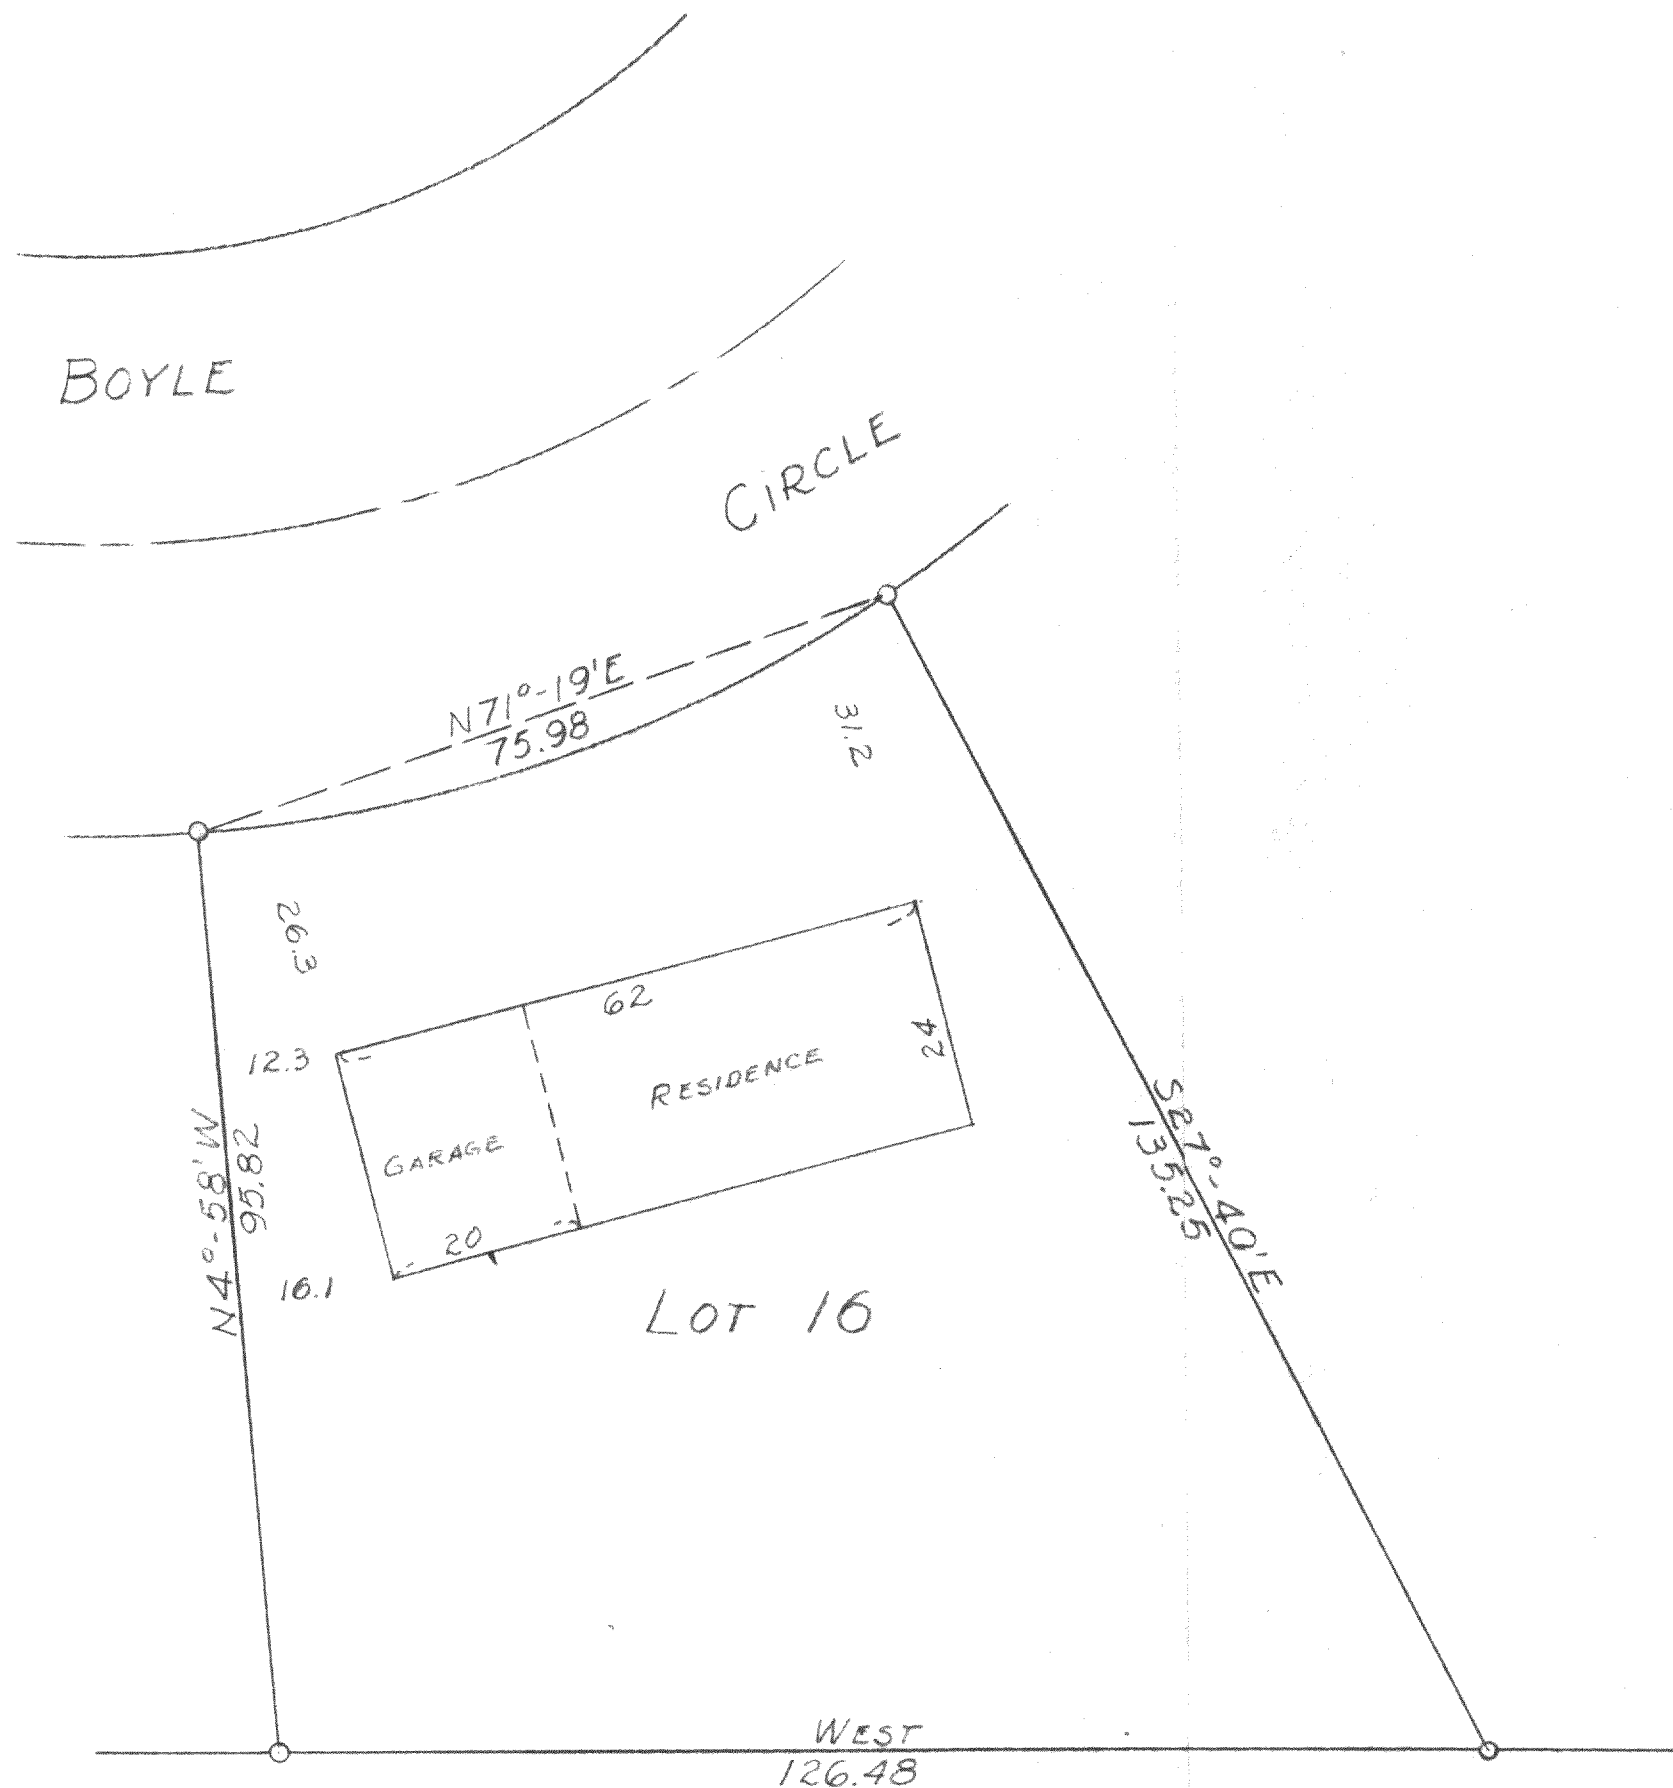

N

SCALE ~ 1" = 20'
 O ~ IRON PIPE

STATE OF WISCONSIN } S.S.
 WALWORTH COUNTY }

I, GEORGE T. DUNHAM, DO HEREBY CERTIFY THAT I HAVE SURVEYED THE PROPERTY DESCRIBED AS FOLLOWS:

LOT 16 OF HILLTOP SUBDIVISION LOCATED IN THE CITY OF DELAVAN, WALWORTH COUNTY, WISCONSIN

AND THAT THIS PLAT IS A CORRECT REPRESENTATION OF THE PROPERTY AND OF THE IMPROVEMENTS LOCATED THEREON.

JULY 31, 1958

GEORGE T. DUNHAM, SURVEYOR
 DELAVAN, WISCONSIN.

2-120