


DUNHAM SURVEYS, S.C.

1000 1/2 S. 10th St.
Delavan, Wis. 53115

Best Iron Pipe Found 8/4/92
Pulled and reset 3/4" x
3/4" Iron Pipe

Lot corner 0.4' N. & 0.3' E
of fence corner

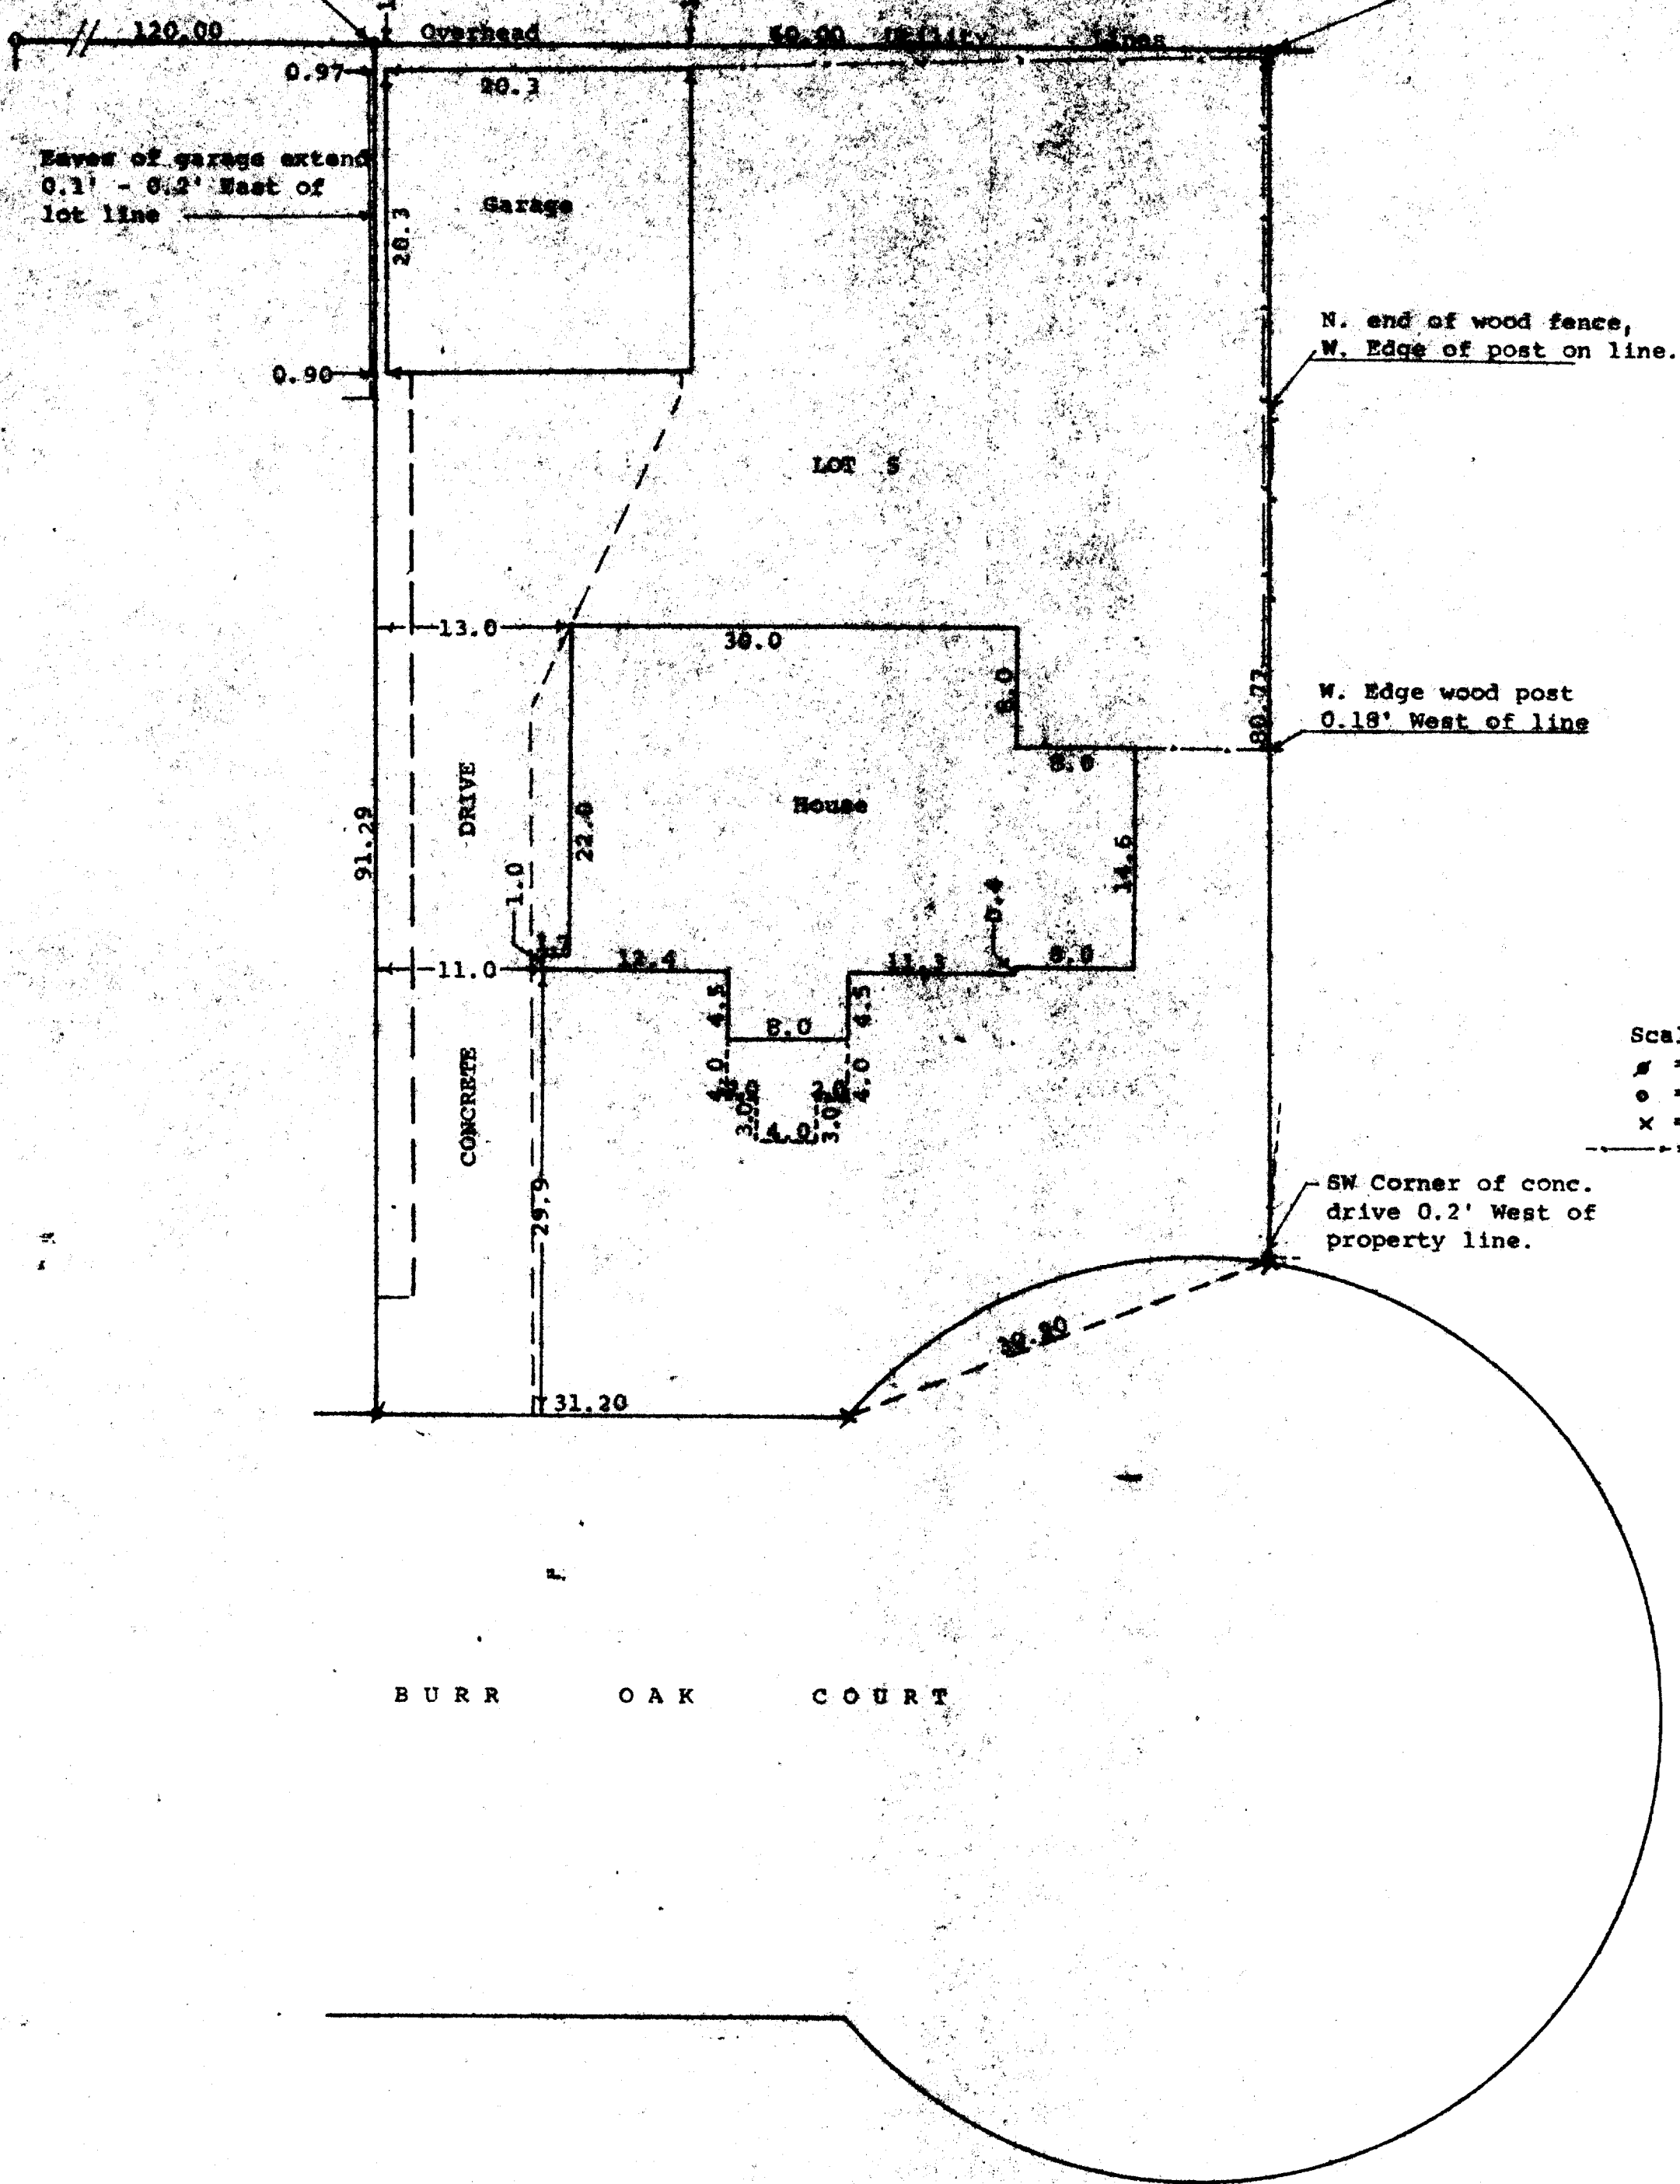

BURR OAK COURT

STATE OF WISCONSIN)
COUNTY OF WALNORTH)

I, George T. Dunham, Surveyor, certify that I have surveyed the property described as follows:

Lot 5 of Burr Oak Subdivision, located in the City of Delavan, Walworth County, Wisconsin.

and the above plat is a true representation thereof and shows the size and location of the property, its exterior boundaries, the location and dimensions of all structures thereon, fences, apparent easements and roadways and visible encroachments, if any.

This survey is made for the exclusive use of the present owners of the property, and also those who purchase, mortgage, or guarantee the title thereto within one (1) year from date hereof; and as to them I warrant the accuracy of said survey and map.

December 8, 1976

Updated and recertified to this 6th day of August, 1992

George T. Dunham
George T. Dunham, Surveyor

