


GENEVA

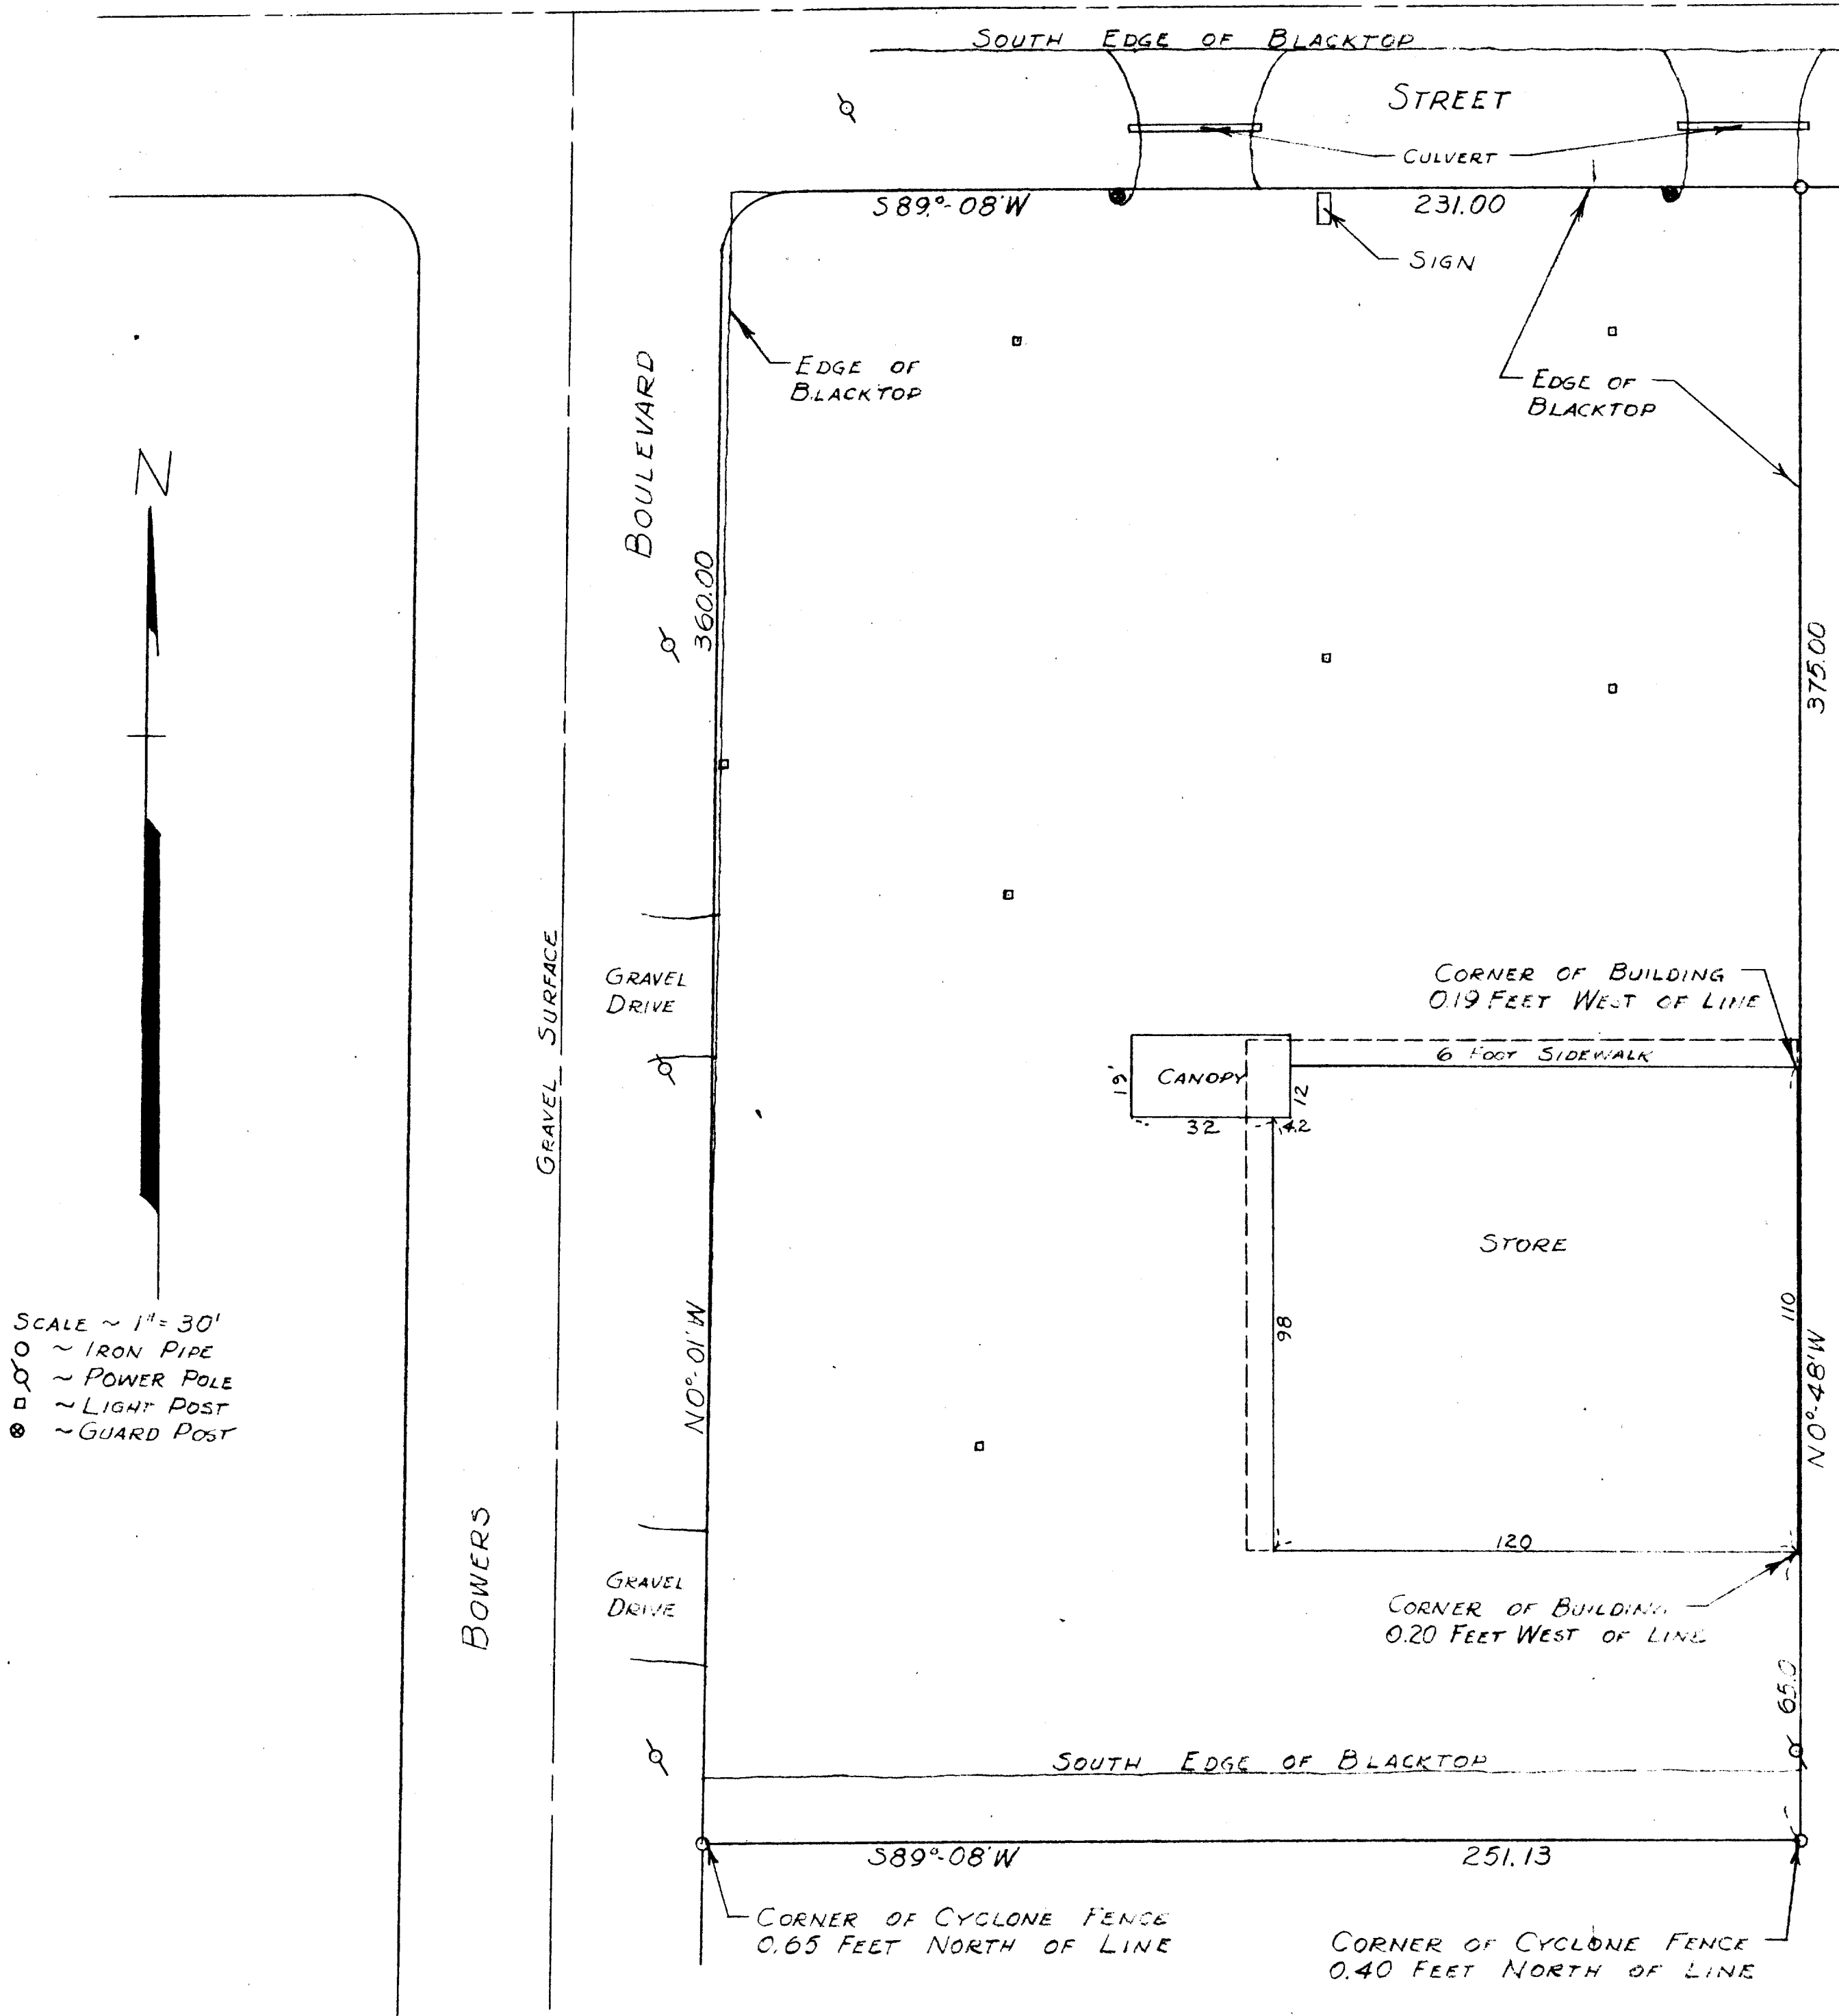

STATE OF WISCONSIN } ss.
 WALWORTH COUNTY }

I, GEORGE T. DUNHAM, DO HEREBY CERTIFY THAT THE ABOVE PLAT IS A CORRECT REPRESENTATION OF THE PROPERTY LINES AND OF THE IMPROVEMENTS LOCATED UPON THE PROPERTY LOCATED IN BLOCK 9, ALLYNHURST SUBDIVISION, CITY OF DELAVAN, WALWORTH COUNTY, WISCONSIN, WHICH IS OWNED BY THE GODFREY COMPANY AND IS KNOWN AS JENTRY FOODS, 820 GENEVA STREET, DELAVAN, WISCONSIN.
 SEPT. 2, 1958

George T. Dunham
 GEORGE T. DUNHAM, SURVEYOR
 DELAVAN, WISCONSIN