



ABELL  
SURVEYING & MAPPING  
DEHAVAN, WISCONSIN 53115  
414-728-6737

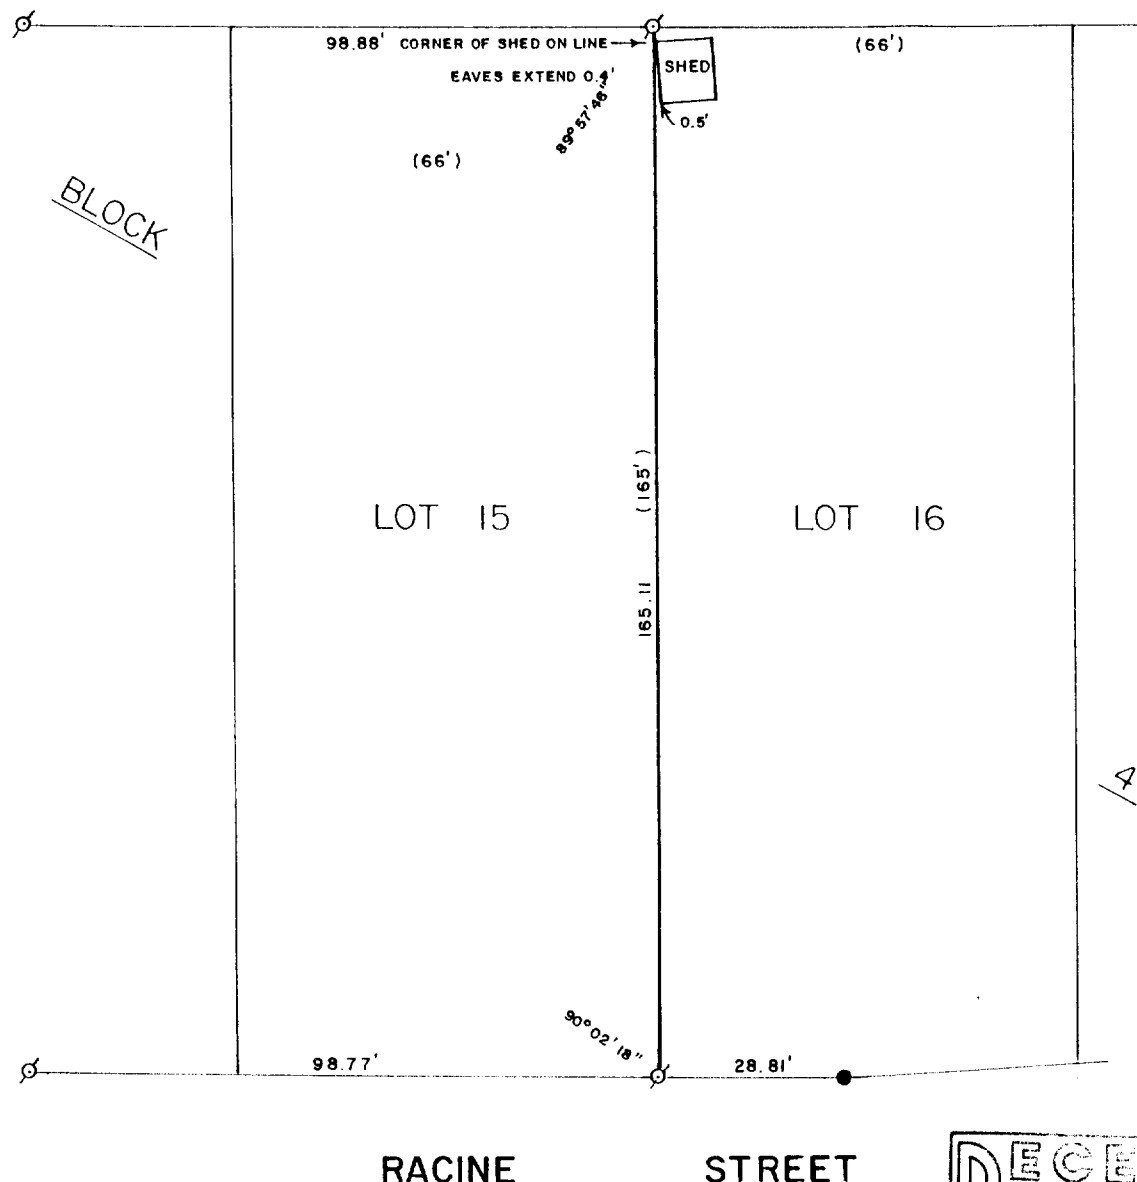

RACINE STREET

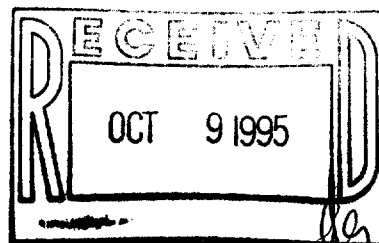

PLAT OF SURVEY OF

THE WEST LINE OF LOT 16, BLOCK 4, ELMHURST  
SUBDIVISION, CITY OF DELAVAN, WALWORTH  
COUNTY, WISCONSIN

ORDERED BY: CLAIR LAW OFFICE  
P.O. BOX 445  
DEHAVAN, WI 53115



SCALE - 1"=30'

LEGEND

- ⊙ - IRON PIPE FOUND
- - IRON ROD FOUND
- ( ) - RECORDED AS

I, DAVID F. ABELL, DO HEREBY CERTIFY  
THAT I HAVE SURVEYED THE PROPERTY  
HEREON DESCRIBED ACCORDING TO THE  
OFFICIAL RECORDS AND THAT THE PLAT  
HEREON IS A CORRECT REPRESENTATION  
OF THE PROPERTY LINES TO THE BEST OF  
MY KNOWLEDGE AND BELIEF.

*David F. Abell*  
DAVID F. ABELL

WISCONSIN REGISTERED LAND SURVEYOR, S-1596

*May 10, 1995*  
DATE

JOB NUMBER - 95039

NOTE: THIS IS NOT A CERTIFIED COPY UNLESS SEALED.

XE4-44

002-1471